

17 October 2017

**DEACON POINT SUBDIVISION STAGES 1 AND 2,
RIVERHEAD**

GEOTECHNICAL COMPLETION REPORT

CABRA PROPERTIES LIMITED

Ref: AKL2016_0326AF Rev: 0

Table of Contents

1. INTRODUCTION	1
2. PROJECT BACKGROUND	1
3. DESCRIPTION OF EARTHWORKS	1
4. GEOTECHNICAL QUALITY CONTROL	2
4.1. Site Observations	2
4.2. Compaction Control	3
5. EVALUATION OF COMPLETED EARTHWORKS	3
5.1. Natural Hazards	3
5.2. Land Stability and Erosion Control	3
5.3. Retaining Walls	4
5.4. Palisade Walls	4
5.5. Fill Induced Settlement	4
5.6. Service Line Trenches	4
5.7. Subsoil Drains	4
5.8. Road Subgrades	5
5.9. Design of Shallow Foundations	5
5.9.1. Bearing Capacity	5
5.9.2. Foundation Settlements	5
5.9.3. Soil Expansiveness Classification	5
5.10. Topsoil Depths	6
6. CLOSURE	6

Appendices

Appendix A – Statement of Professional Opinion as to the Suitability of Land For Building Development

Appendix B – Drawings

Appendix C – Laboratory Test Data

Appendix D – Field Test Data

Appendix E – Producer Statements

1. INTRODUCTION

In accordance with our instructions, this Geotechnical Completion Report has been prepared for Cabra Properties Ltd as part of the documentation to be submitted to Auckland Council following the earthworks to form Stages 1 and 2 of the Deacon Point Subdivision development. Construction of this residential subdivision has been undertaken in accordance with the Auckland Council Resource Consent number SLC-67504 and Engineering Approval letter for Earthworks, Retaining, Roading and Stormwater dated 25 November 2016 and Engineering Approval letter for Wastewater and Water Supply dated 23 January 2017. Specific structures constructed during the civil works to create these stages of the subdivision include timber pole retaining walls, a palisade wall (in-ground wall) and segmental block retaining walls.

This report contains our Suitability Statement, specific comments related to items raised in the Resource Consent, relevant test data and the Cato Bolam Consultants Limited as-built plan set as provided in Appendix B.

This report covers the construction period October 2016 to July 2017 and is intended to be used for certification purposes for new lots (listed below) created from Lot 1 DP 124412 as follows:

- 48 new residential lots numbered 1 to 34 and 52 to 65;
- 3 new roads named Riverhead Point Drive (Road 1), William Blake Way (Road 2) and Drovers Way (Road 3) respectively and an extension to existing Dinning Road.

Stages 1 and 2 of the Deacon Point Subdivision are located off Dinning Road in Riverhead. As can be seen from the as-built plans, 44 of the lots have been affected by filling as part of the earthworks operations to a maximum depth of approximately 7.5 metres.

2. PROJECT BACKGROUND

The geotechnical investigations and design for this development were undertaken by CMW Geosciences as presented in the following reports:

- CMW Geotechnical Investigation Report referenced AKL2016_0326AB Rev.2, dated 13 May 2016.
- CMW Palisade Wall Design Report referenced AKL2016_0326AC Rev 0, dated 01 July 2016.
- CMW Geotechnical Retaining Wall Design Report referenced AKL2016_0326AD Rev 1, dated 11 July 2016.
- CMW Design Parameters for Proposed Boardwalk referenced AKL2016_0326AE Rev 0, dated 27 April 2017.

3. DESCRIPTION OF EARTHWORKS

Heritage protection works began in October 2016 following the identification of archaeological remains in the southern portion of the site covering lots 8 and 9 intersecting road 2.

Site stripping had commenced in early October 2016 starting with topsoil stripping of the temporary silt pond at the northern end of the site and the significant excavation of large pines at the western site boundary.

Cut and fill began in October 2016 which included conditioning of natural borrow sources and stockpiled fill from the bulk earthworks making up the remaining portions of the site. These earthworks continued between October 2016 and May 2017, with the majority of the earthworks formed to finished levels by January 2017.

DCP testing of the prepared subgrades for roads not already sealed were undertaken by CMW to provide confirmation of pavement strength to Cabra Properties Limited. Road stabilisation works and the placement of base course metal commenced in February 2017 and continued to June 2017.

Civil construction works continued throughout early 2017 which included construction of kerb and channel, topsoiling works, footpaths, combined services trenches and lot connections. Retaining wall construction including timber post and segmental block gravity walls were undertaken between early January 2017 and June 2017 with final works for these walls including fencing and drainage outlet works undertaken in August and September 2017. Final asphalt placement on all unsealed roads was completed by early August for these stages.

The main items of plant used by the earthworks subcontractor, BHE Limited, included:

- 2 X D6 Bulldozers and Scoops
- 2 X Articulated Dump Trucks
- 1 X D6 Bulldozer
- 1 X Tractor and Discs
- 1 X 4T Front End Loader
- 2 X 5T Excavators
- 2 X 20T Excavators
- 1 X 13T Excavators
- 2 X Road Dump Trucks
- 1 X Water Cart
- 1 X 815 Compactor

4. GEOTECHNICAL QUALITY CONTROL

4.1. Site Observations

During the earthworks site visits were typically undertaken several times each week to assess compliance with NZS 4431 and specific design recommendations and specifications.

Site visits were carried out to observe and confirm compliance relating to:

- Adequate topsoil stripping;
- Fill areas prior to the placement of fill materials to ascertain that all mullock and soft inorganic subsoils had been removed;
- Installation of subsoil drains including counterfort drains and gully/underfill drains but excluding road under-channel drains;
- Backfilling of subsoil drains;
- Subsoil drain connections to outlets;
- Retaining wall pile excavations;
- Construction of cantilever pole retaining walls including ground conditions, pile size, spacing and depth;
- Construction of segmental block retaining walls including ground conditions and drainage placement;
- Construction of palisade wall including ground conditions, pile size, spacing and depth; and
- Placement and compaction of engineered fills.

4.2. Compaction Control

Compaction of engineered earth fills was controlled by undrained shear strength measured by hand held shear vane calibrated using the NZGS 2001 method and by air voids as defined by NZS4402.

The criteria for undrained shear strength were a minimum single value of 110 kPa and minimum average of any 10 consecutive tests of 140 kPa.

The criteria for air voids were a maximum single value of 12% and maximum average of any 10 consecutive tests of 10%.

These tests showed on some occasions that the required compaction standards were not being achieved and to the best of our knowledge the failing areas of fill were re-worked as necessary. Subsequent testing confirmed compliance with the specification.

5. EVALUATION OF COMPLETED EARTHWORKS

5.1. Natural Hazards

The appended as-built drawings depict the extents of a series of zones that contain limitations intended to ensure that future building and/ or earthworks on the lots is undertaken in a manner that does not lead to buildings being subject to any of the natural hazards described in section 106 of the Resource Management Act, i.e. erosion, falling debris, subsidence, slippage, and inundation. Consideration of the inundation hazard was outside the scope of CMW's brief and has been assessed by others. The applied zones include:

- **Specific Design Zones (retaining)** - intended to protect the retaining walls from overloading at the crest or undermining at the toe that could lead to instability;
- **Specific Design Zones (slope)** – intended to protect building development from long term creep effects on or adjacent to steep slopes and to protect the slopes from inappropriate loading or undermining.
- **Specific Investigation and Design Zone** – intended to prevent inappropriate building development on areas of land within residential lots which do not have suitable stability factors of safety in accordance with Auckland Council Code of Practice or which are immediately adjacent to the palisade (in-ground) wall that provides appropriate factors of safety to the building platform areas.

Full descriptions of the restrictions associated with each of these zones are presented in the Suitability Statement (Appendix A). Additional information is also provided in some of the following sections.

5.2. Land Stability and Erosion Control

On all steep land, surface stability can be compromised by indiscriminate disposal of stormwater onto the ground surface and/ or by removal of vegetation.

Building and landscape designers must ensure that all runoff from solid surfaces is directed into the stormwater system. It is also important that care is paid to the disposal of stormwater during construction so that concentrated discharges (e.g. from unconnected spouting) are not directed towards steep ground.

Wherever practical, existing vegetation and grass cover should be well maintained. Any vegetation cleared beyond the immediate area of building platforms for temporary construction purposes should be replanted or replaced as soon as possible. The roots of an established vegetation cover can serve to bind the surface soils while the foliage can reduce rain infiltration and soil saturation, resulting in better resistance to erosion and shallow slumping.

5.3. Retaining Walls

Cantilever pole and segmental block retaining walls have been constructed in the locations shown on the appended Final Contours and Retaining Walls As-built Plans. These walls reach a maximum height of approximately 1.7 metres and were designed by this consultancy and the construction was observed by this consultancy. Copies of the Producer Statements - Construction Review are provided in Appendix E.

Descriptions of the building and earthworks restrictions within the vicinity of these walls (Specific Design Zones – retaining) are contained in the Suitability Statement in Appendix A. Lots containing these zones include 1 to 7, 9, 10, 12 to 29 and 60 inclusive.

5.4. Palisade Walls

A palisade (in-ground) wall was constructed beneath lots 60 to 65 inclusive to protect building platform areas from potential regression of historic instability. This wall was constructed from 300mm H5 treated timber poles fully embedded into existing ground in 450mm diameter pile holes at 1.5m pile spacing (centre to centre). This wall was designed by the consultancy, presented in technical memorandum referenced AKL2016_0326AC Rev.0 dated 1 July 2016. The extents of this wall are depicted on the Final Contours and Retaining Walls As-built Plans. This consultancy observed construction of this palisade wall. A copy of the Producer Statement – Construction Review is provided in Appendix E.

5.5. Fill Induced Settlement

Based on our experience with fills within the geological setting, the works undertaken to prepare the gully areas for filling, including undercuts to rock and underfill drainage measures together with the elapsed time since the majority of the deeper fills were placed, we consider that the remaining post-construction settlements will be within code limits.

5.6. Service Line Trenches

As part of the civil works, stormwater services were trenched throughout the development as shown on the appended Stormwater Reticulation As-built Plans. Sanitary sewer services within this subdivision are based on Pressure Wastewater Collection (PWC) systems, which are installed in the common services trenches outside of the residential lots.

As is normal on all subdivisions, building developments involving foundations within a 45 degree zone of influence from pipe inverts will require engineering input. The Auckland Council drawing referenced SW22 provided in Appendix B extracted from Chapter 4 of the Auckland Council Code of Practice for Land development and Subdivision depicts their requirements for stormwater pipes. Lots 1, 3, 4, 6 to 9, 17, 18, 20, 22, 23, 25, 26, 28 to 33, 52 and 54 to 64 inclusive are known to have service trenches within the lots as shown on the appended Stormwater Reticulation As-built Plans. The resulting restrictions are presented in the Suitability Statement below.

5.7. Subsoil Drains

The appended Cut Fill As-built Plans shows the positions of subsoil drains which were constructed in the natural ground during the earthworks operations. The drains were installed to help control groundwater levels and are extended to formed outlets within the coastal margins of the subdivision. The ongoing operation of these drains is important to the overall stability conditions of the site.

Typical depths for these drains are depicted on the as-built plans and are generally over 2.5m below finished ground levels. Accordingly, they are predominantly beyond the depths of anticipated foundations.

Descriptions of the restrictions are contained in the appended Suitability Statement.

5.8. Road Subgrades

Penetration resistance testing was carried out on the road subgrades during construction and the results of this testing were forwarded to Cato Bolam Consultants Limited for pavement remedial design. Where soft ground with low equivalent CBR values was identified it was generally undercut and replaced with engineered fill. These undercut areas are depicted on the appended Road As-built Plans. All road subgrade areas were subsequently lime/ cement stabilised to achieve appropriate CBR values.

Benkelman Beam testing of the base course was carried out by Road Test Limited on each road and those results were also forwarded to Cato Bolam Consultants.

5.9. Design of Shallow Foundations

5.9.1. Bearing Capacity

Once bulk earthworks and top-soiling of the building platforms had been completed, our staff drilled hand auger boreholes on platforms in natural ground to determine representative finished ground conditions and hence evaluate likely foundation options for future building development. Our assessments of bearing capacity for the design of shallow foundations on each building platform are contained in the appended Suitability Statement.

At current subgrade levels all lots have been assessed as having a geotechnical ultimate bearing capacity of 300 kPa within the influence of conventional shallow residential building foundation loads.

If higher geotechnical ultimate bearing capacities are required, further specific site investigation and design of foundations should be carried out prior to Building Consent application.

5.9.2. Foundation Settlements

At the bearing pressures specified above and subject to the design requirements for soil expansiveness provided below, differential settlement of shallow foundations for buildings designed in accordance with NZS 3604 (including the 600mm subfloor fill depth limit) should be within code limits.

5.9.3. Soil Expansiveness Classification

Four sets of soil tests were carried out on samples taken from likely foundation level on lots within these stages of the development.

Testing was carried out in accordance with NZS 4402, "Methods of Testing Soils for Civil Engineering Purposes" test 2.2 and 2.6 and were used in conjunction with visual-tactile assessment of the site soils to determine expansive site Classes as defined in AS 2870, "Residential Slabs and Footings – Construction". All test results are appended.

On this basis we have assessed the AS 2870 Site Class for all lots these stages of the development to be M (moderate). Details of foundation options for this Class are contained in the appended Suitability Statement.

In recent years in Auckland, there have been examples of concrete floors and/ or foundations that have been poured on dry, desiccated subgrades in summer months on expansive soils and have undergone heaving and cracking once the soil moisture contents have returned to higher levels. Foundation contractors need to be made aware of this issue and the need to maintain appropriate moisture contents in the footings and building platform subgrade between the time of excavation and the pouring of concrete.

Remedial actions that may be appropriate include platform protection with a hard fill layer, pouring of a blinding layer of concrete in footing bases and soaking of the building platform with sprinklers for an extended period.

Home owners need to be aware that the planting of high water demand plants where their roots may extend close to footings can also cause settlement damage.

5.10. Topsoil Depths

Topsoil depths have been checked by the drilling of a borehole in the approximate centre of the building platform on each lot. The results are considered indicative for each lot, but may be subject to variations. Topsoil depths are between 50 and 300mm on these stages of the development.

Site specific findings are contained in the appended Suitability Statement Summary (Appendix A). However, it is possible that further levelling works have been undertaken since our investigations and accordingly, we strongly recommend that lot purchasers complete their own checks of topsoil depths.

6. CLOSURE

The appended Statement of Professional Opinion is provided to the Auckland Council and Cabra Properties Limited for their purposes alone on the express condition that it will not be relied upon by any other person. It is important that prospective purchasers satisfy themselves as to any specific conditions pertaining to their particular land interest.

Although regular site visits have been undertaken for observation, for providing guidance and instruction and for testing purposes, the geotechnical services scope did not include full time site presence. To this end, our appended Suitability Statement also relies on the Contractors' work practices and assumes that when we have not been present to observe the work, it has been completed to high standards and in accordance with the drawings, instructions and consent conditions provided to them.

Similarly it assumes that all as-built information and other details provided to the Client and/or CMW by other members of the project team are accurate and correct in all respects.

**For and on behalf of
CMW Geosciences**

Prepared by:



Greg Snook

Senior Engineering Geologist

Reviewed and Approved by:



Richard Knowles

Principal Geotechnical Engineer, CPEng

Appendix A

Statement of Professional Opinion as to the Suitability of Land for Building Development

STATEMENT OF PROFESSIONAL OPINION AS TO THE SUITABILITY OF LAND FOR BUILDING DEVELOPMENT

I, R.J. Knowles, of CMW Geosciences, Auckland, hereby confirm that:

1. As a Chartered Professional Engineer experienced in the field of geotechnical engineering, I am a Geo-professional as defined in section 1.2.2 of NZS 4404 and was retained by the Developer as the Geotechnical Engineer on Stages 1 and 2 of the Deacon Point Development.
2. The extent of preliminary investigations carried out to date are described in the Geotechnical Investigation Report referenced AKL2016_0326AB Rev.2, dated 13 May 2016 prepared by this consultancy. The conclusions and recommendations of those documents have been re-evaluated in the preparation of this report. The results of all tests carried out are also appended.
3. In my professional opinion, not to be construed as a guarantee, I consider that:
 - (a) The earth fills shown on the appended Cut Fill As-built Plan have been placed in compliance with NZS 4431, the Auckland Council District Plans (Rodney Section) and related documents.
 - (b) The completed earthworks give due regard to land slope and foundation stability considerations on the building platform areas, but as shown on the appended Specific Design Zone Restriction plans, areas on all lots have gradients steeper than 1(v) in 4 (h) or are adjacent to land having such gradients. Accordingly, restrictions incorporating Specific Design Zones (Slope) have been applied on Lots 1, 3 to 7, 10 to 12 and 55 to 59 inclusive as depicted on the Specific Design Restriction Zone plans.

No building construction and no earthworks (i.e. cut or fills of any depth) should take place within the designated **Specific Design Zone (Slope) areas** unless endorsed by a Chartered Professional Engineer experienced in geomechanics and familiar with the contents of this report. The endorsement will need to consider the implications of the proposals on both global stability conditions and soil creep on the building buildings, the interaction with service pipes and associated trench backfills, control of surface water, construction sequencing, timing and temporary support requirements construction of all earthworks, foundations and retaining walls and if necessary, comment on what aspects require engineering inspections and certification.

This limitation also applies to long term landscaping works, including any proposed minor cuts either on or near batter toes to be retained by new landscaping walls that might not normally require engineering, and to landscaping fills on or immediately above the batter slopes.

- (c) **Specific Investigation and Design Zone** areas defined on Lots 60 to 65 inclusive have been applied to the seaward side of the palisade (in-ground) wall and within 2 metres of this wall. The wall has been designed to protect the upslope areas from potential long term regression of instability in the coastal margin.

No building construction and no earthworks may take place in these areas unless further specific investigations and design of all future earthworks, geotechnical remediation and foundation design is endorsed by a Chartered Professional Engineer experienced in geomechanics and familiar with the contents of this report, the previous investigation reports and the existing ground remediation works (palisade wall) constructed within these lots.

The endorsement will need to consider the implications of the proposals on the global stability conditions, soil creep effects onto building areas and assessment of vacation potential downslope of existing or proposed remediation works, impact on the existing palisade wall, control of surface water, construction sequencing, timing and temporary support, specifications and requirements for remedial works and for earthworks, construction and foundation works and if necessary document required inspection and certification of such works.

- (d) **Specific Design Zone (Retaining)** have been applied on Lots 1 to 7, 9, 10, 12 to 29 and 60 inclusive for the protection of the function of the retaining walls. No building construction and no earthworks (i.e. cut or fills of any depth) should take place within the designated **Specific Design Zone (Retaining) areas** unless endorsed by a Chartered Professional Engineer experienced in geomechanics and familiar with the contents of this report. The endorsement will need to consider the stability implications of the earthworks and building proposals on the retaining walls.
- (e) The function of the subsoil drains installed beneath Lots 1, 3, 8 to 11, 19 to 23, 59 and 60 inclusive must not be impaired by any building development or landscaping works. Any bored or driven piles must be positioned to avoid damaging the draincoils. Where any subsoil drain is intercepted by building works, it must be reinstated under the direction of a Chartered Professional Engineer to ensure the integrity of the subsoil drainage system.
- (f) A geotechnical ultimate bearing capacity of 300 kPa may be assumed for shallow foundation design on the building platforms of all Lots.

If for any reason higher geotechnical bearing capacities are required, further specific site investigation and design of foundations should be carried out prior to Building Consent application.

- (g) The expansive site Class for all lots has been assessed as AS2870 Class M (Moderate). We recommend that building designers note on the Building Consent drawings the need to maintain appropriate moisture levels across building subgrades and in footing excavations (as described in Section 5.9.3 of the Geotechnical Completion Report) for reference by foundation contractors.
- (h) The backfilling and compaction of the storm water and sanitary sewer trenches on this subdivision has been carried out to appropriate standards having regard for the prevailing ground conditions and associated compaction induced pipe loadings.

However, no building development should take place within the 45 degree zone of influence of drain inverts unless endorsed by specific design and by construction inspections undertaken by a Chartered Professional Engineer experienced in geomechanics to ensure that lateral stability and differential settlement issues are addressed and that building loads are transferred beyond the influence of the pipe and trench backfill. A copy of drawing SW22 extracted from Chapter 4 of the Auckland Council Code of Practice for Land development and Subdivision this document is provided in Appendix B for clarification. Lots 1, 3, 4, 6 to 9, 17, 18, 20, 22, 23, 25, 26, 28 to 33, 52 and 54 to 64 are affected by these service lines.

- (i) Subject to the geotechnical limitations, restrictions and recommendations contained in clauses 3(b), 3(c), 3(d), 3(e) 3(f), 3(g) and 3(h) above:

- (i) The filled and natural ground is generally suitable for residential buildings constructed in accordance with NZS 3604 and the requirements of AS2870 for the appropriate expansive soil class.
 - (ii) Where shallow foundations are appropriate, design may be carried out in accordance with AS 2870 (Class M) or alternately, a specific foundation and structural design may be undertaken by a Chartered Professional Engineer.
4. Road subgrades have been formed with appropriate regard for slope stability and settlement risks.

The following table summarises the conditions on each of each residential lots.

For and on behalf of CMW Geosciences



Richard Knowles

Principal Geotechnical Engineer, CPEng

GCR Summary Table

Condition	Specific Design Zone (slope)	Specific Investigation and Design Zone	Specific Design Zone (retaining)	Subsoil Drains Present	Geotechnical Ultimate Bearing Capacity (kPa)	AS2870 Expansive Class	Service Lines Restrictions	Indicative Topsoil Depth (mm)
GCR SOPO Clause	3(b)	3(c)	3(d)	3(e)	3(f)	3(g)	3(h)	
Lot number								
1	●		●	●	300	M	●	300
2			●		300	M		250
3	●		●	●	300	M	●	200
4	●		●		300	M	●	200
5	●		●		300	M		200
6	●		●		300	M	●	200
7	●		●		300	M	●	200
8				●	300	M	●	200
9			●	●	300	M	●	250
10	●		●	●	300	M		250
11	●			●	300	M		300
12	●		●		300	M		300
13			●		300	M		250
14			●		300	M		250
15			●		300	M		200
16			●		300	M		350
17			●		300	M	●	200
18			●		300	M	●	300
19			●	●	300	M		200
20			●	●	300	M	●	200

Condition	Specific Design Zone (slope)	Specific Investigation and Design Zone	Specific Design Zone (retaining)	Subsoil Drains Present	Geotechnical Ultimate Bearing Capacity (kPa)	AS2870 Expansive Class	Service Lines Restrictions	Indicative Topsoil Depth (mm)
GCR SOPO Clause	3(b)	3(c)	3(d)	3(e)	3(f)	3(g)	3(h)	
Lot number								
21			●	●	300	M		250
22			●	●	300	M	●	200
23			●	●	300	M	●	250
24			●		300	M		300
25			●		300	M	●	200
26			●		300	M	●	250
27			●		300	M		100
28			●		300	M	●	200
29			●		300	M	●	200
30					300	M	●	150
31					300	M	●	200
32					300	M	●	200
33					300	M	●	300
34					300	M		200
52					300	M	●	300
53					300	M		250
54					300	M	●	250
55	●				300	M	●	300
56	●				300	M	●	300
57	●				300	M	●	200
58	●				300	M	●	300

Condition	Specific Design Zone (slope)	Specific Investigation and Design Zone	Specific Design Zone (retaining)	Subsoil Drains Present	Geotechnical Ultimate Bearing Capacity (kPa)	AS2870 Expansive Class	Service Lines Restrictions	Indicative Topsoil Depth (mm)
GCR SOPO Clause	3(b)	3(c)	3(d)	3(e)	3(f)	3(g)	3(h)	
Lot number								
59	●		●	●	300	M	●	200
60		●	●	●	300	M	●	250
61		●			300	M	●	300
62		●			300	M	●	250
63		●			300	M	●	300
64		●			300	M	●	300
65		●			300	M	●	300

Appendix B

Drawings

Title	Reference No.	Date
Cover Sheet	34147 Sheet E000	10 September 2017
Final Contours and Retaining Walls As-Built Plans (6 Sheets)	34147 Sheets E600 to E605	10 September 2017
Cut Fill As-Built Plans (3 Sheets)	34147 Sheets E606 to E608	10 September 2017
Roading As-Built Plans (4 Sheets)	34147 Sheets E609 to E612	10 September 2017
Wastewater Reticulation As-Built Plans (5 Sheets)	34147 Sheets E613 to E617	10 September 2017
Stormwater Reticulation As-Built Plans (6 Sheets)	34147 Sheets E618 to E623	10 September 2017
Water Reticulation As-Built Plans (3 Sheets)	34147 Sheets E624 to E626	10 September 2017
Esplanade Planting As-Built Plans (3 Sheets)	34147 Sheets E627 to E629	10 September 2017
Retaining Wall Specific Design Zone Plans (3 Sheets)	34147 Sheets E631 to E633	10 September 2017
Specific Design Zone Restriction Plan	34147 Sheet E634	10 September 2017
Auckland Council Stormwater Pipe and Manhole Construction Clearance Requirements	SW22	30 September 2013

Cabra Developments Ltd


Decon Point

Stages 1 & 2

Dinning Road, Riverhead

AS BUILT PLAN SET - 34147 Stages 1 & 2

E000	COVER SHEET	
E600	Final Contours & Retaining Walls - Sheet 1 of 6	E630
E601	Final Contours & Retaining Walls - Sheet 2 of 6	E631
E602	Final Contours & Retaining Walls - Sheet 3 of 6	E632
E603	Final Contours & Retaining Walls - Sheet 4 of 6	E633
E604	Final Contours & Retaining Walls - Sheet 5 of 6	
E605	Final Contours & Retaining Walls - Sheet 6 of 6	E634
E606	Cut Fill - Sheet 1 of 3	
E607	Cut Fill - Sheet 2 of 3	
E608	Cut Fill - Sheet 3 of 3	
E609	Roading - Sheet 1 of 4	
E610	Roading - Sheet 2 of 4	
E611	Roading - Sheet 3 of 4	
E612	Roading - Sheet 4 of 4	
E613	Wastewater Reticulation - Sheet 1 of 5	
E614	Wastewater Reticulation - Sheet 2 of 5	
E615	Wastewater Reticulation - Sheet 3 of 5	
E616	Wastewater Reticulation - Sheet 4 of 5	
E617	Wastewater Reticulation - Sheet 5 of 5	
E618	Stormwater Reticulation - Sheet 1 of 6	
E619	Stormwater Reticulation - Sheet 2 of 6	
E620	Stormwater Reticulation - Sheet 3 of 6	
E621	Stormwater Reticulation - Sheet 4 of 6	
E622	Stormwater Reticulation - Sheet 5 of 6	
E623	Stormwater Reticulation - Sheet 6 of 6	
E624	Water Reticulation - Sheet 1 of 3	
E625	Water Reticulation - Sheet 2 of 3	
E626	Water Reticulation - Sheet 3 of 3	
E627	Esplanade Planting - Sheet 1 of 3	
E628	Esplanade Planting - Sheet 2 of 3	
E629	Esplanade Planting - Sheet 3 of 3	

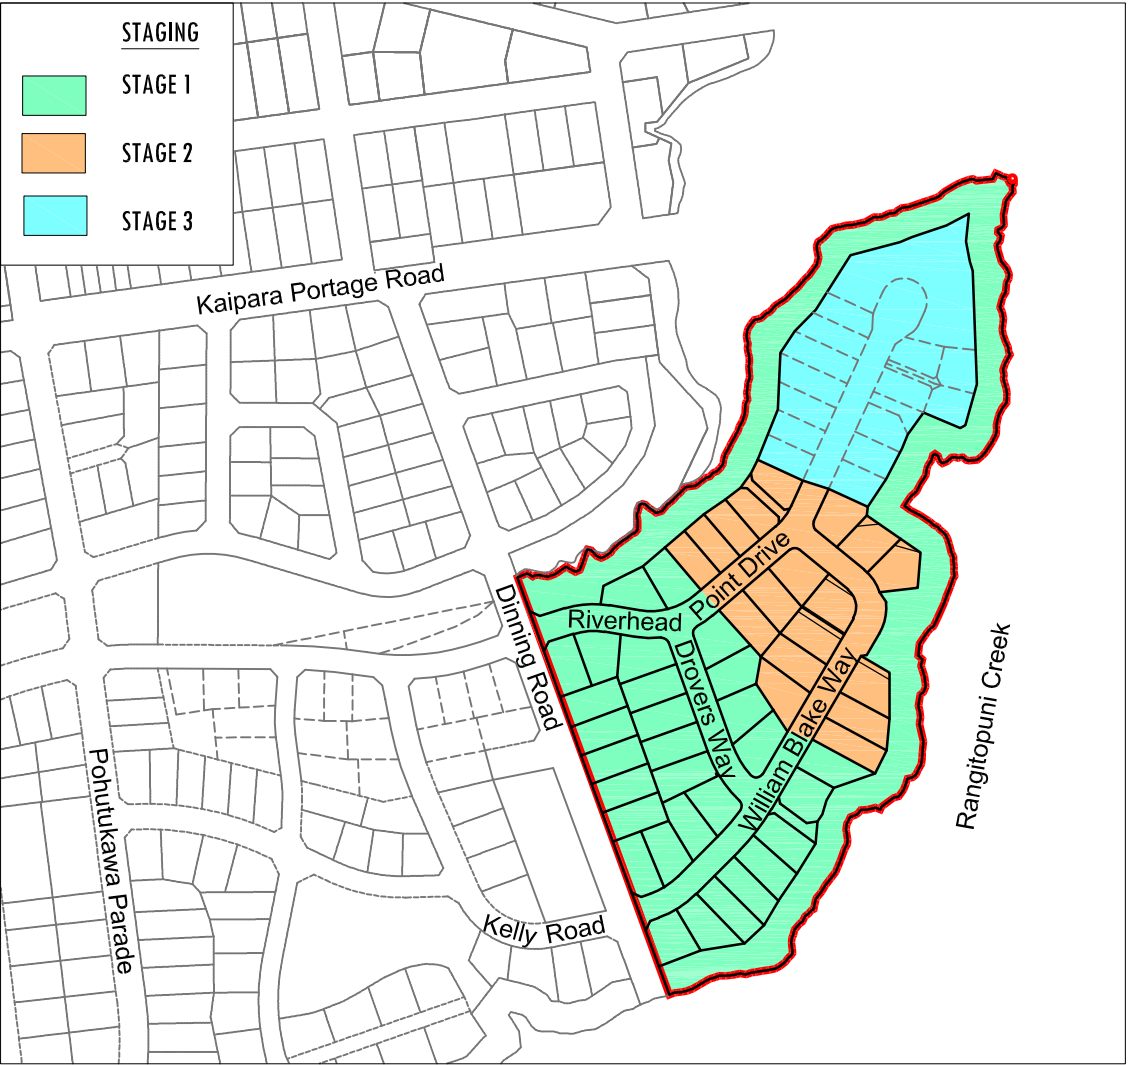

LOCATION DIAGRAM
Scale 1:5,000

As Built Plans - September 2017

R67504
ENG60065935

CATO BOLAM
CONSULTANTS

SURVEYORS

PLANNERS

ENGINEERS

CATO BOLAM CONSULTANTS LTD
19 Tamariki Avenue
PO Box 157
Drewna 0946

phone 09-427 0072
fax 09-426 7331
email catobolam@catobolam.co.nz

I certify that these As-built Plans are an accurate record of the works undertaken and that:
The Coordinates (X,Y) are in terms of NZTM on NZGD(2000), and are within ± 50mm.
The Levels (Z) are in terms of the Auckland 1946 (MSL) LINZ datum (DOSLI datum), and are within ± 25mm.


Signed:
Licensed Cadastral Surveyor

Date: 15/12/17

Name: Michelle Bain

Phone: 09 427 0072

Email: catobolam@catobolam.co.nz

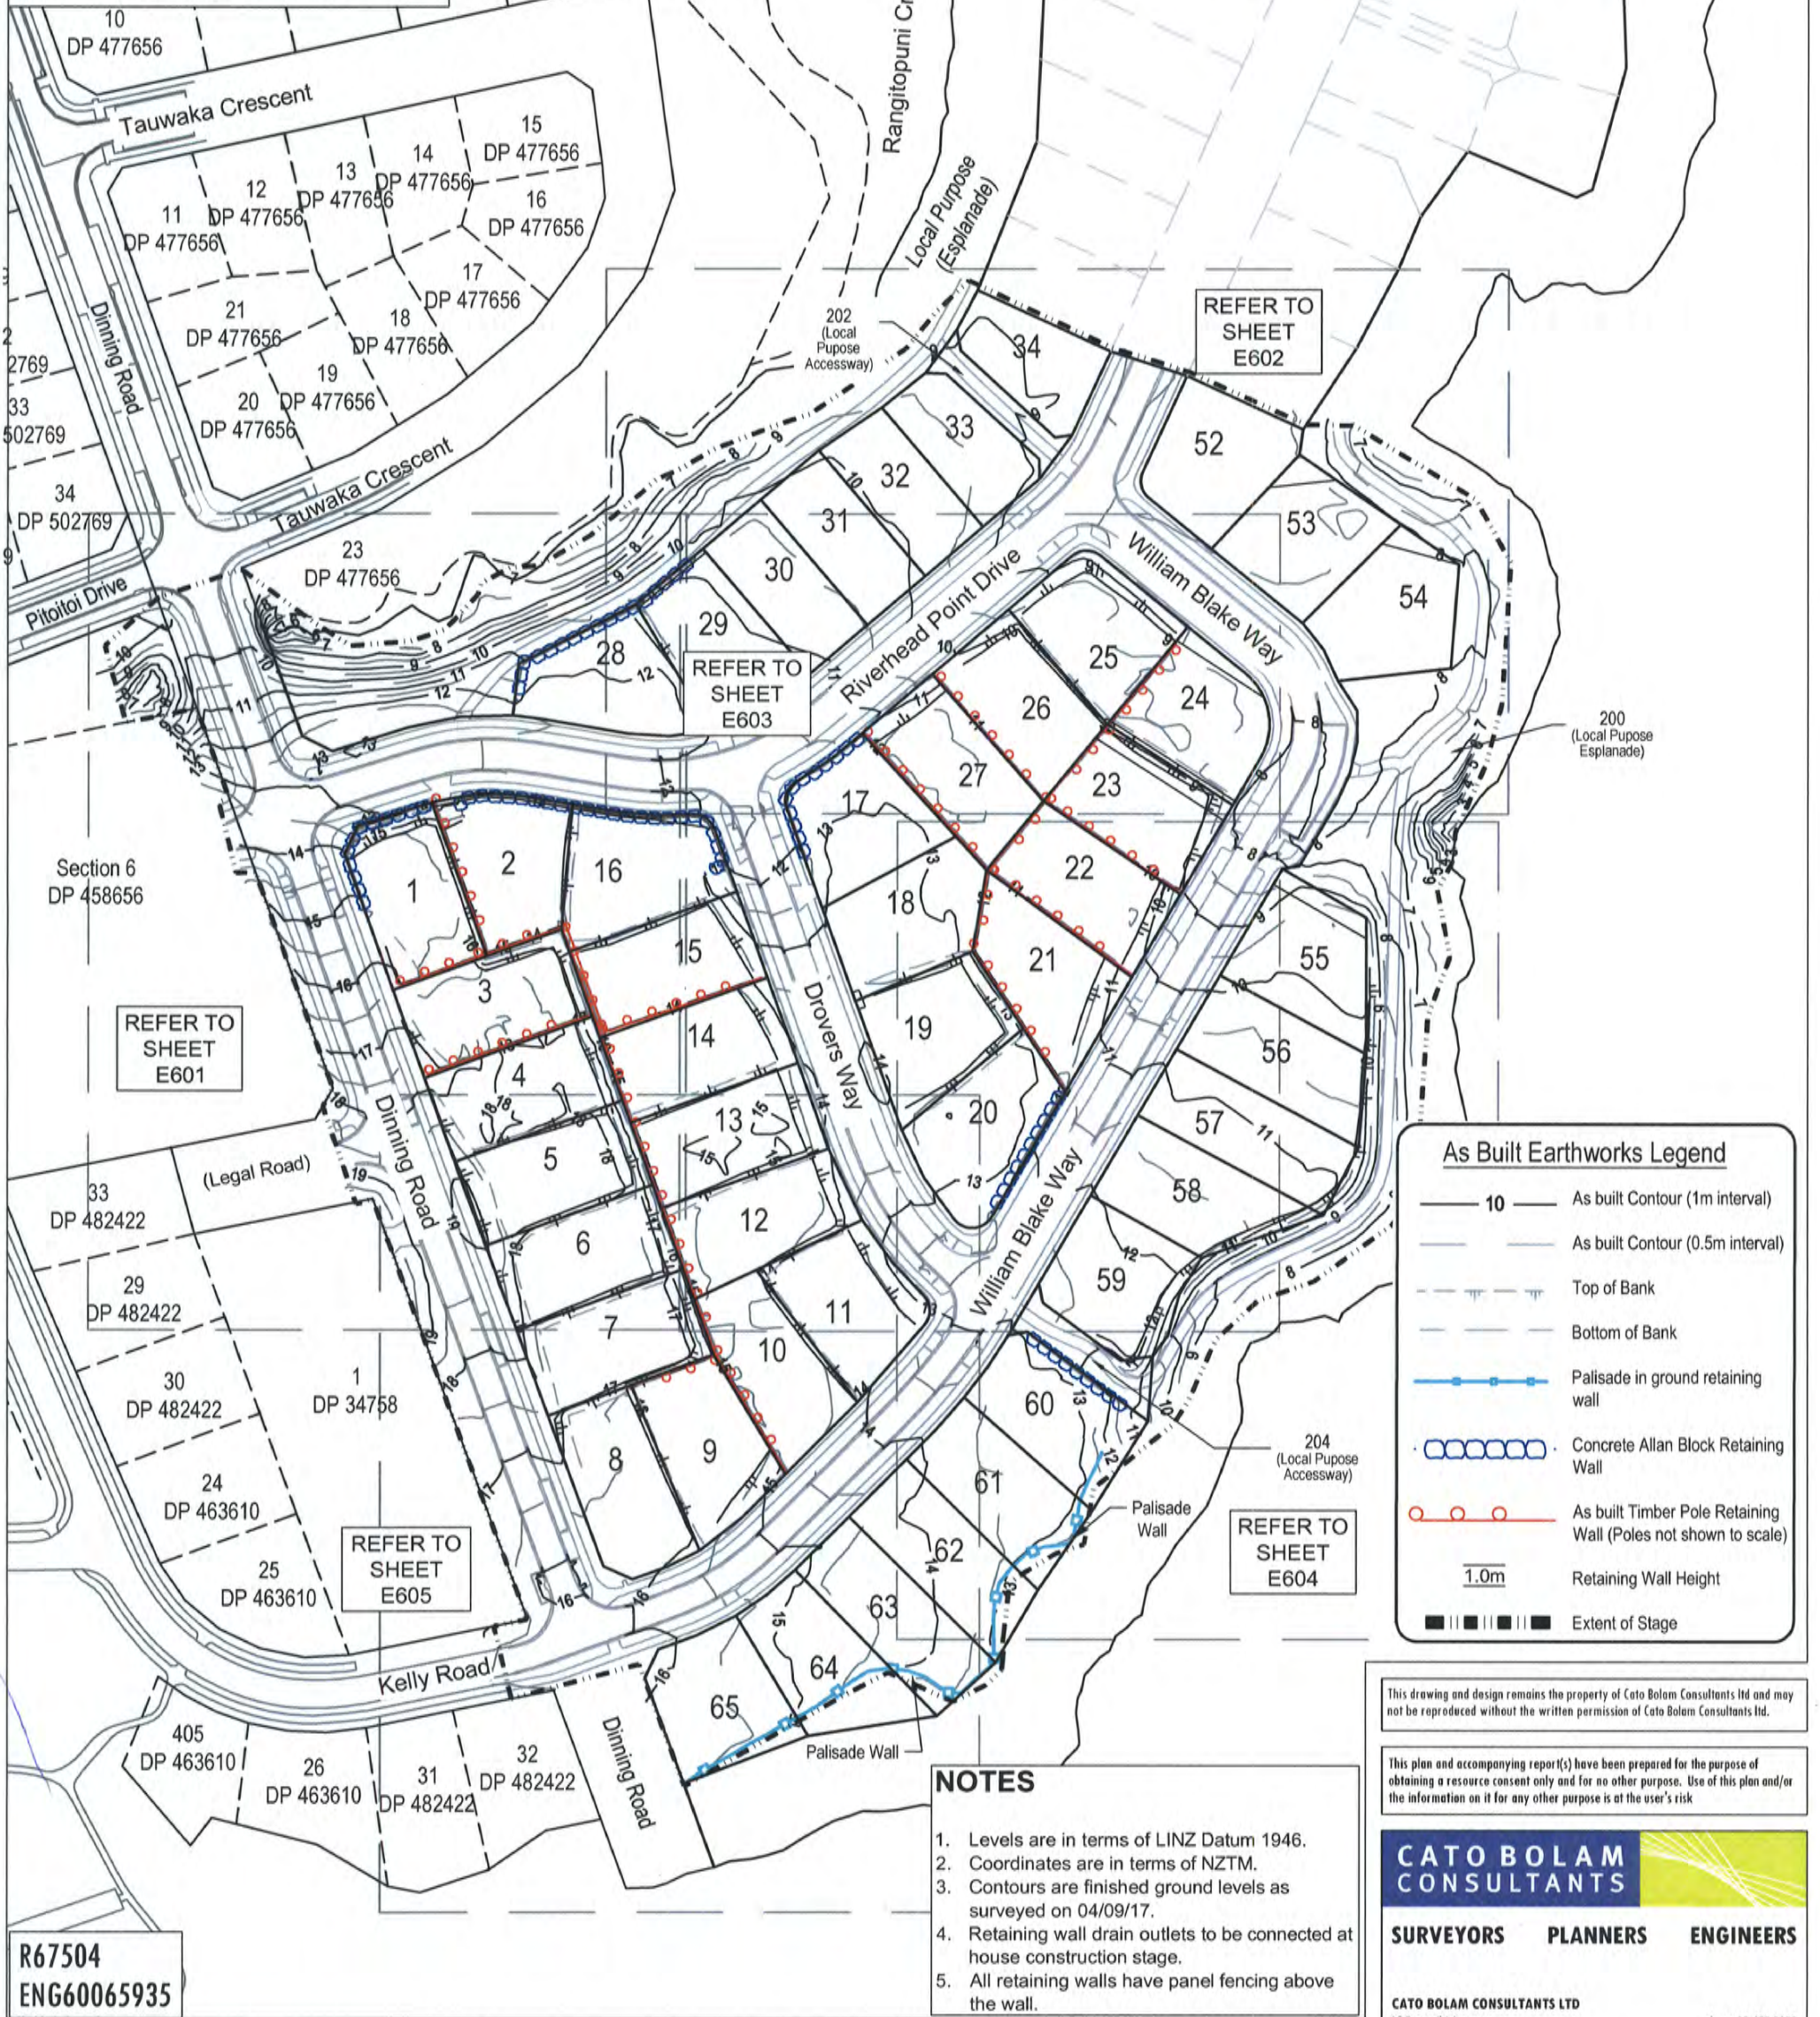

R67504
ENG60065935

NOTES

1. Levels are in terms of LINZ Datum 1946.
2. Coordinates are in terms of NZTM.
3. Contours are finished ground levels as surveyed on 04/09/17.
4. Retaining wall drain outlets to be connected at house construction stage.
5. All retaining walls have panel fencing above the wall.

This drawing and design remains the property of Cato Bolam Consultants Ltd and may not be reproduced without the written permission of Cato Bolam Consultants Ltd.

This plan and accompanying report(s) have been prepared for the purpose of obtaining a resource consent only and for no other purpose. Use of this plan and/or the information on it for any other purpose is at the user's risk.

CATO BOLAM CONSULTANTS

SURVEYORS PLANNERS ENGINEERS

CATO BOLAM CONSULTANTS LTD
19 Tamoriki Avenue
PO Box 157
Orewa 0946


phone 09-427 0072
fax 09-426 7331
email catobolam@catobolam.co.nz

ORIGINAL SCALE 1:1500	ORIGINAL SIZE A3	REVISION NO
DATE 10/09/17	CAD REFERENCE 34147 E600-E605	SHEET NO E600
DIRECTORY Z:\34147\ACAD\ASBUILTS		JOB NO 34147

REVISION (DESCRIPTIONS)	NAME	DATE
SURVEYED	LD	09/17
DESIGNED	AA	09/17
DRAWN	BJ	09/17
CHECKED	TL	09/17
APPROVED		

CLIENT
Cabra Developments Ltd Deacon Point Stages 1 & 2 Dinning Road, Riverhead

DRAWING TITLE
Final Contours & Retaining Walls As Built Plan Sheet 1 of 6

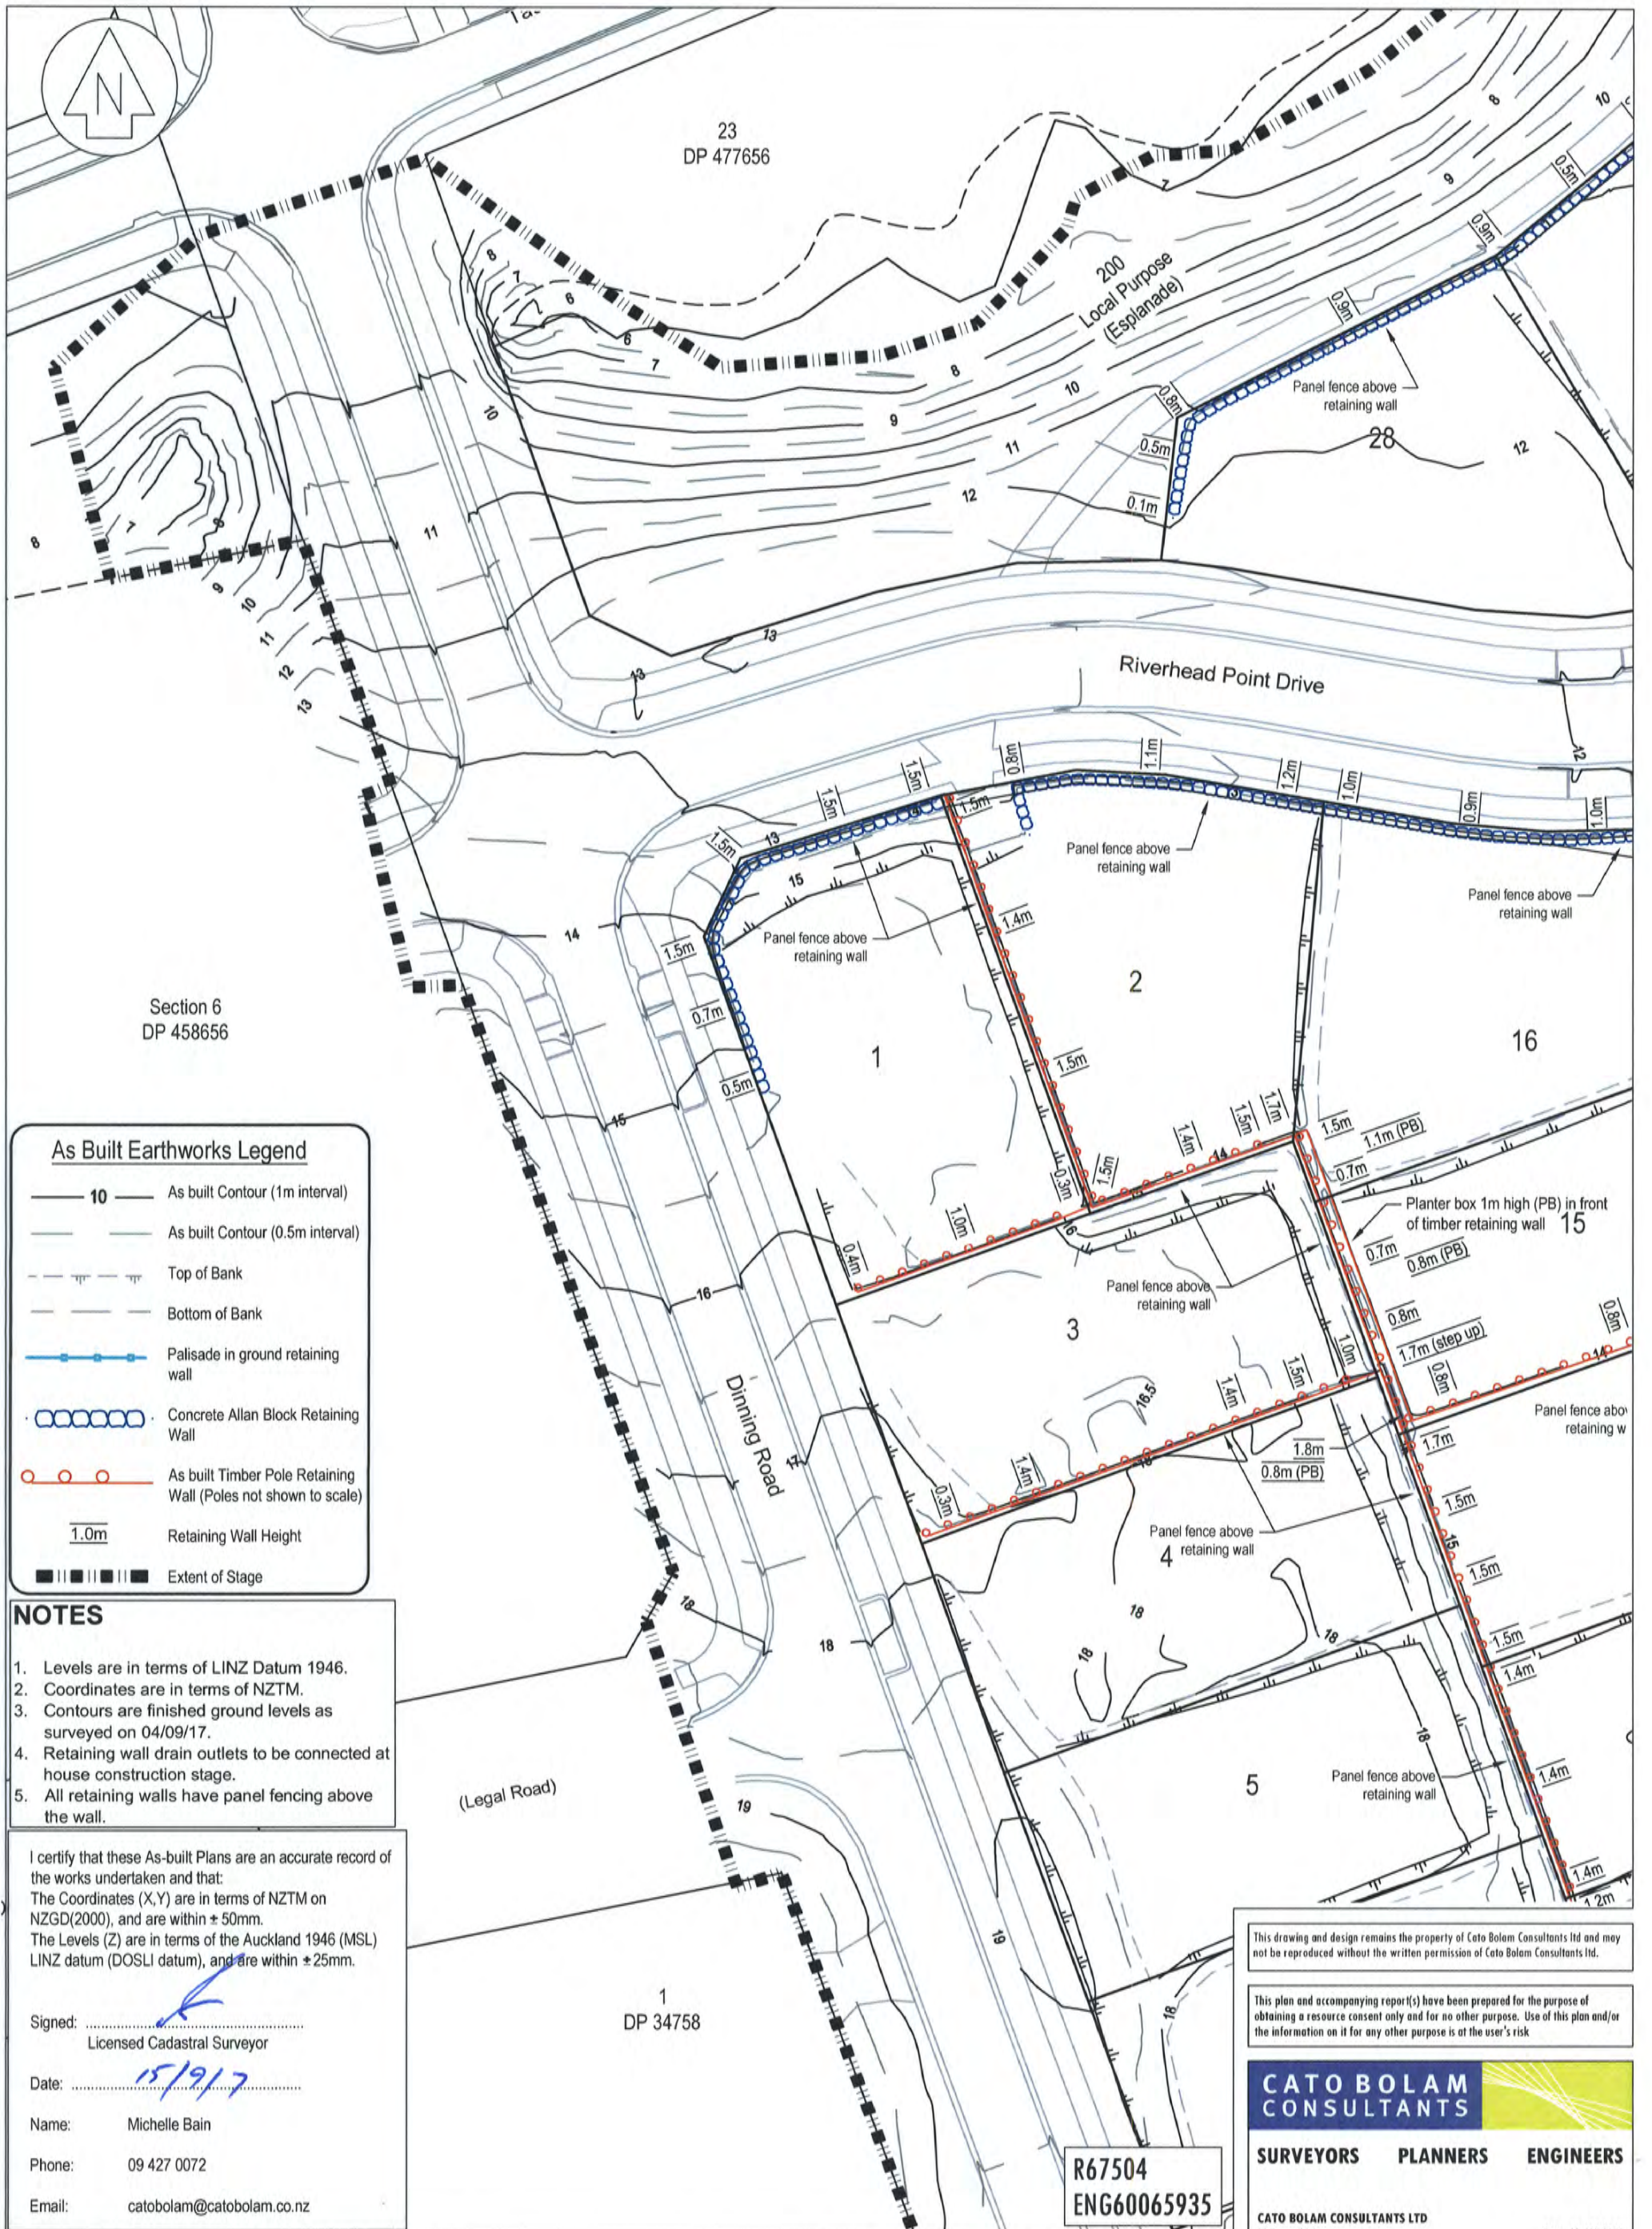

Section 6
DP 458656

23
DP 477656

1
DP 34758

R67504
ENG60065935

As Built Earthworks Legend

- 10 As built Contour (1m interval)
- As built Contour (0.5m interval)
- Top of Bank
- Bottom of Bank
- Palisade in ground retaining wall
- Concrete Allan Block Retaining Wall
- As built Timber Pole Retaining Wall (Poles not shown to scale)
- 1.0m Retaining Wall Height
- Extent of Stage

NOTES

- Levels are in terms of LINZ Datum 1946.
- Coordinates are in terms of NZTM.
- Contours are finished ground levels as surveyed on 04/09/17.
- Retaining wall drain outlets to be connected at house construction stage.
- All retaining walls have panel fencing above the wall.

I certify that these As-built Plans are an accurate record of the works undertaken and that:
The Coordinates (X,Y) are in terms of NZTM on NZGD(2000), and are within $\pm 50\text{mm}$.
The Levels (Z) are in terms of the Auckland 1946 (MSL) LINZ datum (DOSLI datum), and are within $\pm 25\text{mm}$.

Signed:
Licensed Cadastral Surveyor

Date: 15/9/17

Name: Michelle Bain

Phone: 09 427 0072

Email: catobolam@catobolam.co.nz

This drawing and design remains the property of Cato Bolam Consultants Ltd and may not be reproduced without the written permission of Cato Bolam Consultants Ltd.

This plan and accompanying report(s) have been prepared for the purpose of obtaining a resource consent only and for no other purpose. Use of this plan and/or the information on it for any other purpose is at the user's risk.

CATO BOLAM CONSULTANTS

SURVEYORS PLANNERS ENGINEERS

CATO BOLAM CONSULTANTS LTD
19 Tamariki Avenue
PO Box 157
Drewa 0946

phone 09-427 0072
fax 09-426 7331
email catobolam@catobolam.co.nz

REVISION (DESCRIPTIONS)	NAME	DATE
SURVEYED	LD	09/17
DESIGNED		
DRAWN	AA	09/17
CHECKED	BJ	09/17
APPROVED	TL	09/17

CLIENT
Cabra Developments Ltd Deacon Point Stages 1 & 2 Dinning Road, Riverhead

DRAWING TITLE
Final Contours & Retaining Walls As Built Plan Sheet 2 of 6

ORIGINAL SCALE 1:500	ORIGINAL SIZE A3	REVISION NO
DATE 10/09/17	CAD REFERENCE 34147 E600-E605	SHEET NO E601
DIRECTORY Z:\34147\ACAD\ASBUILTS		JOB NO 34147

I certify that these As-built Plans are an accurate record of the works undertaken and that:
The Coordinates (X,Y) are in terms of NZTM on NZGD(2000), and are within ± 50mm.
The Levels (Z) are in terms of the Auckland 1946 (MSL) LINZ datum (DOSLI datum), and are within ± 25mm.

Signed:
Licensed Cadastral Surveyor

Date: 15/09/17

Name: Michelle Bain

Phone: 09 427 0072

Email: catobolam@catobolam.co.nz




NOTES

1. Levels are in terms of LINZ Datum 1946.
2. Coordinates are in terms of NZTM.
3. Contours are finished ground levels as surveyed on 04/09/17.
4. Retaining wall drain outlets to be connected at house construction stage.
5. All retaining walls have panel fencing above the wall.

As Built Earthworks Legend

- 10 As built Contour (1m interval)
- As built Contour (0.5m interval)
- Top of Bank
- Bottom of Bank
- Palisade in ground retaining wall
- Concrete Allan Block Retaining Wall
- As built Timber Pole Retaining Wall (Poles not shown to scale)
- 1.0m Retaining Wall Height
- Extent of Stage

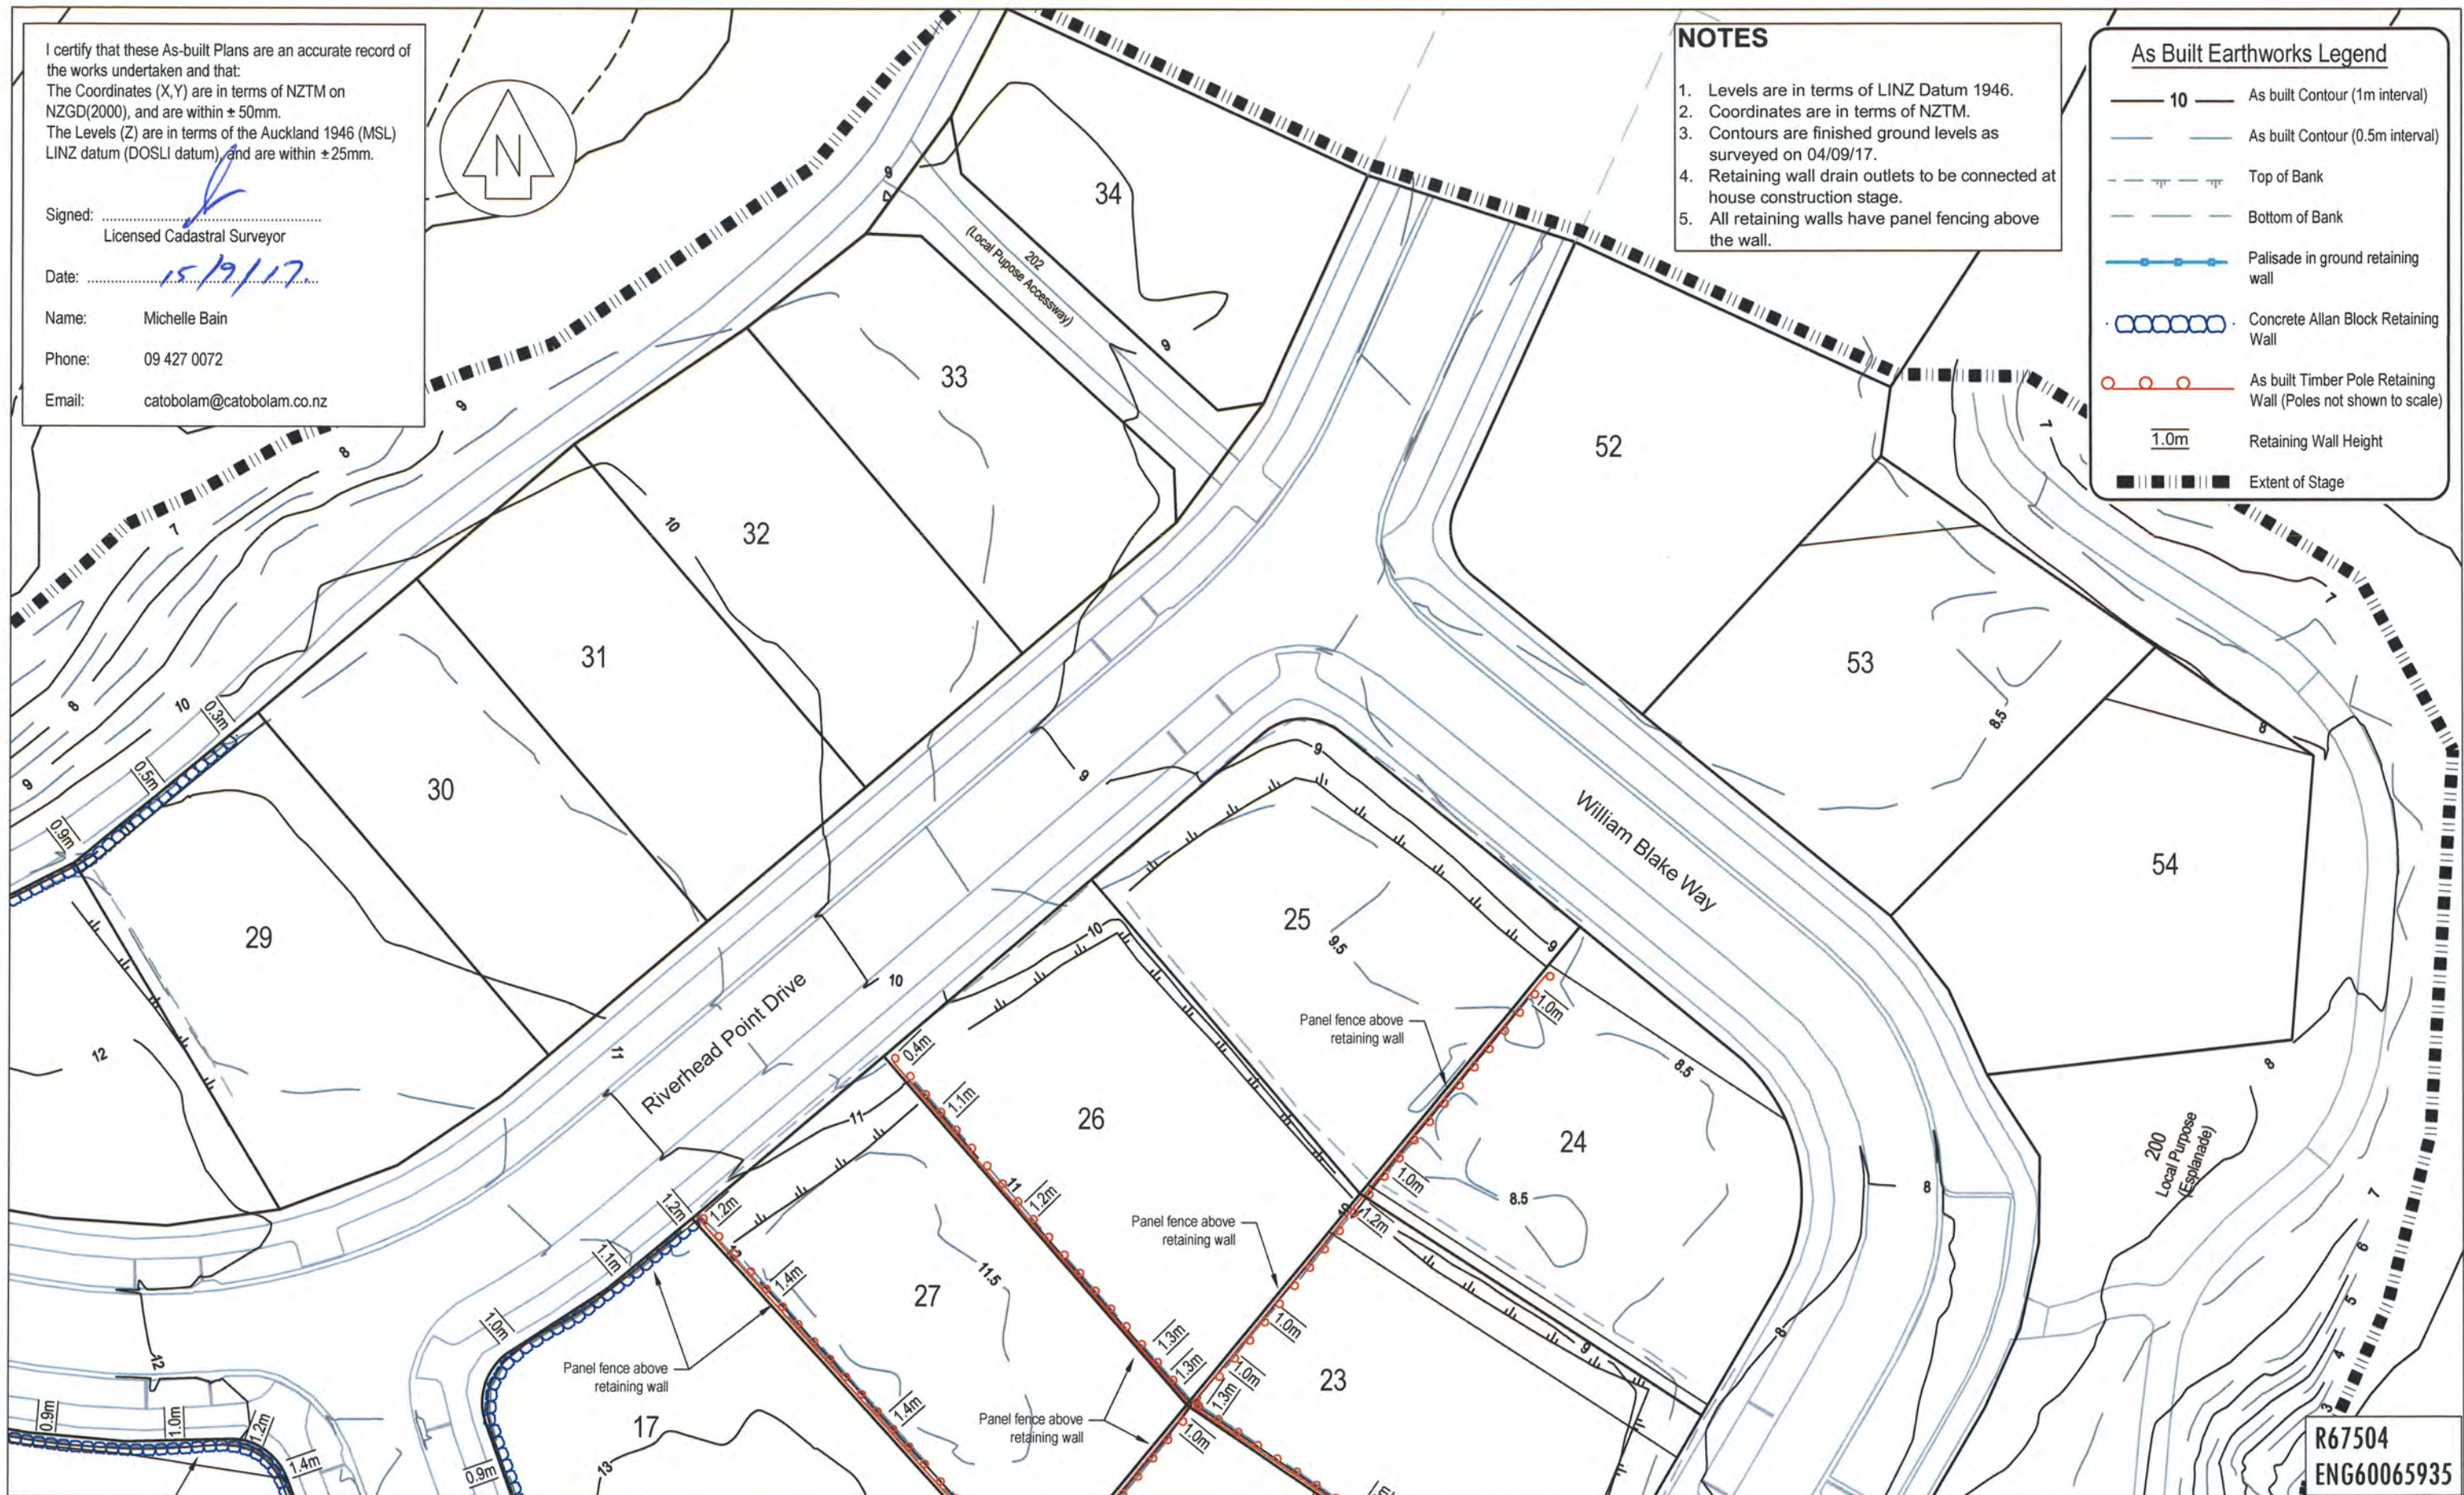

R67504
ENG60065935

**CATO BOLAM
CONSULTANTS**

SURVEYORS PLANNERS ENGINEERS

CATO BOLAM CONSULTANTS LTD
19 Tamariki Avenue
PO Box 157
Orewa 0946
phone 09-427 0072
fax 09-426 7331
email catobolam@catobolam.co.nz

REVISION (DESCRIPTIONS)	NAME	DATE
SURVEYED	LD	08/17
DESIGNED	AA	09/17
DRAWN	BJ	09/17
CHECKED	TL	09/17
APPROVED		

This plan and accompanying report(s) have been prepared for the purpose of obtaining a resource consent only and for no other purpose. Use of this plan and/or the information on it for any other purpose is at the user's risk.

CLIENT

Cabra Developments Ltd
Deacon Point
Stages 1 & 2
Dinning Road, Riverhead

DRAWING TITLE

Final Contours & Retaining Walls
As Built Plan
Sheet 3 of 6

This drawing and design remains the property of Cato Bolam Consultants Ltd and may not be reproduced without the written permission of Cato Bolam Consultants Ltd.

ORIGINAL SCALE	ORIGINAL SIZE	REVISION NO
1:500	A3	
DATE	CAD REFERENCE	SHEET NO
10/09/17	34147 E600-E605	E602
DIRECTORY	JOB NO	
Z:\34147\ACAD\ASBUILTS		34147

I certify that these As-built Plans are an accurate record of the works undertaken and that:
The Coordinates (X,Y) are in terms of NZTM on NZGD(2000), and are within ± 50mm.
The Levels (Z) are in terms of the Auckland 1946 (MSL) LINZ datum (DOSLI datum), and are within ± 25mm.

Signed:
Licensed Cadastral Surveyor

Date: 15/9/17


Name: Michelle Bain

Phone: 09 427 0072

Email: catobolam@catobolam.co.nz

NOTES

1. Levels are in terms of LINZ Datum 1946.
2. Coordinates are in terms of NZTM.
3. Contours are finished ground levels as surveyed on 04/09/17.
4. Retaining wall drain outlets to be connected at house construction stage.
5. All retaining walls have panel fencing above the wall.

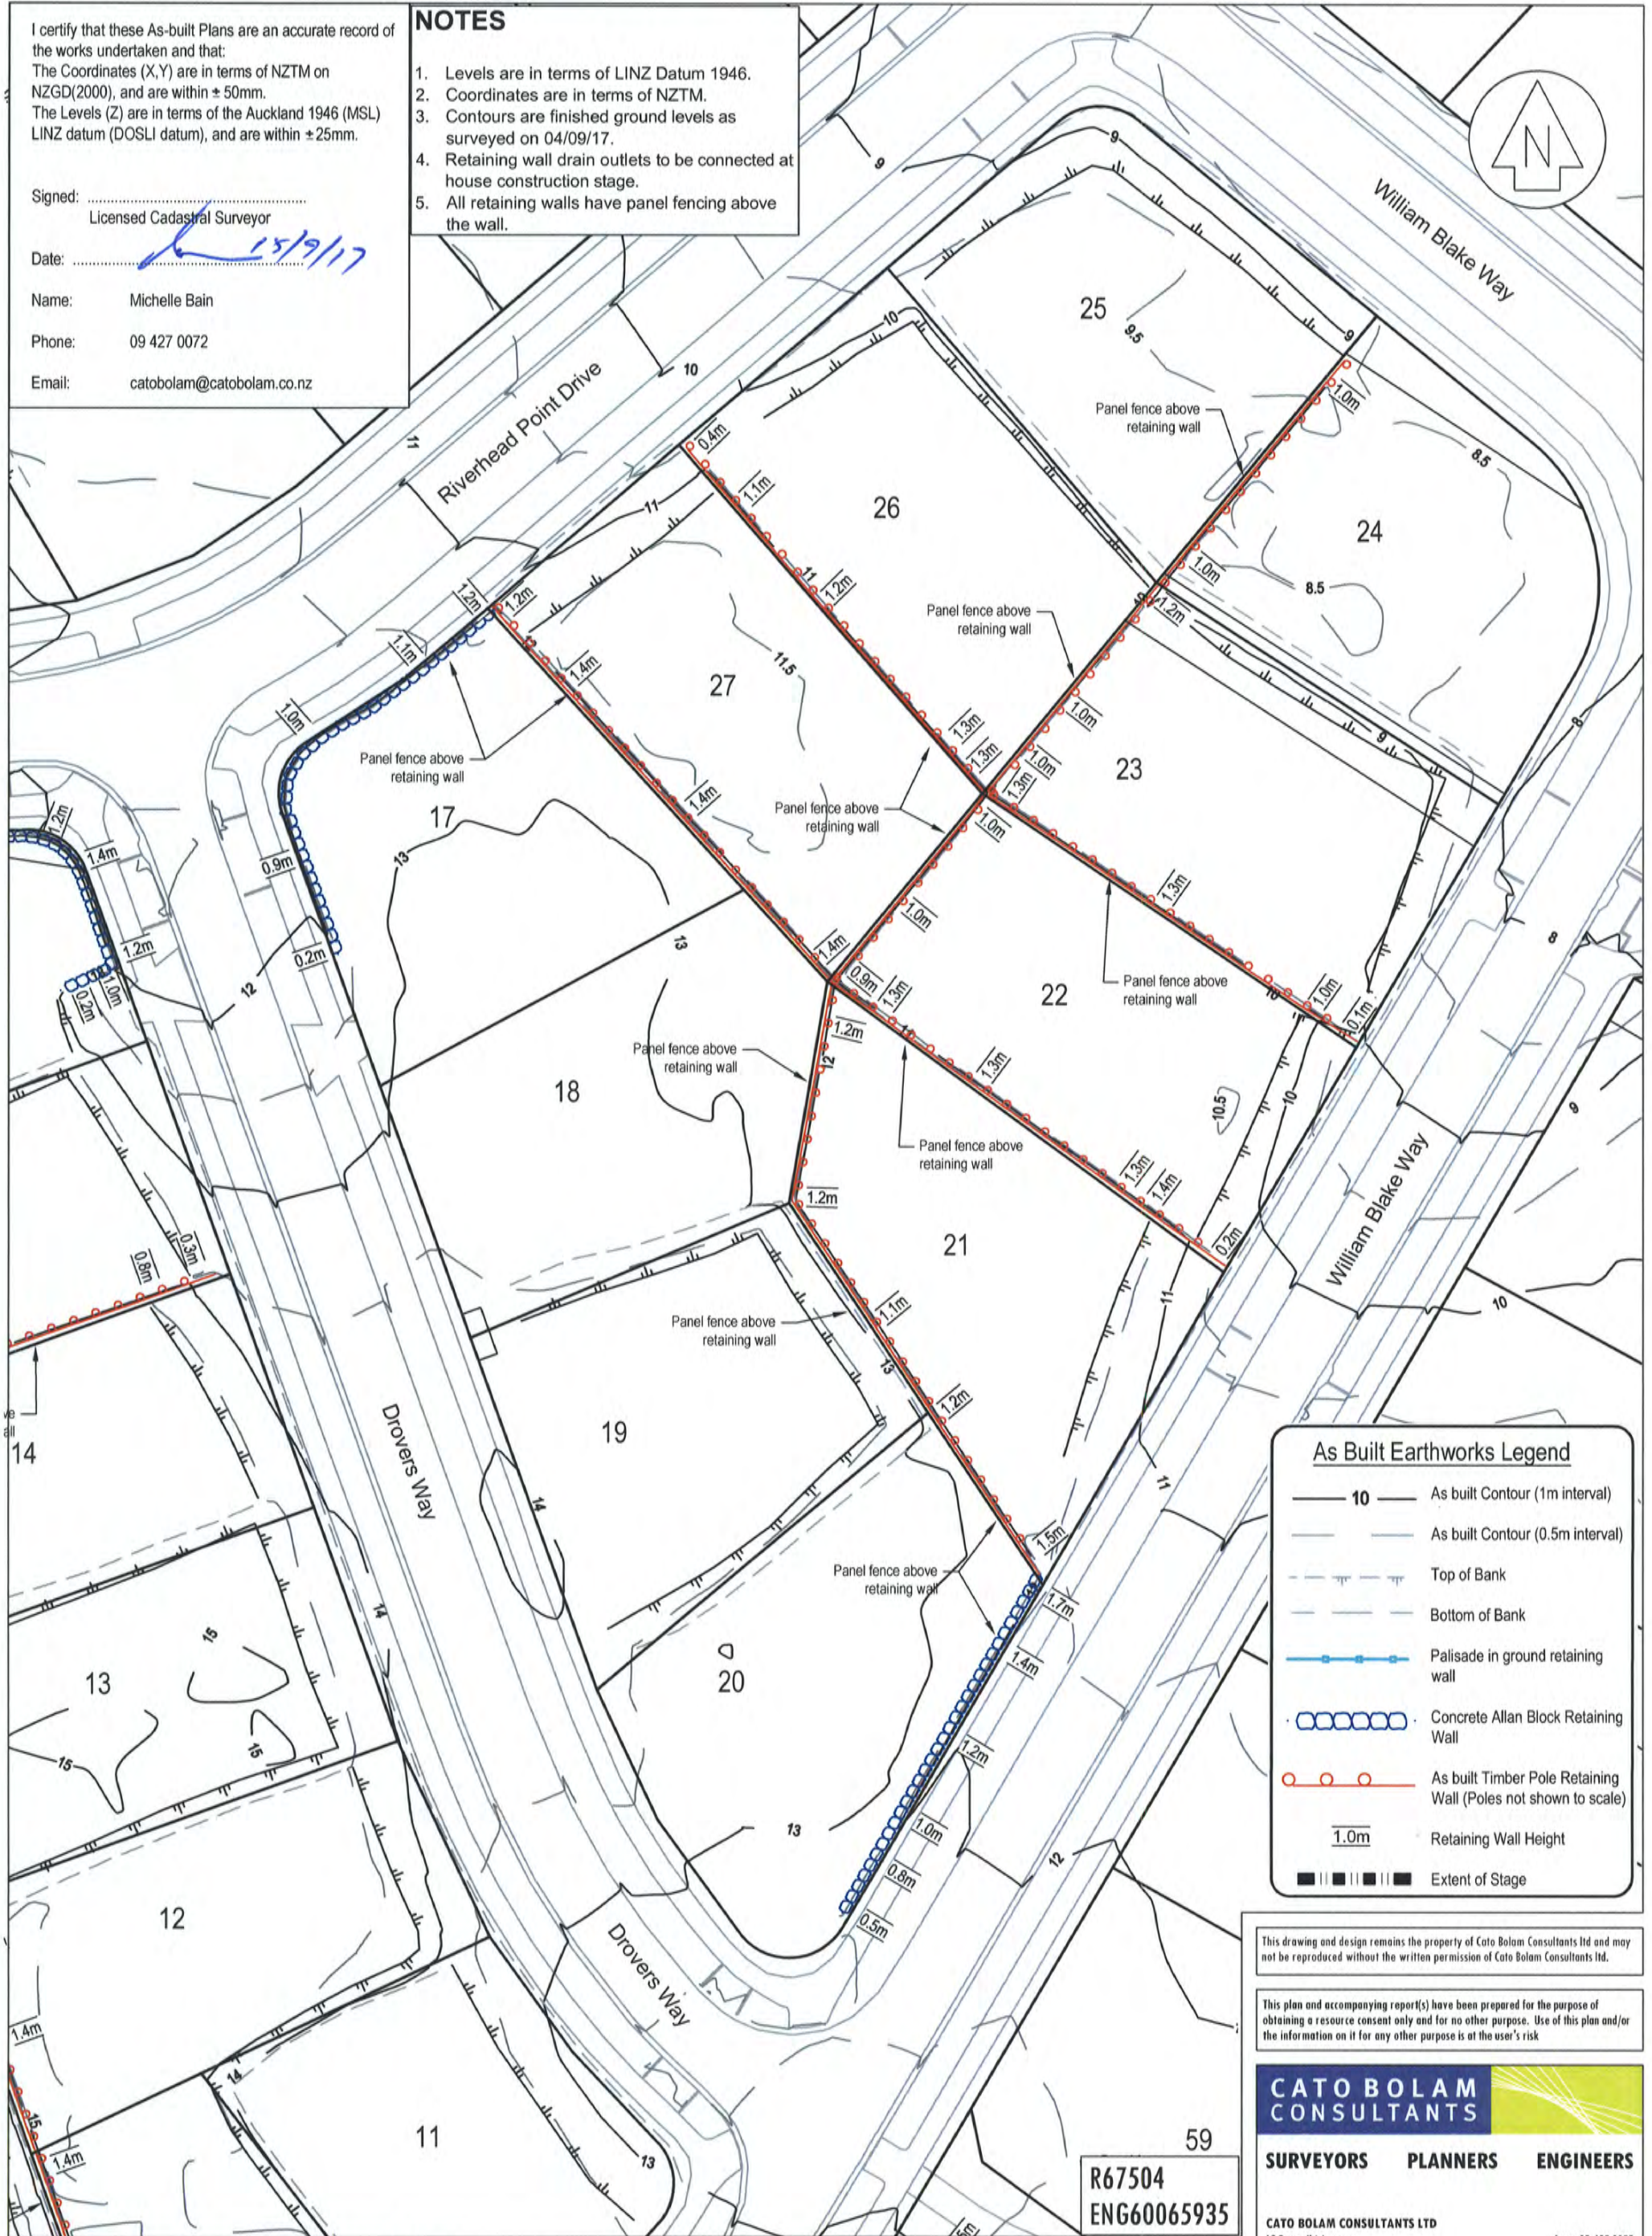

As Built Earthworks Legend

- 10 As built Contour (1m interval)
- As built Contour (0.5m interval)
- Top of Bank
- Bottom of Bank
- Palisade in ground retaining wall
- Concrete Allan Block Retaining Wall
- As built Timber Pole Retaining Wall (Poles not shown to scale)
- Retaining Wall Height
- Extent of Stage

This drawing and design remains the property of Cato Bolam Consultants Ltd and may not be reproduced without the written permission of Cato Bolam Consultants Ltd.

This plan and accompanying report(s) have been prepared for the purpose of obtaining a resource consent only and for no other purpose. Use of this plan and/or the information on it for any other purpose is at the user's risk.

CATO BOLAM CONSULTANTS

SURVEYORS PLANNERS ENGINEERS

CATO BOLAM CONSULTANTS LTD
19 Tamariki Avenue
PO Box 157
Orewa 0946

phone 09-427 0072
fax 09-426 7331
email catobolam@catobolam.co.nz


ORIGINAL SCALE	ORIGINAL SIZE	REVISION NO
1:500	A3	
DATE	CAD REFERENCE	SHEET NO
10/09/17	34147 E600-E605	E603
DIRECTORY	Z:\34147\ACAD\ASBUILTS	JOB NO
		34147

REVISION (DESCRIPTIONS)	NAME	DATE
SURVEYED	LD	09/17
DESIGNED	AA	09/17
DRAWN	BJ	09/17
CHECKED	TL	09/17
APPROVED		

CLIENT
Cabra Developments Ltd
Deacon Point
Stages 1 & 2
Dinning Road, Riverhead

DRAWING TITLE
Final Contours & Retaining Walls
As Built Plan
Sheet 4 of 6

R67504
ENG60065935

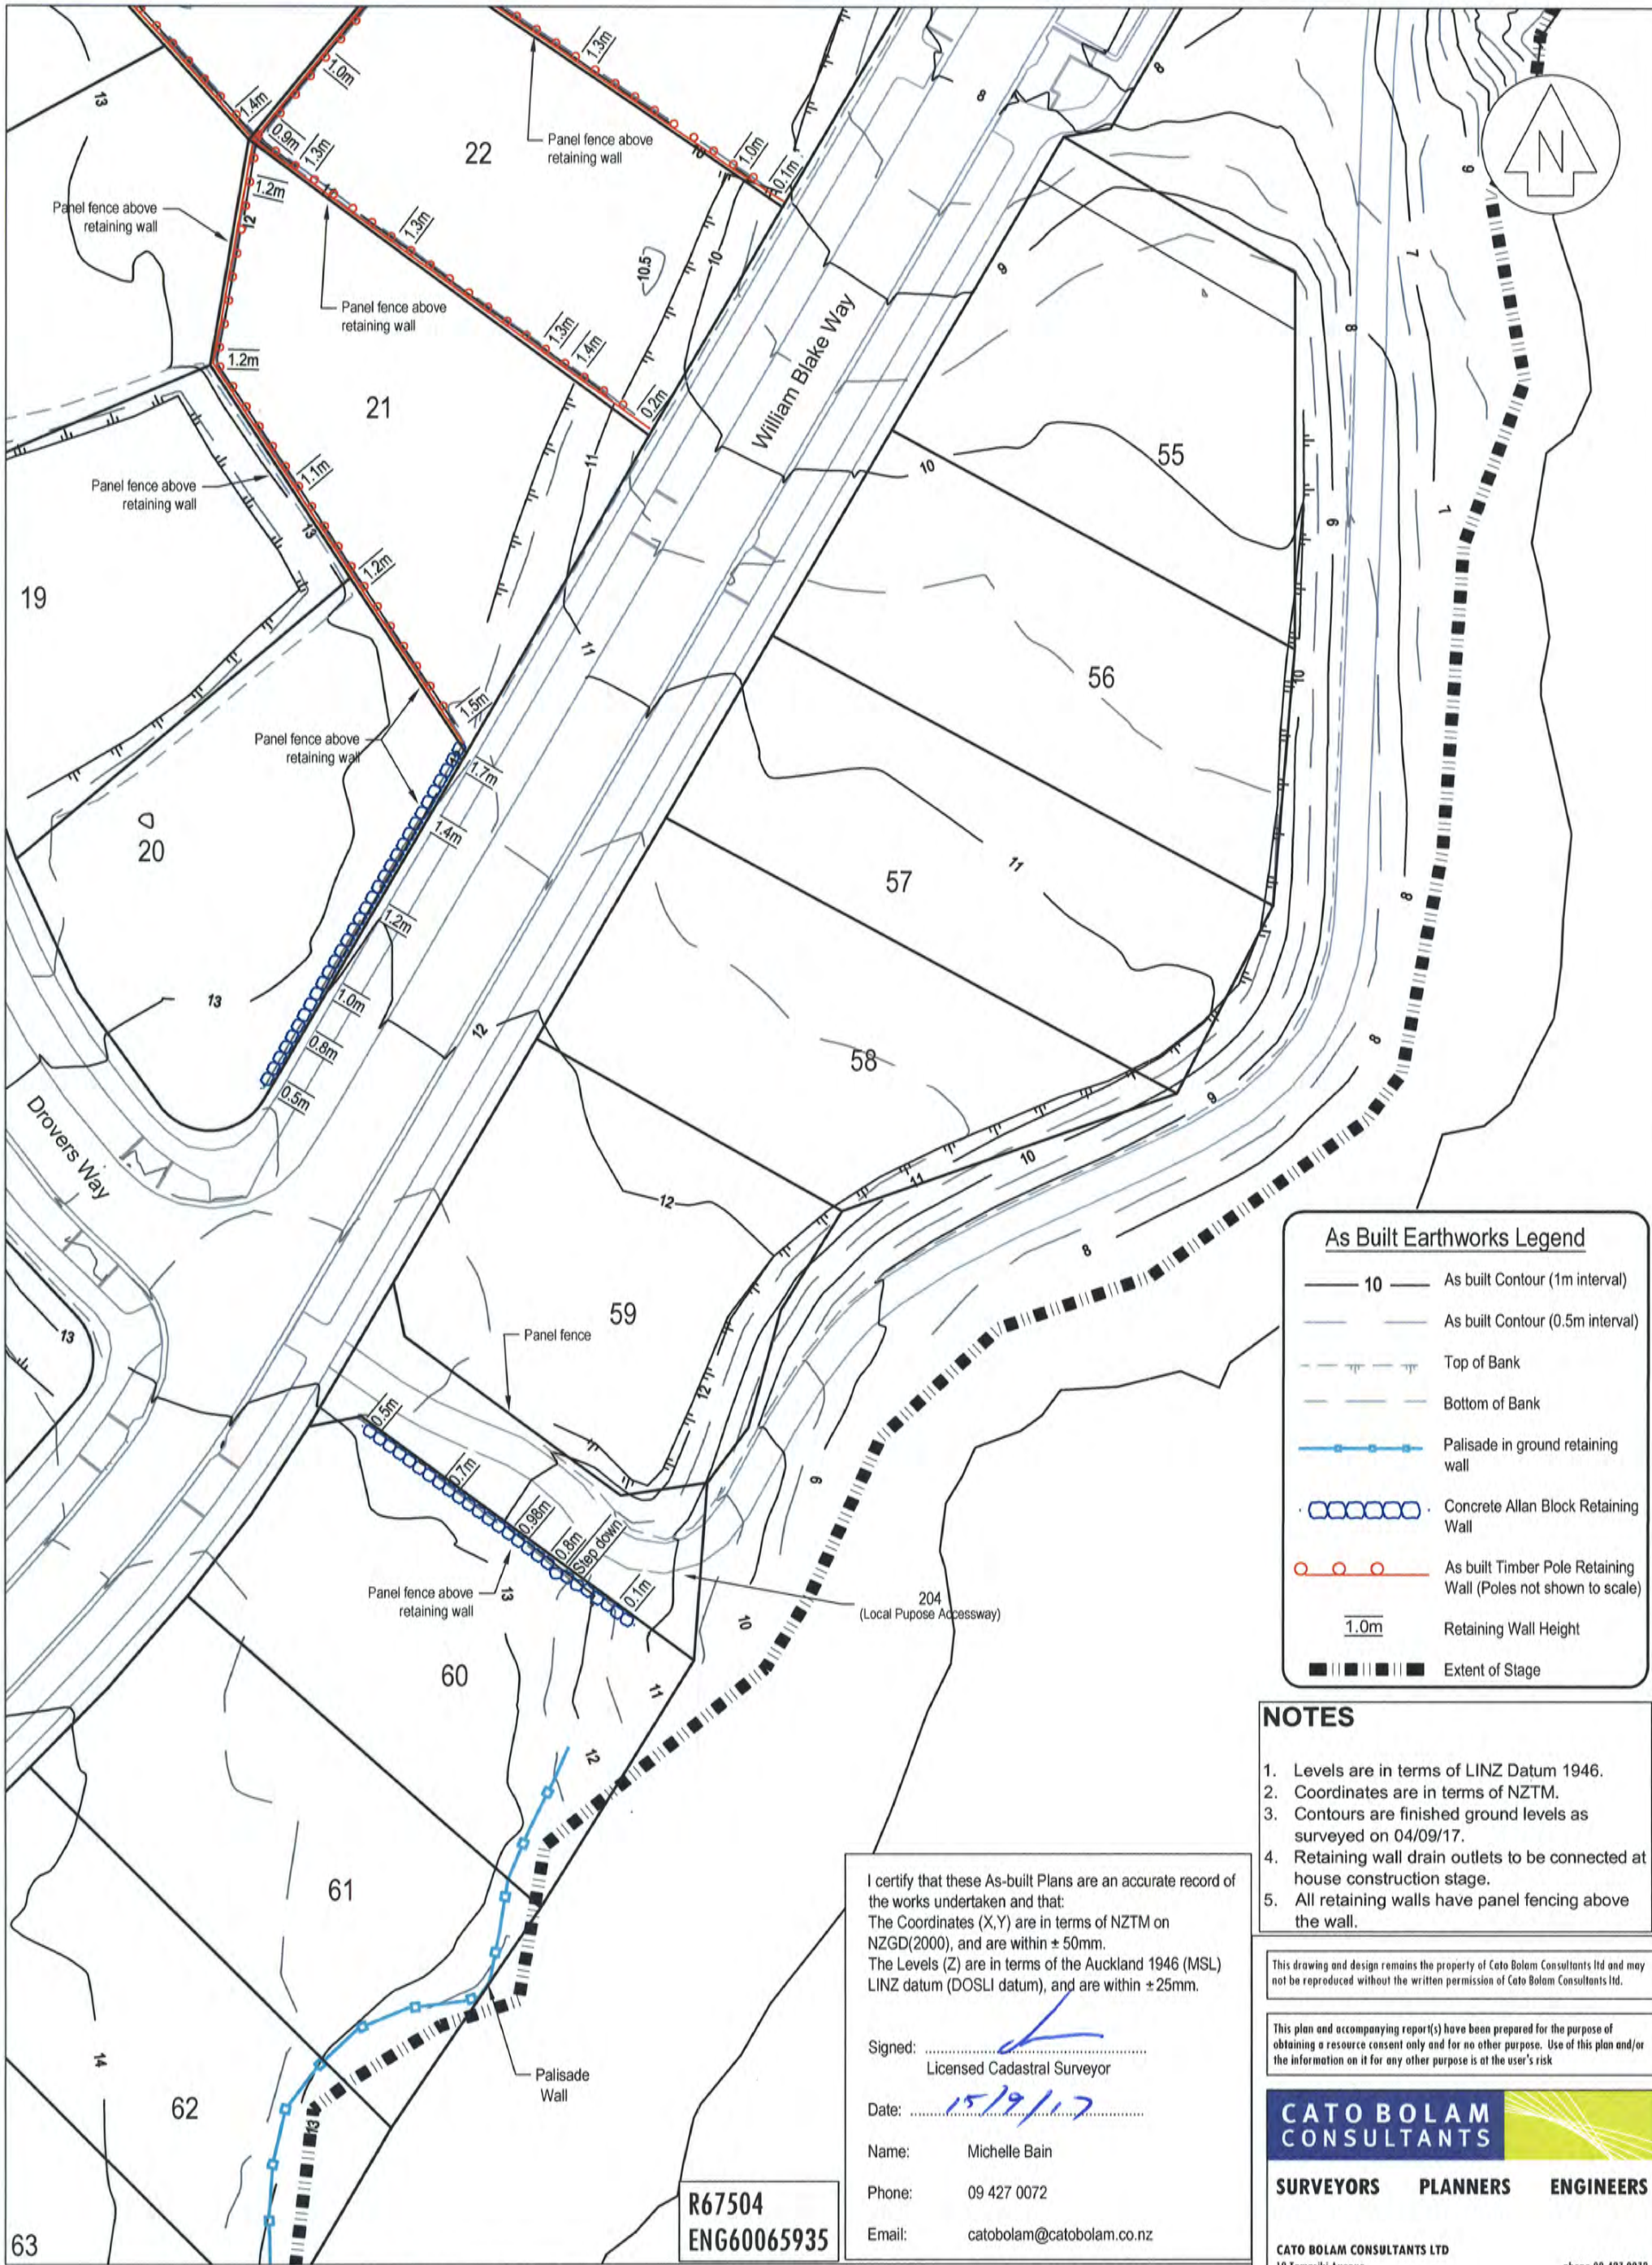

As Built Earthworks Legend

- 10 As built Contour (1m interval)
- As built Contour (0.5m interval)
- Top of Bank
- Bottom of Bank
- Palisade in ground retaining wall
- Concrete Allan Block Retaining Wall
- As built Timber Pole Retaining Wall (Poles not shown to scale)
- 1.0m Retaining Wall Height
- Extent of Stage

- NOTES**
1. Levels are in terms of LINZ Datum 1946.
 2. Coordinates are in terms of NZTM.
 3. Contours are finished ground levels as surveyed on 04/09/17.
 4. Retaining wall drain outlets to be connected at house construction stage.
 5. All retaining walls have panel fencing above the wall.

I certify that these As-built Plans are an accurate record of the works undertaken and that:
The Coordinates (X,Y) are in terms of NZTM on NZGD(2000), and are within ± 50mm.
The Levels (Z) are in terms of the Auckland 1946 (MSL) LINZ datum (DOSLI datum), and are within ± 25mm.

Signed:
Licensed Cadastral Surveyor

Date: 15/9/17

Name: Michelle Bain

Phone: 09 427 0072

Email: catobolam@catobolam.co.nz

R67504
ENG60065935

This drawing and design remains the property of Cato Bolam Consultants Ltd and may not be reproduced without the written permission of Cato Bolam Consultants Ltd.

This plan and accompanying report(s) have been prepared for the purpose of obtaining a resource consent only and for no other purpose. Use of this plan and/or the information on it for any other purpose is at the user's risk.

CATO BOLAM CONSULTANTS

SURVEYORS PLANNERS ENGINEERS


CATO BOLAM CONSULTANTS LTD
19 Tamariki Avenue
PO Box 157
Drewa 9946
phone 09-427 0072
fax 09-426 7331
email catobolam@catobolam.co.nz

ORIGINAL SCALE 1:500	ORIGINAL SIZE A3	REVISION NO
DATE 10/09/17	CAD REFERENCE 34147 E600-E605	SHEET NO E604
DIRECTORY Z:\34147\ACAD\ASBUILTS		JOB NO 34147

REVISION (DESCRIPTIONS)	NAME	DATE
SURVEYED	LD	09/17
DESIGNED		
DRAWN	AA	09/17
CHECKED	BJ	09/17
APPROVED	TL	09/17

CLIENT
Cabra Developments Ltd
Deacon Point
Stages 1 & 2
Dinning Road, Riverhead

DRAWING TITLE
Final Contours & Retaining Walls
As Built Plan
Sheet 5 of 6

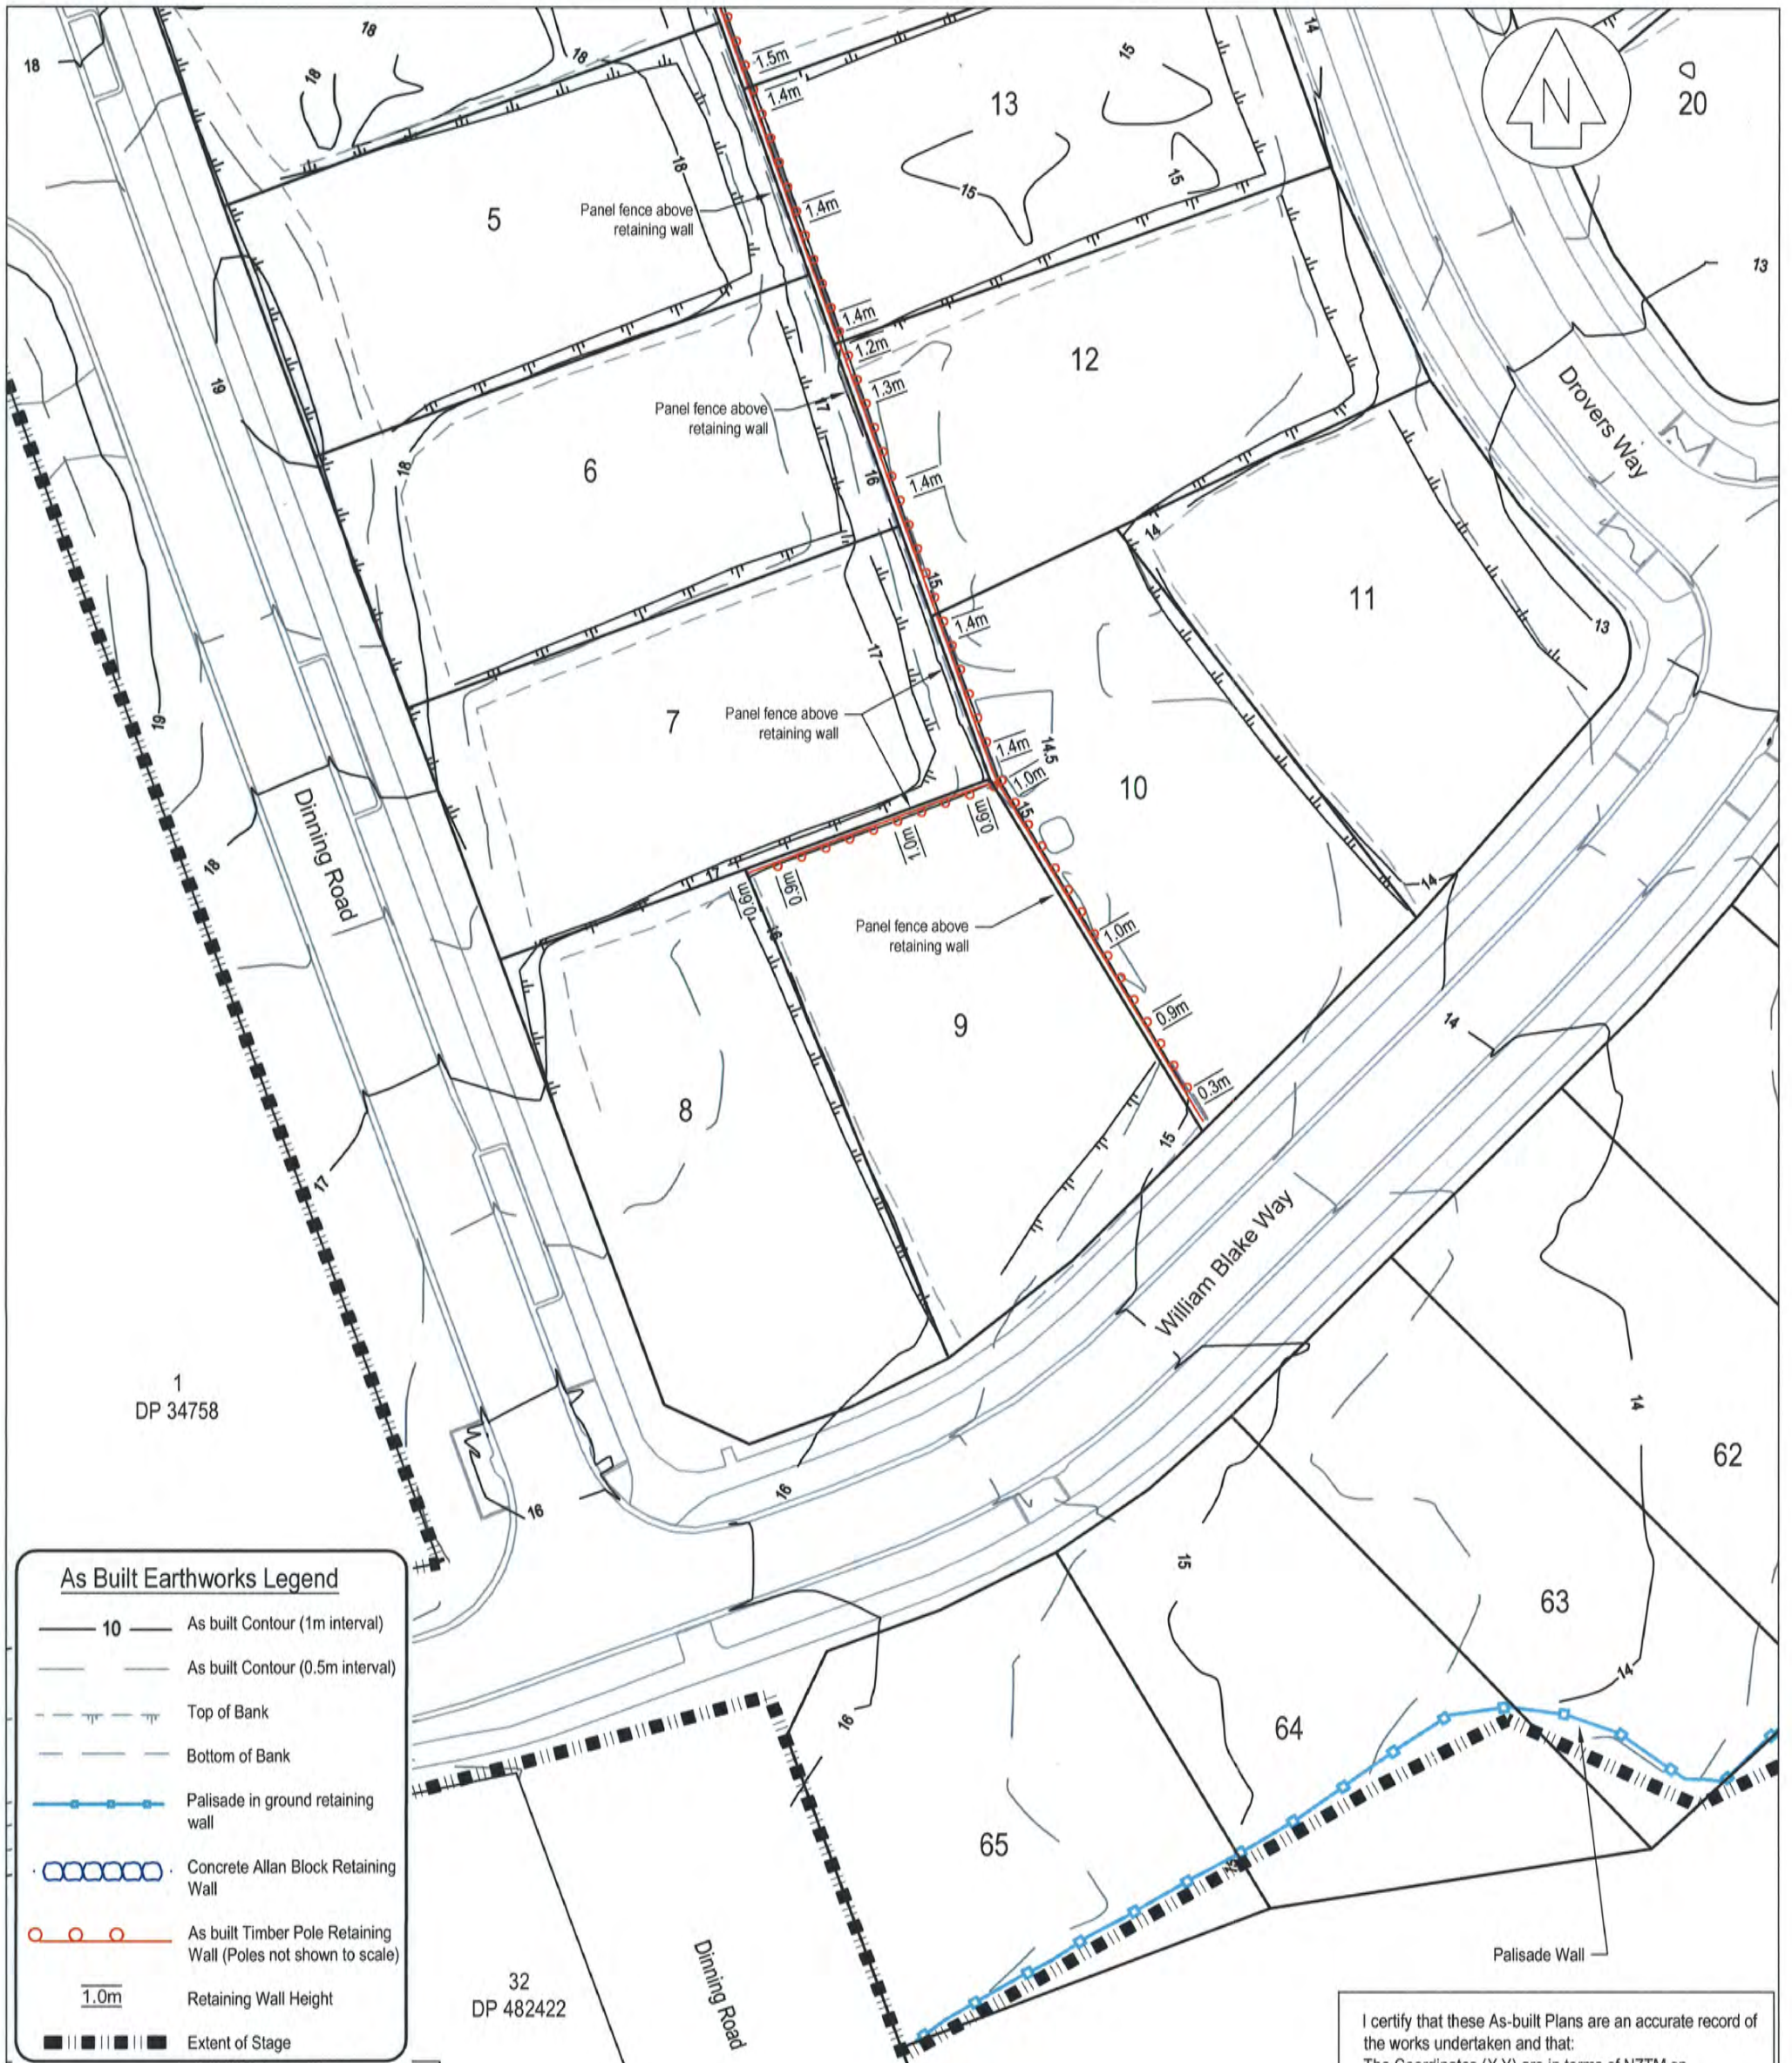

As Built Earthworks Legend

- 10 As built Contour (1m interval)
- As built Contour (0.5m interval)
- Top of Bank
- Bottom of Bank
- Palisade in ground retaining wall
- Concrete Allan Block Retaining Wall
- As built Timber Pole Retaining Wall (Poles not shown to scale)
- 1.0m Retaining Wall Height
- Extent of Stage

This drawing and design remains the property of Cato Bolam Consultants Ltd and may not be reproduced without the written permission of Cato Bolam Consultants Ltd.

This plan and accompanying report(s) have been prepared for the purpose of obtaining a resource consent only and for no other purpose. Use of this plan and/or the information on it for any other purpose is at the user's risk.

CATO BOLAM CONSULTANTS

SURVEYORS PLANNERS ENGINEERS

CATO BOLAM CONSULTANTS LTD
19 Tamariki Avenue
PO Box 157
Orewa 0946
phone 09-427 0072
fax 09-426 7331
email catobolam@catobolam.co.nz

NOTES

1. Levels are in terms of LINZ Datum 1946.
2. Coordinates are in terms of NZTM.
3. Contours are finished ground levels as surveyed on 04/09/17.
4. Retaining wall drain outlets to be connected at house construction stage.
5. All retaining walls have panel fencing above the wall.

REVISION (DESCRIPTIONS)	NAME	DATE
SURVEYED	LD	08/17
DESIGNED		
DRAWN	AA	09/17
CHECKED	TL	09/17
APPROVED	TL	09/17

I certify that these As-built Plans are an accurate record of the works undertaken and that:
The Coordinates (X,Y) are in terms of NZTM on NZGD(2000), and are within $\pm 50\text{mm}$.
The Levels (Z) are in terms of the Auckland 1946 (MSL) LINZ datum (DOSLI datum), and are within $\pm 25\text{mm}$.

Signed:
Licensed Cadastral Surveyor
Date: 15/11/17
Name: Michelle Bain
Phone: 09 427 0072
Email: catobolam@catobolam.co.nz

R67504
ENG60065935

CLIENT
Cabra Developments Ltd
Deacon Point
Stages 1 & 2
Dinning Road, Riverhead

DRAWING TITLE
Final Contours & Retaining Walls
As Built Plan
Sheet 6 of 6

ORIGINAL SCALE 1:500	ORIGINAL SIZE A3	REVISION NO
DATE 10/09/17	CAD REFERENCE 34147 E600-E605	SHEET NO E605
DIRECTORY Z:\34147\ACAD\ASBUILTS		JOB NO 34147

Cut to Fill Legend

	0 Contour
	Cut Contours & Area
	Fill Contours & Area
	Extent of Earthworks
	As built Timber Retaining Wall
	Palisade Wall
	Concrete Allan Block Retaining Wall
	Subsoil Drainage & depth (m)

Signed:
Licensed Cadastral Surveyor

Date:
Name: Michelle Bain

Phone: 09 427 0072

Email: catobolam@catobolam.co.nz



Cut to Fill Legend

- 0 0 Contour
- 1.0 Cut Contours & Area
- 1.0 Fill Contours & Area
- Extent of Earthworks
- As built Timber Retaining Wall
- Palisade Wall
- Concrete Allan Block Retaining Wall
- Subsoil Drainage & depth (m)

I certify that these As-built Plans are an accurate record of the works undertaken and that:
The Coordinates (X,Y) are in terms of NZTM on NZGD(2000), and are within $\pm 50\text{mm}$.
The Levels (Z) are in terms of the Auckland 1946 (MSL) LINZ datum (DOSLI datum), and are within $\pm 25\text{mm}$.

Signed: _____
Licensed Cadastral Surveyor

Date: 15/12/17

Name: Michelle Bain

Phone: 09 427 0072

Email: catobolam@catobolam.co.nz

Future Stage Under SLC 67504

Refer to Sheet E607

Refer to Sheet E608

NOTES

GENERAL

Levels are in terms of LINZ Datum 1946.

- Coordinates are in terms of NZTM.
- All infrastructure is public unless otherwise shown.
- Cut/fill contours are from the original ground level, plus undercuts, to finished ground level as surveyed on 04/09/17.

This drawing and design remains the property of Cato Bolam Consultants Ltd and may not be reproduced without the written permission of Cato Bolam Consultants Ltd.

This plan and accompanying report(s) have been prepared for the purpose of obtaining a resource consent only and for no other purpose. Use of this plan and/or the information on it for any other purpose is at the user's risk.

CATO BOLAM CONSULTANTS

SURVEYORS PLANNERS ENGINEERS

R67504 ENG60065935

CATO BOLAM CONSULTANTS LTD

107 Tapanui Road, Tapanui, Dunedin 9100, New Zealand

Phone: 09 427 0072

Refer to
Sheet E608

Levels are in terms of LINZ Datum 1946.

1. Coordinates are in terms of NZTM.
2. All infrastructure is public unless otherwise shown.
3. Cut/fill contours are from the original ground level, plus undercuts, to finished ground level as surveyed on 04/09/17.

This plan and accompanying report(s) have been prepared for the purpose of obtaining a resource consent only and for no other purpose. Use of this plan and/or the information on it for any other purpose is at the user's risk

ORIGINAL SCALE 1:1500	ORIGINAL SIZE A3	REVISION NO
DATE 10/09/17	CAD REFERENCE 34147 E606-E008	SHEET NO E606
DIRECTORY Z:\34147\ACAD\As Built Stage 1 and 2		JOB NO 34147

REVISION (DESCRIPTIONS)	NAME	DATE
	NAME	DATE
SURVEYED	LD	09/17
DESIGNED		
DRAWN	AA	09/17
CHECKED	BM	09/17
APPROVED	TM	09/17

**Cabra Developments Ltd
Deacon Point
Stages 1 & 2
Dinning Road, Riverhead**

Cut Fill
As Built Plan
Sheet 1 of 3

R67504
ENG60065935



NOTES
GENERAL
Levels are in terms of LINZ Datum 1946.
1. Coordinates are in terms of NZTM.
2. All infrastructure is public unless otherwise shown.
3. Cut/fill contours are from the original ground level, plus undercuts, to finished ground level as surveyed on 04/09/17.

I certify that these As-built Plans are an accurate record of the works undertaken and that:
The Coordinates (X,Y) are in terms of NZTM on NZGD(2000), and are within ± 50mm.
The Levels (Z) are in terms of the Auckland 1946 (MSL) LINZ datum (DOSLI datum), and are within ± 25mm.

Signed: _____
Licensed Cadastral Surveyor

Date: 15/10/17

Name: Michelle Bain
Phone: 09 427 0072
Email: catobolam@catobolam.co.nz

CATO BOLAM CONSULTANTS
PLANNERS | SURVEYORS | ENGINEERS | ENVIRONMENTAL

CATO BOLAM CONSULTANTS LTD
19 Tamariki Avenue
PO Box 157
Orewa 0946

phone 09-427 0072
fax 09-426 7331
email catobolam@catobolam.co.nz

REVISION (DESCRIPTIONS)	NAME	DATE
SURVEYED	LD	09/17
DESIGNED	AA	09/17
DRAWN	BM	09/17
CHECKED	TM	09/17
APPROVED		

This plan and accompanying report(s) have been prepared for the purpose of obtaining a resource consent only and for no other purpose. Use of this plan and/or the information on it for any other purpose is at the user's risk.

CLIENT
Cabra Developments Ltd
Deacon Point
Stages 1 & 2
Dinning Road, Riverhead

DRAWING TITLE
Cut Fill
As Built Plan
Sheet 2 of 3

ORIGINAL SCALE 1:1000	ORIGINAL SIZE A3	REVISION NO
DATE 10/09/2017	CAD REFERENCE 34147 E606 E608	SHEET NO E607
DIRECTORY Z:\34147\ACAD\As Built Stage 1 and 2		JOB NO 34147



I certify that these As-built Plans are an accurate record of the works undertaken and that:
The Coordinates (X,Y) are in terms of NZTM on NZGD(2000), and are within ± 50mm.
The Levels (Z) are in terms of the Auckland 1946 (MSL) LINZ datum (DOSLI datum), and are within ± 25mm.

Signed: _____
Licensed Cadastral Surveyor

Date: 15/9/17

Name: Michelle Bain

Phone: 09 427 0072

Email: catobolam@catobolam.co.nz

NOTES GENERAL

- Levels are in terms of LINZ Datum 1946.
1. Coordinates are in terms of NZTM.
 2. All infrastructure is public unless otherwise shown.
 3. Cut/fill contours are from the original ground level, plus undercuts, to finished ground level as surveyed on 04/09/17.

**CATO BOLAM
CONSULTANTS**

PLANNERS | SURVEYORS | ENGINEERS | ENVIRONMENTAL

CATO BOLAM CONSULTANTS LTD
19 Tamariki Avenue
PO Box 157
Drewa 0946
phone 09-427 0072
fax 09-426 7331
email catobolam@catobolam.co.nz

REVISION (DESCRIPTIONS)	NAME	DATE
SURVEYED	LD	09/17
DESIGNED		
DRAWN	AA	09/17
CHECKED	BM	09/17
APPROVED	TM	09/17

This plan and accompanying report(s) have been prepared for the purpose of obtaining a resource consent only and for no other purpose. Use of this plan and/or the information on it for any other purpose is at the user's risk

CLIENT

Cabra Developments Ltd
Deacon Point
Stages 1 & 2
Dinning Road, Riverhead

DRAWING TITLE

Cut Fill
As Built Plan
Sheet 3 of 3

This drawing and design remains the property of Cato Bolam Consultants Ltd and may not be reproduced without the written permission of Cato Bolam Consultants Ltd.

ORIGINAL SCALE	ORIGINAL SIZE	REVISION NO
1:1000	A3	
DATE	CAD REFERENCE	SHEET NO
31/08/2017	34147 E606-E608	E608
DIRECTORY		JOB NO
Z:\34147\ACAD\As Built Stage 1 and 2		34147

NOTES

GENERAL

1. Levels are in terms of LINZ Datum 1946.
2. Coordinates are in terms of NZTM.
3. All infrastructure is public unless otherwise shown.

Pavement Formation

Road

Subgrade - Stabilised with 10kg/m² lime and 10kg/m² cement to a depth of 250mm
Subbase - 250mm GAP65
Basecourse - 100mm TNZ AP40
Seal - 30mm hotmix on grade 4 chipseal membrane

Kerb & channel

machine laid low profile mountable kerb

Parking Bays

175mm 20MPa exposed aggregate concrete, one layer of 665 mesh on 100mm GAP65 subbase

Vehicle Crossing

150mm 20MPa concrete, one layer of 665 mesh on 100mm GAP65 subbase

Road Footpaths

1.8m wide, 125mm 20MPa concrete on 30mm AP25 bedding

Esplanade Footpaths

2.5m wide, 125mm 20mPa concrete on 30mm AP25 bedding


I certify that these As-built Plans are an accurate record of the works undertaken and that:
The Coordinates (X,Y) are in terms of NZTM on NZGD(2000), and are within ± 50mm.
The Levels (Z) are in terms of the Auckland 1946 (MSL) LINZ datum (DOSLI datum), and are within ± 25mm.

Signed:
Licensed Cadastral Surveyor

Date: 16/10/17

Name: Brad Mowat
Phone: 09 427 0072

Email: catobolam@catobolam.co.nz

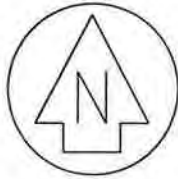

Roading As Built Legend

Street Lights

- Street Lights Cree XSP1 IP66 T3ME 29W system 4000K on vicpole round tapered IGM pole at 6m high and 1m arm 0 degree tilt. (700mm setback) (G=80 Candela=282) unless otherwise stated

- Totara (Dinning Road)
- Flowering Pear (Drovers Way)
- Titoki (William Blake Way)
- Sweet Gum (Dinning Road & Riverhead Point Drive)

- Concrete Footpath / Vehicle Crossing

- Cesspits (Semi recessed)

- Exposed Concrete Parking Bay

- Rain Garden (RG)

- Under channel drains

- Extent of Works

- Armco Traffic Barrier

- Subgrade undercut and replaced with engineered clay fill, unless noted otherwise

REVISION (DESCRIPTIONS)	NAME	DATE
SURVEYED	LD & BJ	08/17
DESIGNED		
DRAWN	BJ	09/17
CHECKED	BM	09/17
APPROVED	TL	09/17

CLIENT	Cabra Developments Ltd Deacon Point Stages 1 & 2 Dinning Road, Riverhead
--------	---


DRAWING TITLE	Road As Built Plan Sheet 1 of 4
---------------	---------------------------------------

R67504
ENG60065935

This drawing and design remains the property of Cato Bolam Consultants Ltd and may not be reproduced without the written permission of Cato Bolam Consultants Ltd.

This plan and accompanying report(s) have been prepared for the purpose of obtaining a resource consent only and for no other purpose. Use of this plan and/or the information on it for any other purpose is at the user's risk

CATO BOLAM CONSULTANTS		
SURVEYORS	PLANNERS	ENGINEERS
CATO BOLAM CONSULTANTS LTD 19 Tamariki Avenue PO Box 157 Orewa 0946		
phone 09-427 0072 fax 09-426 7331 email catobolam@catobolam.co.nz		
ORIGINAL SCALE 1:1500	ORIGINAL SIZE A3	REVISION NO R2
DATE 10/09/2017	CAD REFERENCE 34147 E609-E612 Roading	SHEET NO E609
DIRECTORY Z:\34147\ACAD\As Built Stage 1 and 2		JOB NO 34147

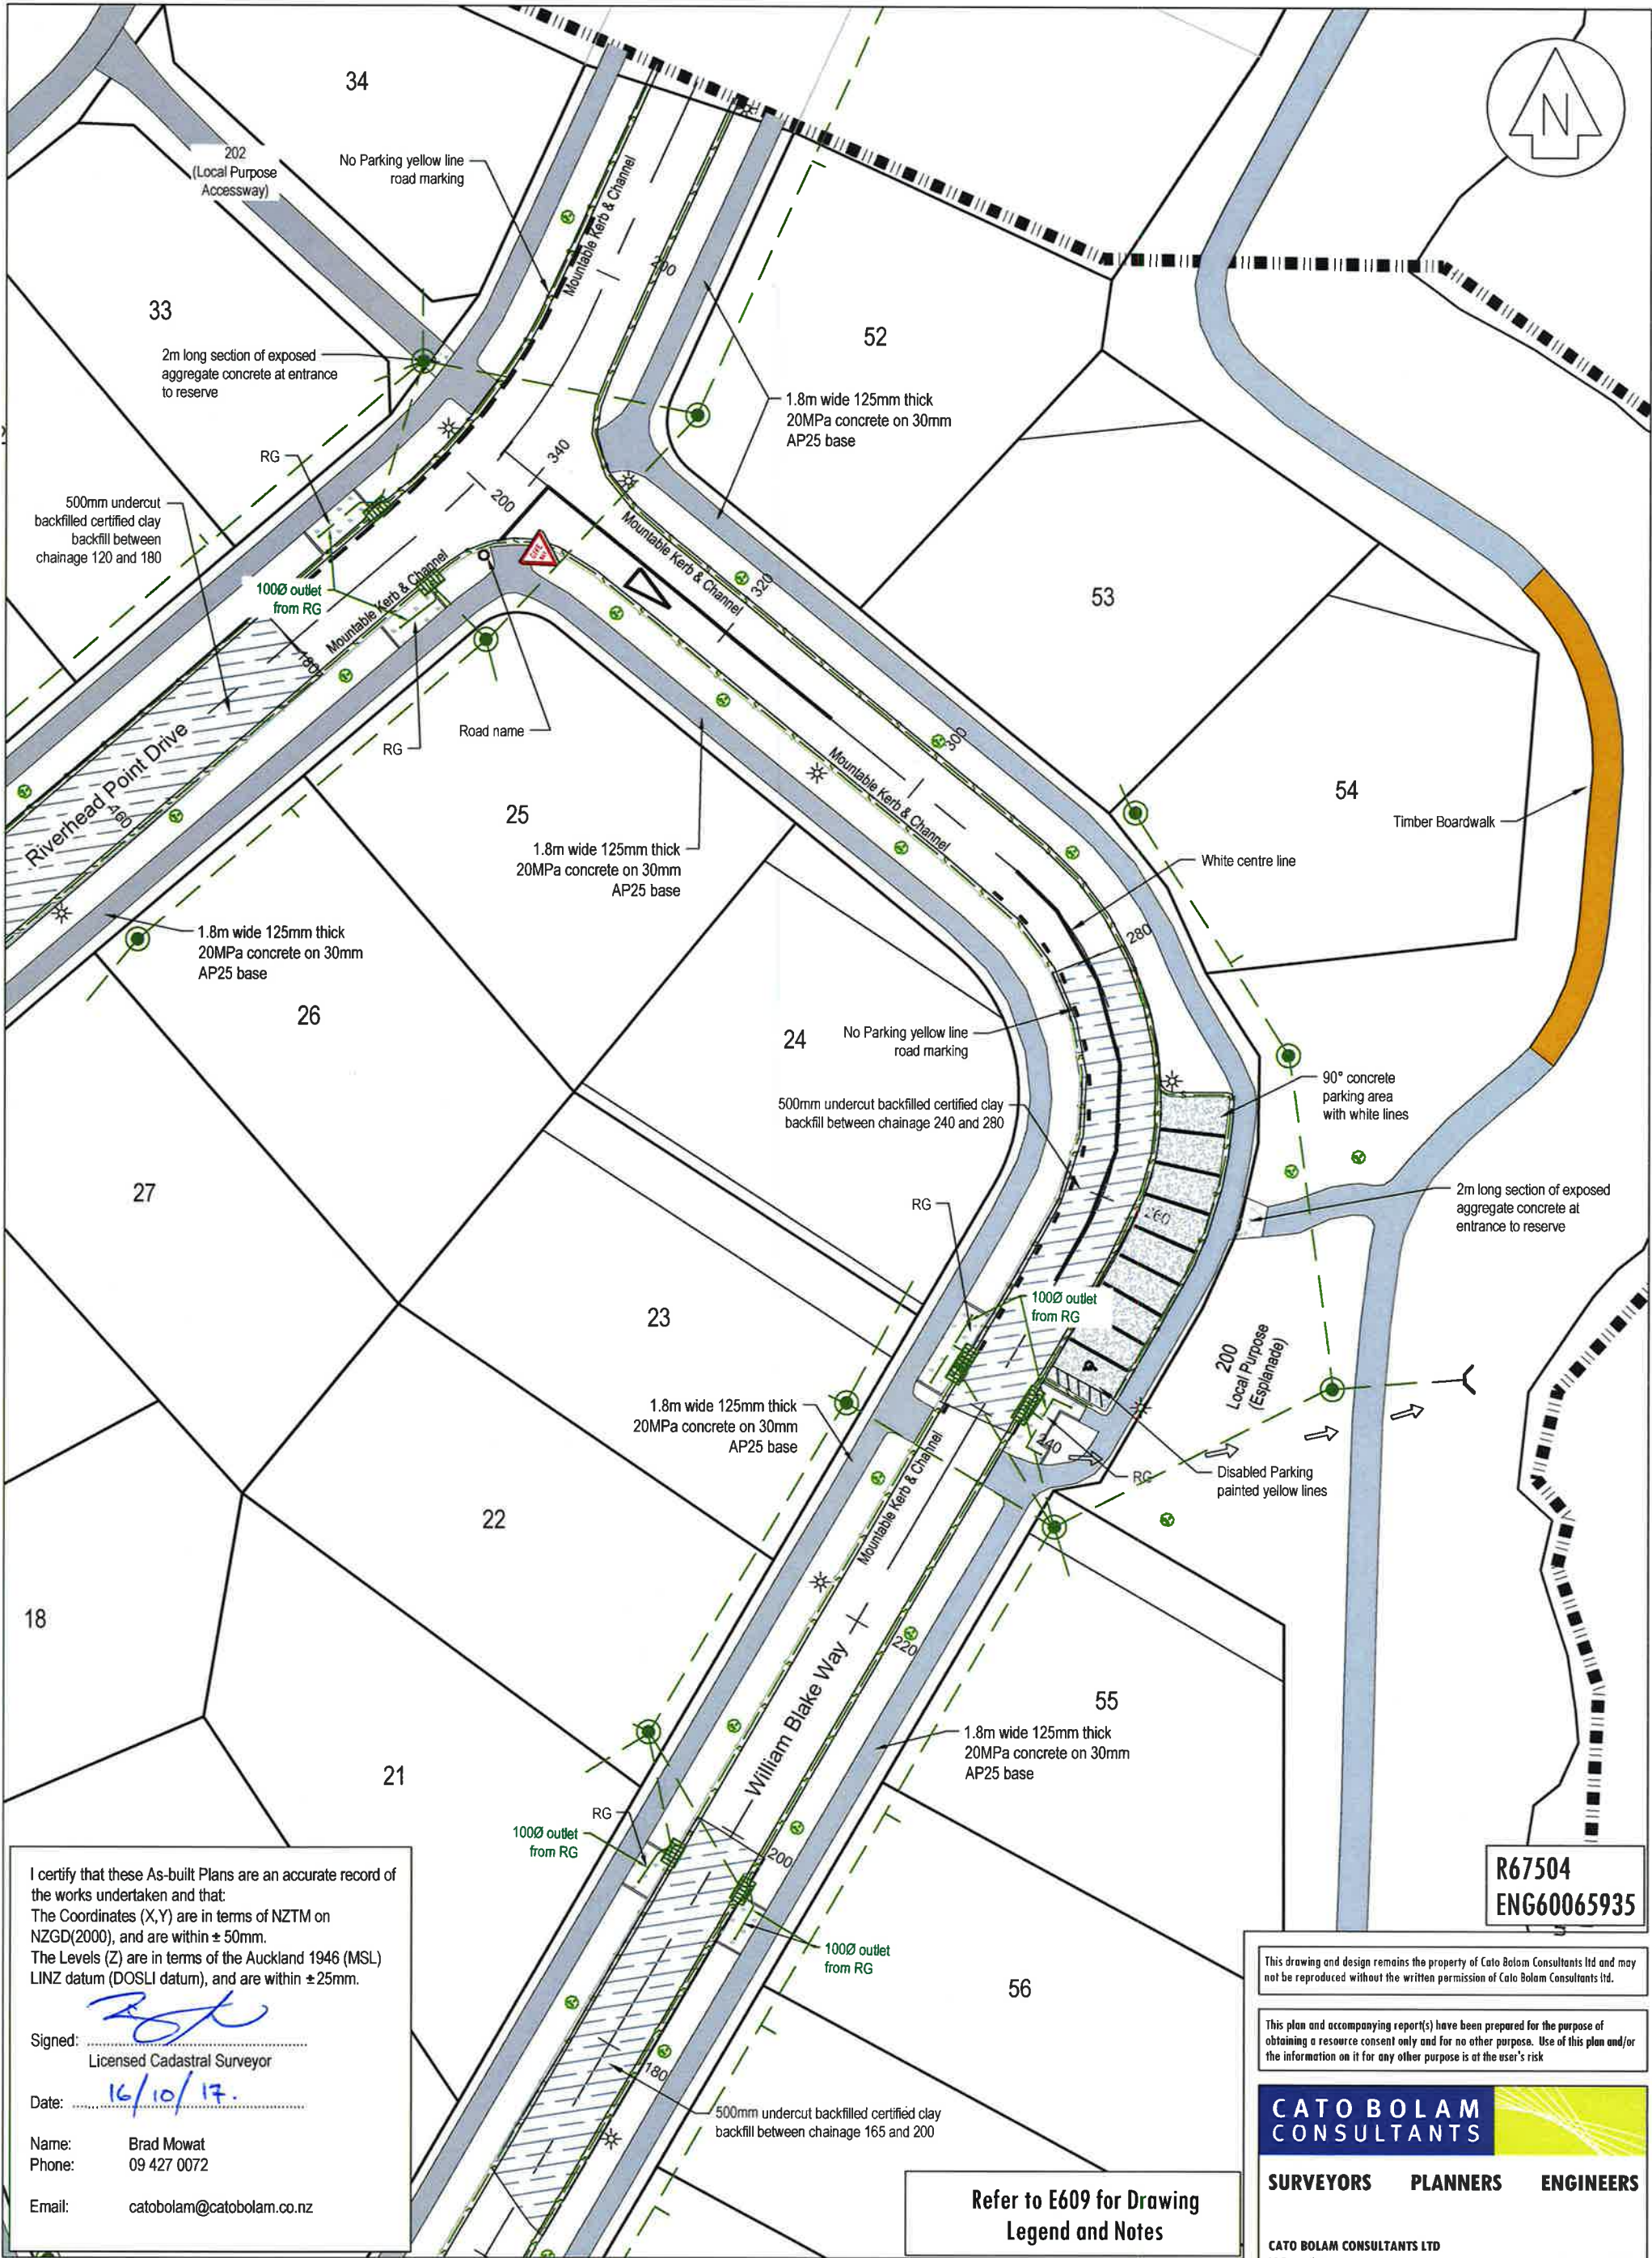

I certify that these As-built Plans are an accurate record of the works undertaken and that:
The Coordinates (X,Y) are in terms of NZTM on NZGD(2000), and are within ± 50mm.
The Levels (Z) are in terms of the Auckland 1946 (MSL) LINZ datum (DOSLI datum), and are within ± 25mm.

Signed: *[Signature]*
Licensed Cadastral Surveyor

Date: *16/10/17*

Name: Brad Mowat
Phone: 09 427 0072
Email: catobolam@catobolam.co.nz

REVISION (DESCRIPTIONS)	NAME	DATE
SURVEYED	LD & BJ	09/17
DESIGNED		
DRAWN	BJ	09/17
CHECKED	BM	09/17
APPROVED	TL	09/17

CLIENT

Cabra Developments Ltd
Deacon Point
Stages 1 & 2
Dinning Road, Riverhead

DRAWING TITLE

Roading
As Built Plan
Sheet 4 of 4

This drawing and design remains the property of Cato Bolam Consultants Ltd and may not be reproduced without the written permission of Cato Bolam Consultants Ltd.

This plan and accompanying report(s) have been prepared for the purpose of obtaining a resource consent only and for no other purpose. Use of this plan and/or the information on it for any other purpose is at the user's risk


CATOBOLAM CONSULTANTS

SURVEYORS PLANNERS ENGINEERS

CATO BOLAM CONSULTANTS LTD
19 Tamariki Avenue
PO Box 157
Orewa 0946
phone 09-427 0072
fax 09-426 7331
email catobolam@catobolam.co.nz

ORIGINAL SCALE 1:500	ORIGINAL SIZE A3	REVISION NO R2
DATE 10/09/2017	CAD REFERENCE 34147 E609-E612 Roading	SHEET NO E612
DIRECTORY Z:\34147\ACAD\As Built Stage 1 and 2		JOB NO 34147

I certify that these As-built Plans are an accurate record of the works undertaken and that:
The Coordinates (X,Y) are in terms of NZTM on NZGD(2000), and are within ± 50mm.
The Levels (Z) are in terms of the Auckland 1946 (MSL) LINZ datum (DOSLI datum), and are within ± 25mm.

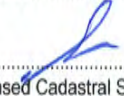
Signed: 
Licensed Cadastral Surveyor

Date: 15/9/17

Name: Michelle Bain

Phone: 09 427 0072

Email: catobolam@catobolam.co.nz

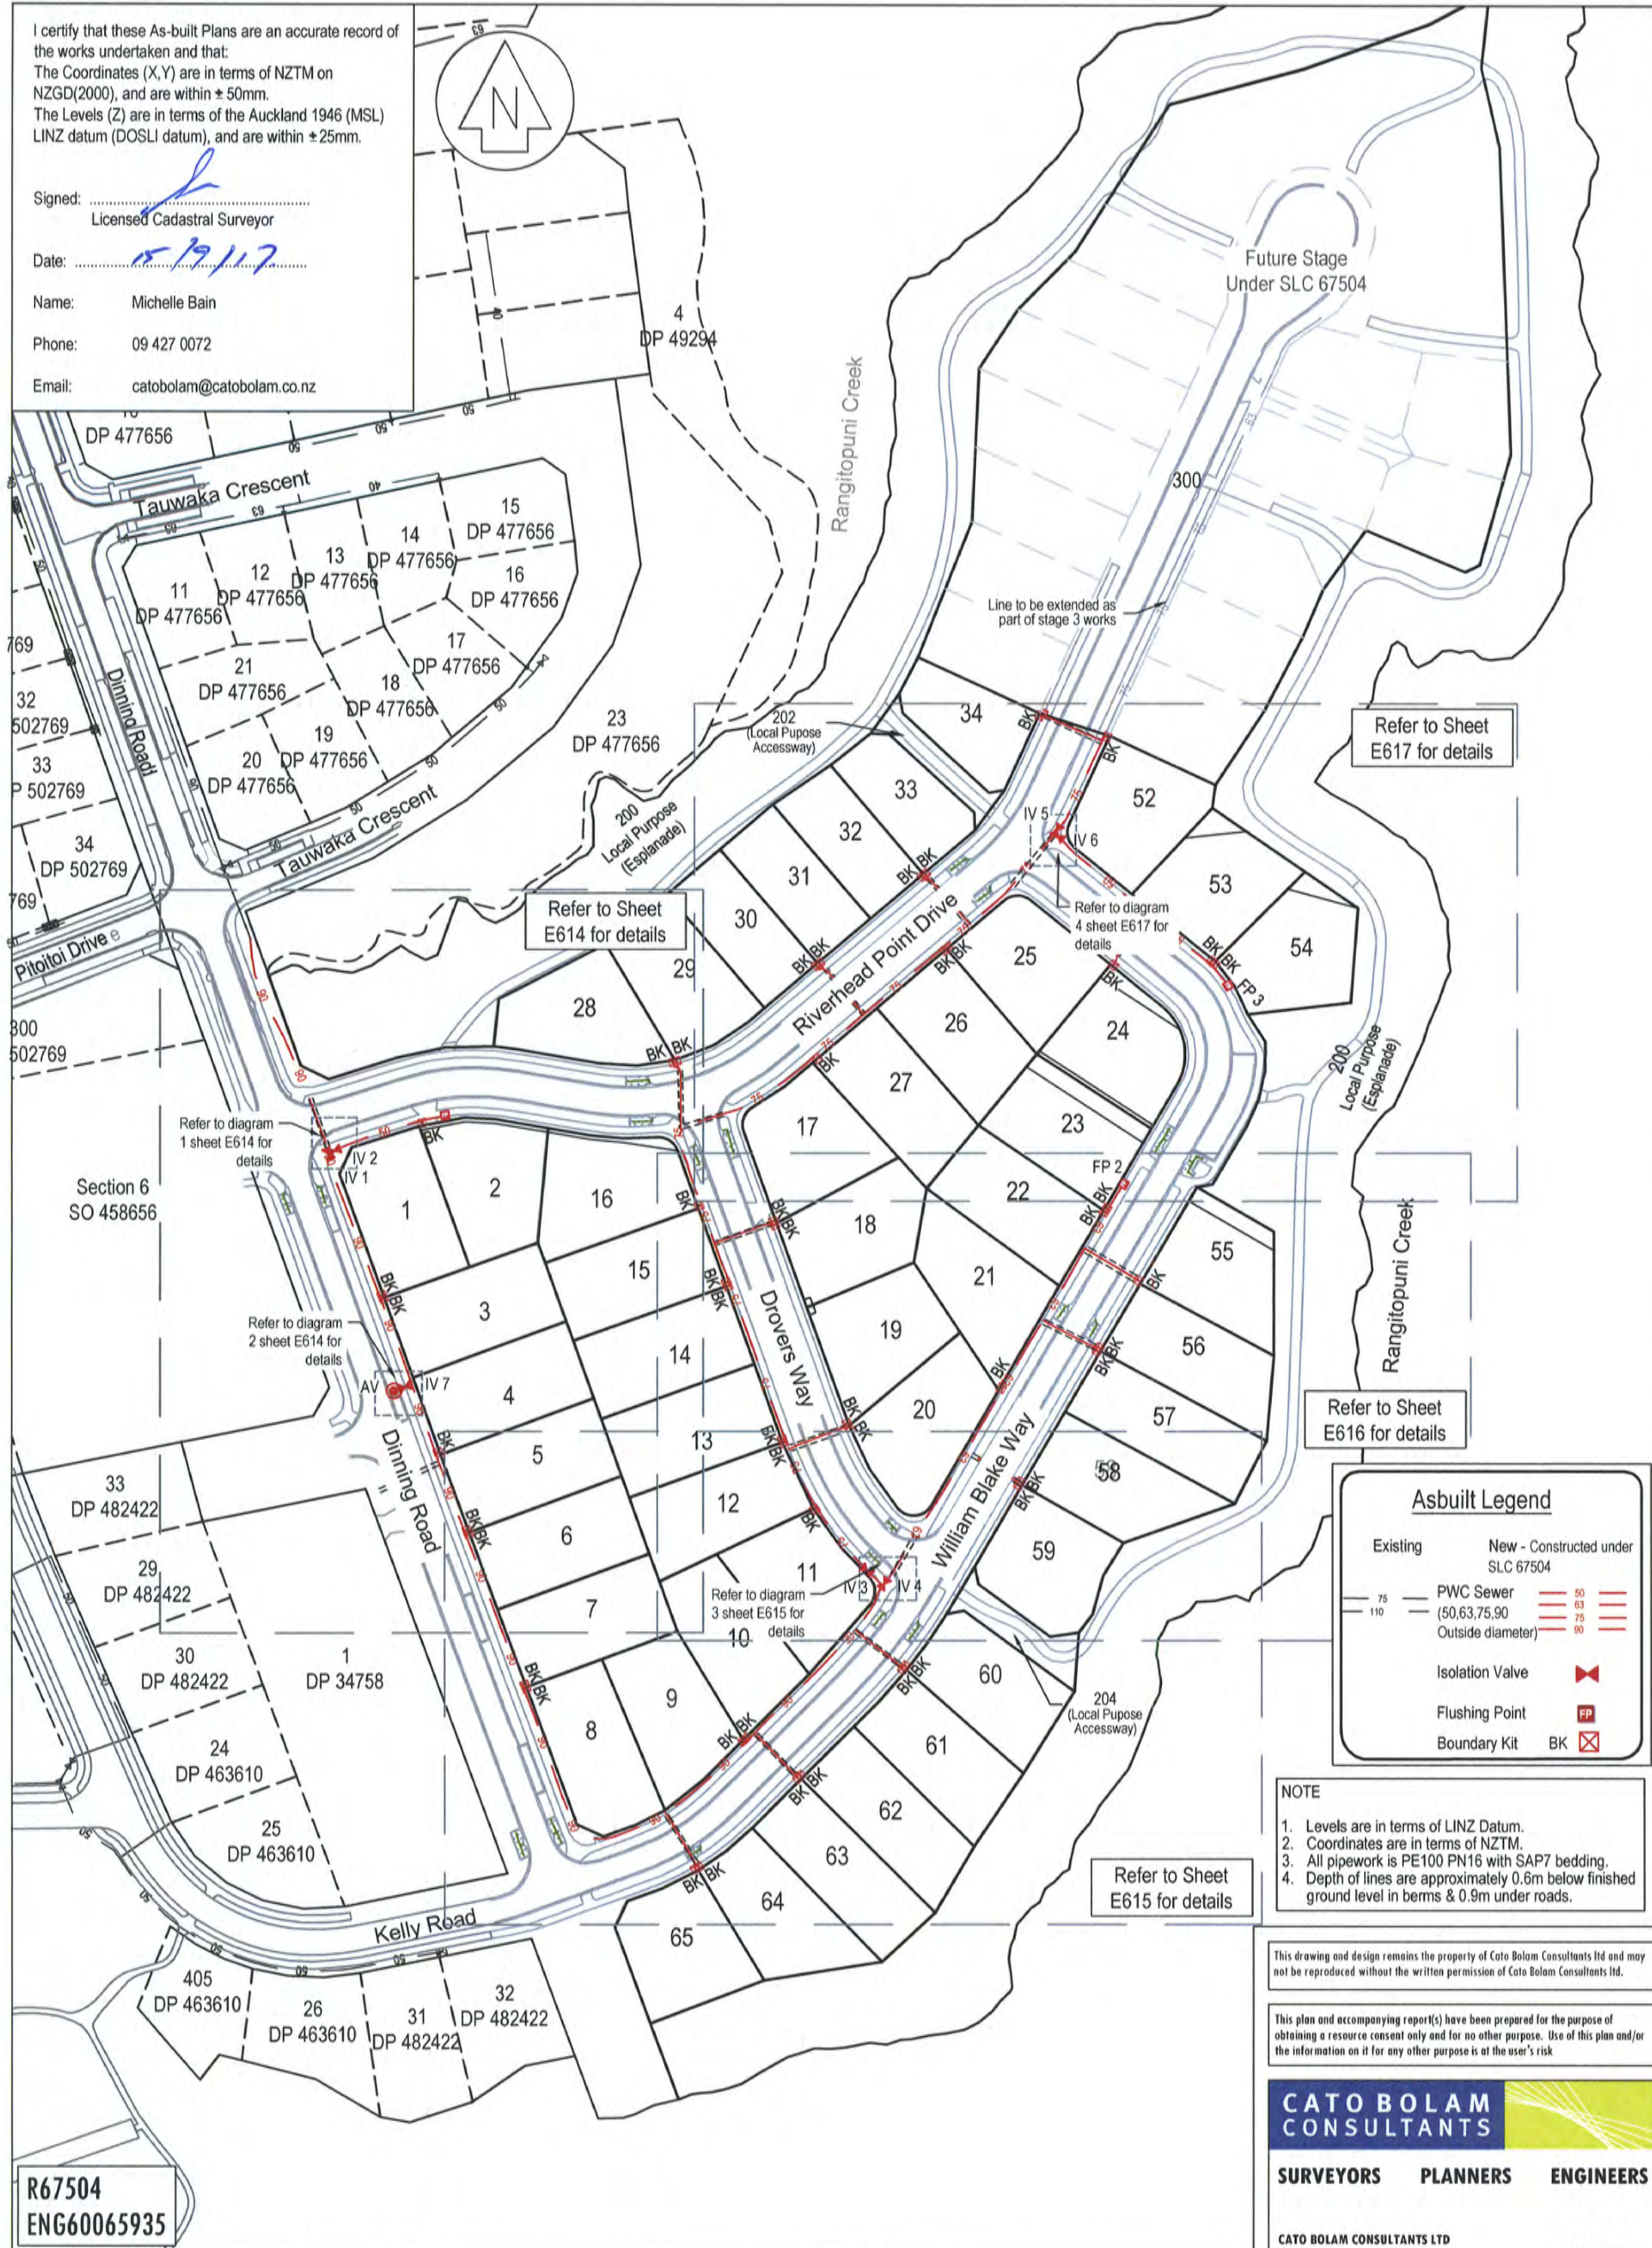

R67504
ENG60065935

REVISION (DESCRIPTIONS)	NAME	DATE
SURVEYED	LD	09/17
DESIGNED		
DRAWN	BJ	09/17
CHECKED	BM	09/17
APPROVED	TL	09/17

CLIENT	Cabra Developments Ltd Deacon Point Stages 1 & 2 Dinning Road, Riverhead
--------	---

DRAWING TITLE	Wastewater Reticulation As Built Plan Sheet 1 of 5
---------------	--

Asbuilt Legend	
Existing	New - Constructed under SLC 67504
75	PWC Sewer 50
110	(50,63,75,90 Outside diameter) 63
	75
	90
	Isolation Valve
	Flushing Point
	Boundary Kit

NOTE
1. Levels are in terms of LINZ Datum.
2. Coordinates are in terms of NZTM.
3. All pipework is PE100 PN16 with SAP7 bedding.
4. Depth of lines are approximately 0.6m below finished ground level in berms & 0.9m under roads.

This drawing and design remains the property of Cato Bolam Consultants Ltd and may not be reproduced without the written permission of Cato Bolam Consultants Ltd.

This plan and accompanying report(s) have been prepared for the purpose of obtaining a resource consent only and for no other purpose. Use of this plan and/or the information on it for any other purpose is at the user's risk.


CATO BOLAM CONSULTANTS

SURVEYORS PLANNERS ENGINEERS

CATO BOLAM CONSULTANTS LTD
19 Tamariki Avenue
PO Box 157
Orewa 0946

phone 09-427 0072
fax 09-426 7331
email catobolam@catobolam.co.nz

ORIGINAL SCALE	ORIGINAL SIZE	REVISION NO
1:1500	A3	
DATE	CAD REFERENCE	SHEET NO
10/09/17	34147 E613 E617 Sewer Retic	E613
DIRECTORY		JOB NO
Z:\34147\ACAD\As Built Stage 1 and 2		34147

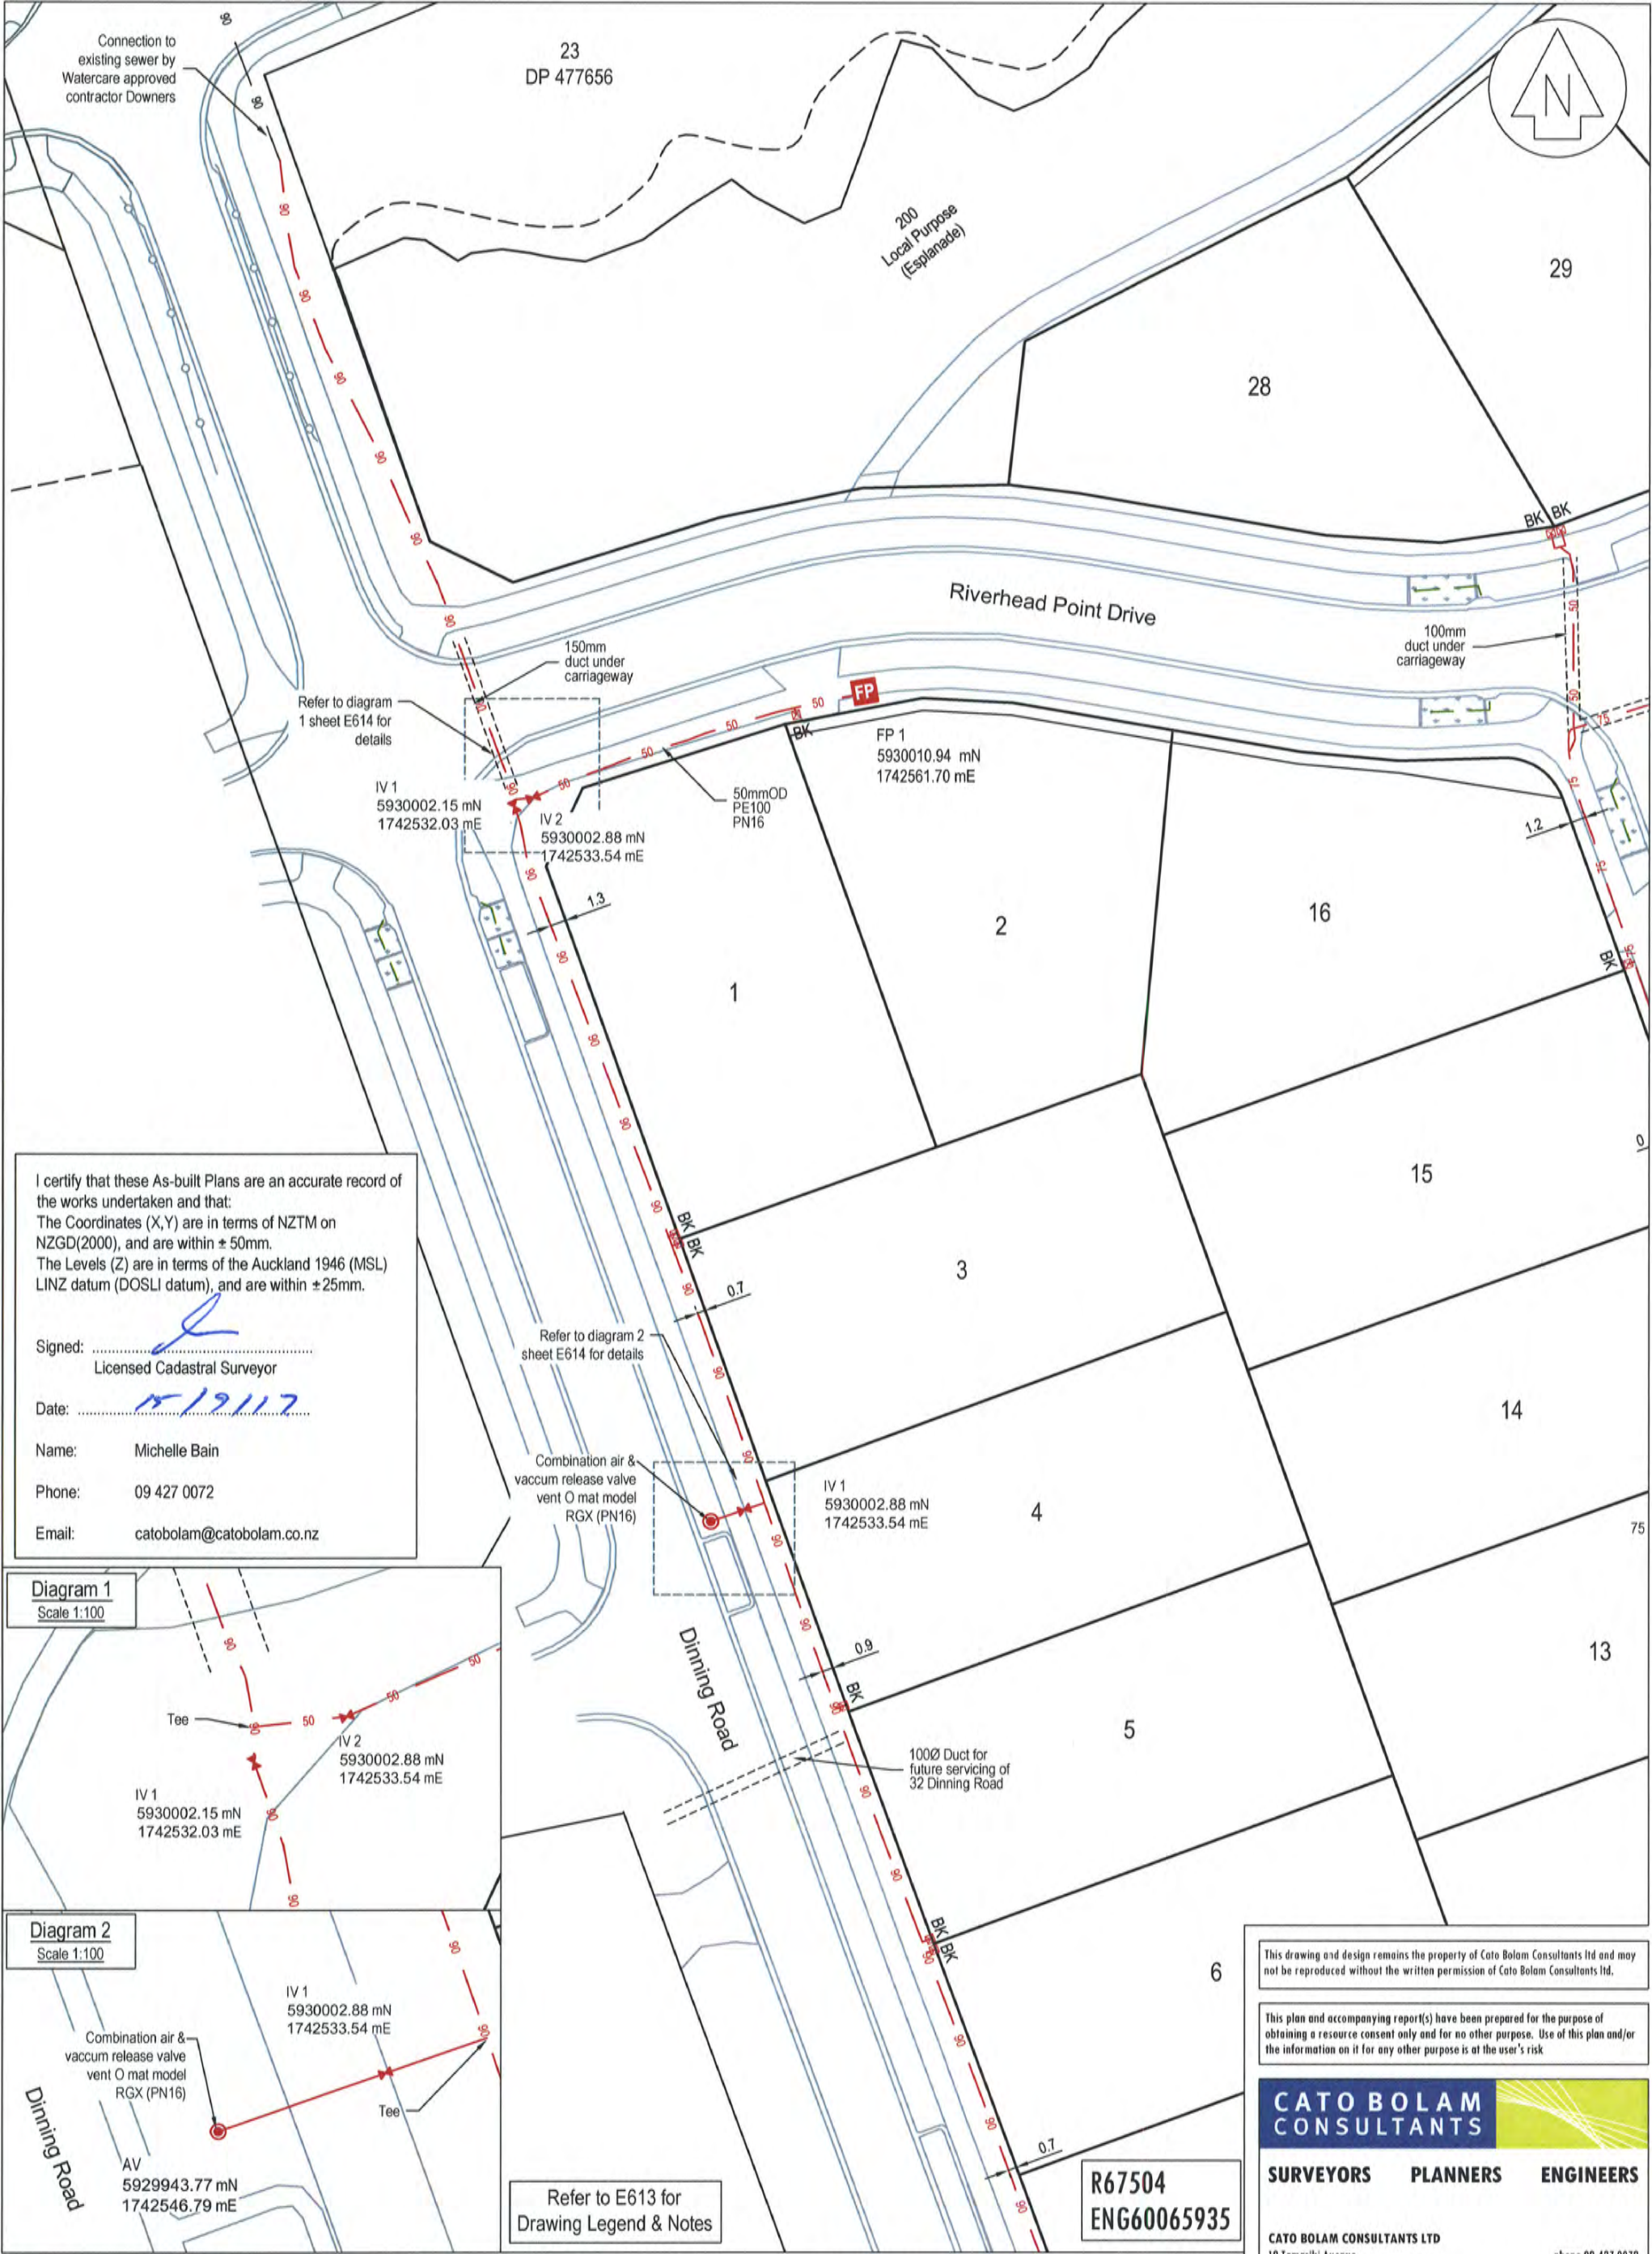

I certify that these As-built Plans are an accurate record of the works undertaken and that:
The Coordinates (X,Y) are in terms of NZTM on NZGD(2000), and are within ± 50mm.
The Levels (Z) are in terms of the Auckland 1946 (MSL) LINZ datum (DOSLI datum), and are within ± 25mm.

Signed: _____
Licensed Cadastral Surveyor

Date: 15/12/17

Name: Michelle Bain

Phone: 09 427 0072

Email: catobolam@catobolam.co.nz

Diagram 1
Scale 1:100


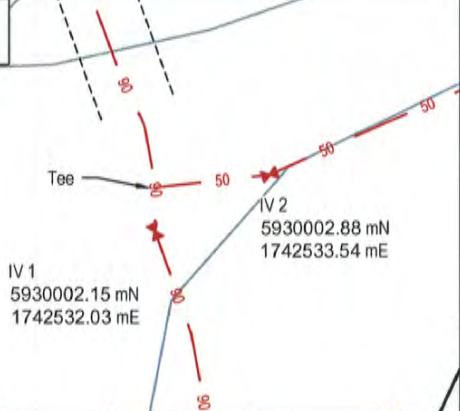


Diagram 2
Scale 1:100

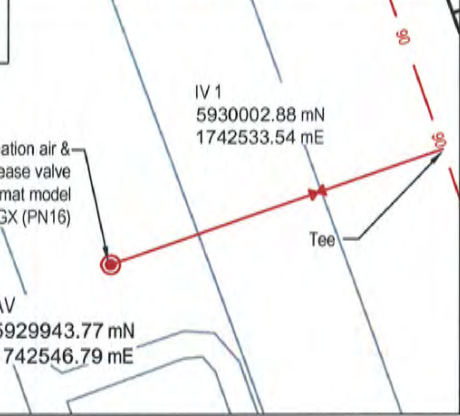

Refer to E613 for
Drawing Legend & Notes

R67504
ENG60065935

REVISION (DESCRIPTIONS)	NAME	DATE
SURVEYED	LD	09/17
DESIGNED		
DRAWN	BJ	09/17
CHECKED	BM	09/17
APPROVED	TL	09/17

CLIENT	Cabra Developments Ltd Deacon Point Stages 1 & 2 Dinning Road, Riverhead
--------	---

DRAWING TITLE	Wastewater Reticulation As Built Plan Sheet 2 of 5
---------------	--

This drawing and design remains the property of Cato Bolam Consultants Ltd and may not be reproduced without the written permission of Cato Bolam Consultants Ltd.


This plan and accompanying report(s) have been prepared for the purpose of obtaining a resource consent only and for no other purpose. Use of this plan and/or the information on it for any other purpose is at the user's risk.

CATO BOLAM CONSULTANTS

SURVEYORS PLANNERS ENGINEERS

CATO BOLAM CONSULTANTS LTD
19 Tamariki Avenue
PO Box 157
Dreva 0946
phone 09-427 0072
fax 09-426 7331
email catobolam@catobolam.co.nz

ORIGINAL SCALE 1:1500	ORIGINAL SIZE A3	REVISION NO
DATE 10/09/17	CAD REFERENCE 34147 E613 E617 Sewer Retic	SHEET NO E614
DIRECTORY Z:\34147\ACAD\As Built Stage 1 and 2		JOB NO 34147

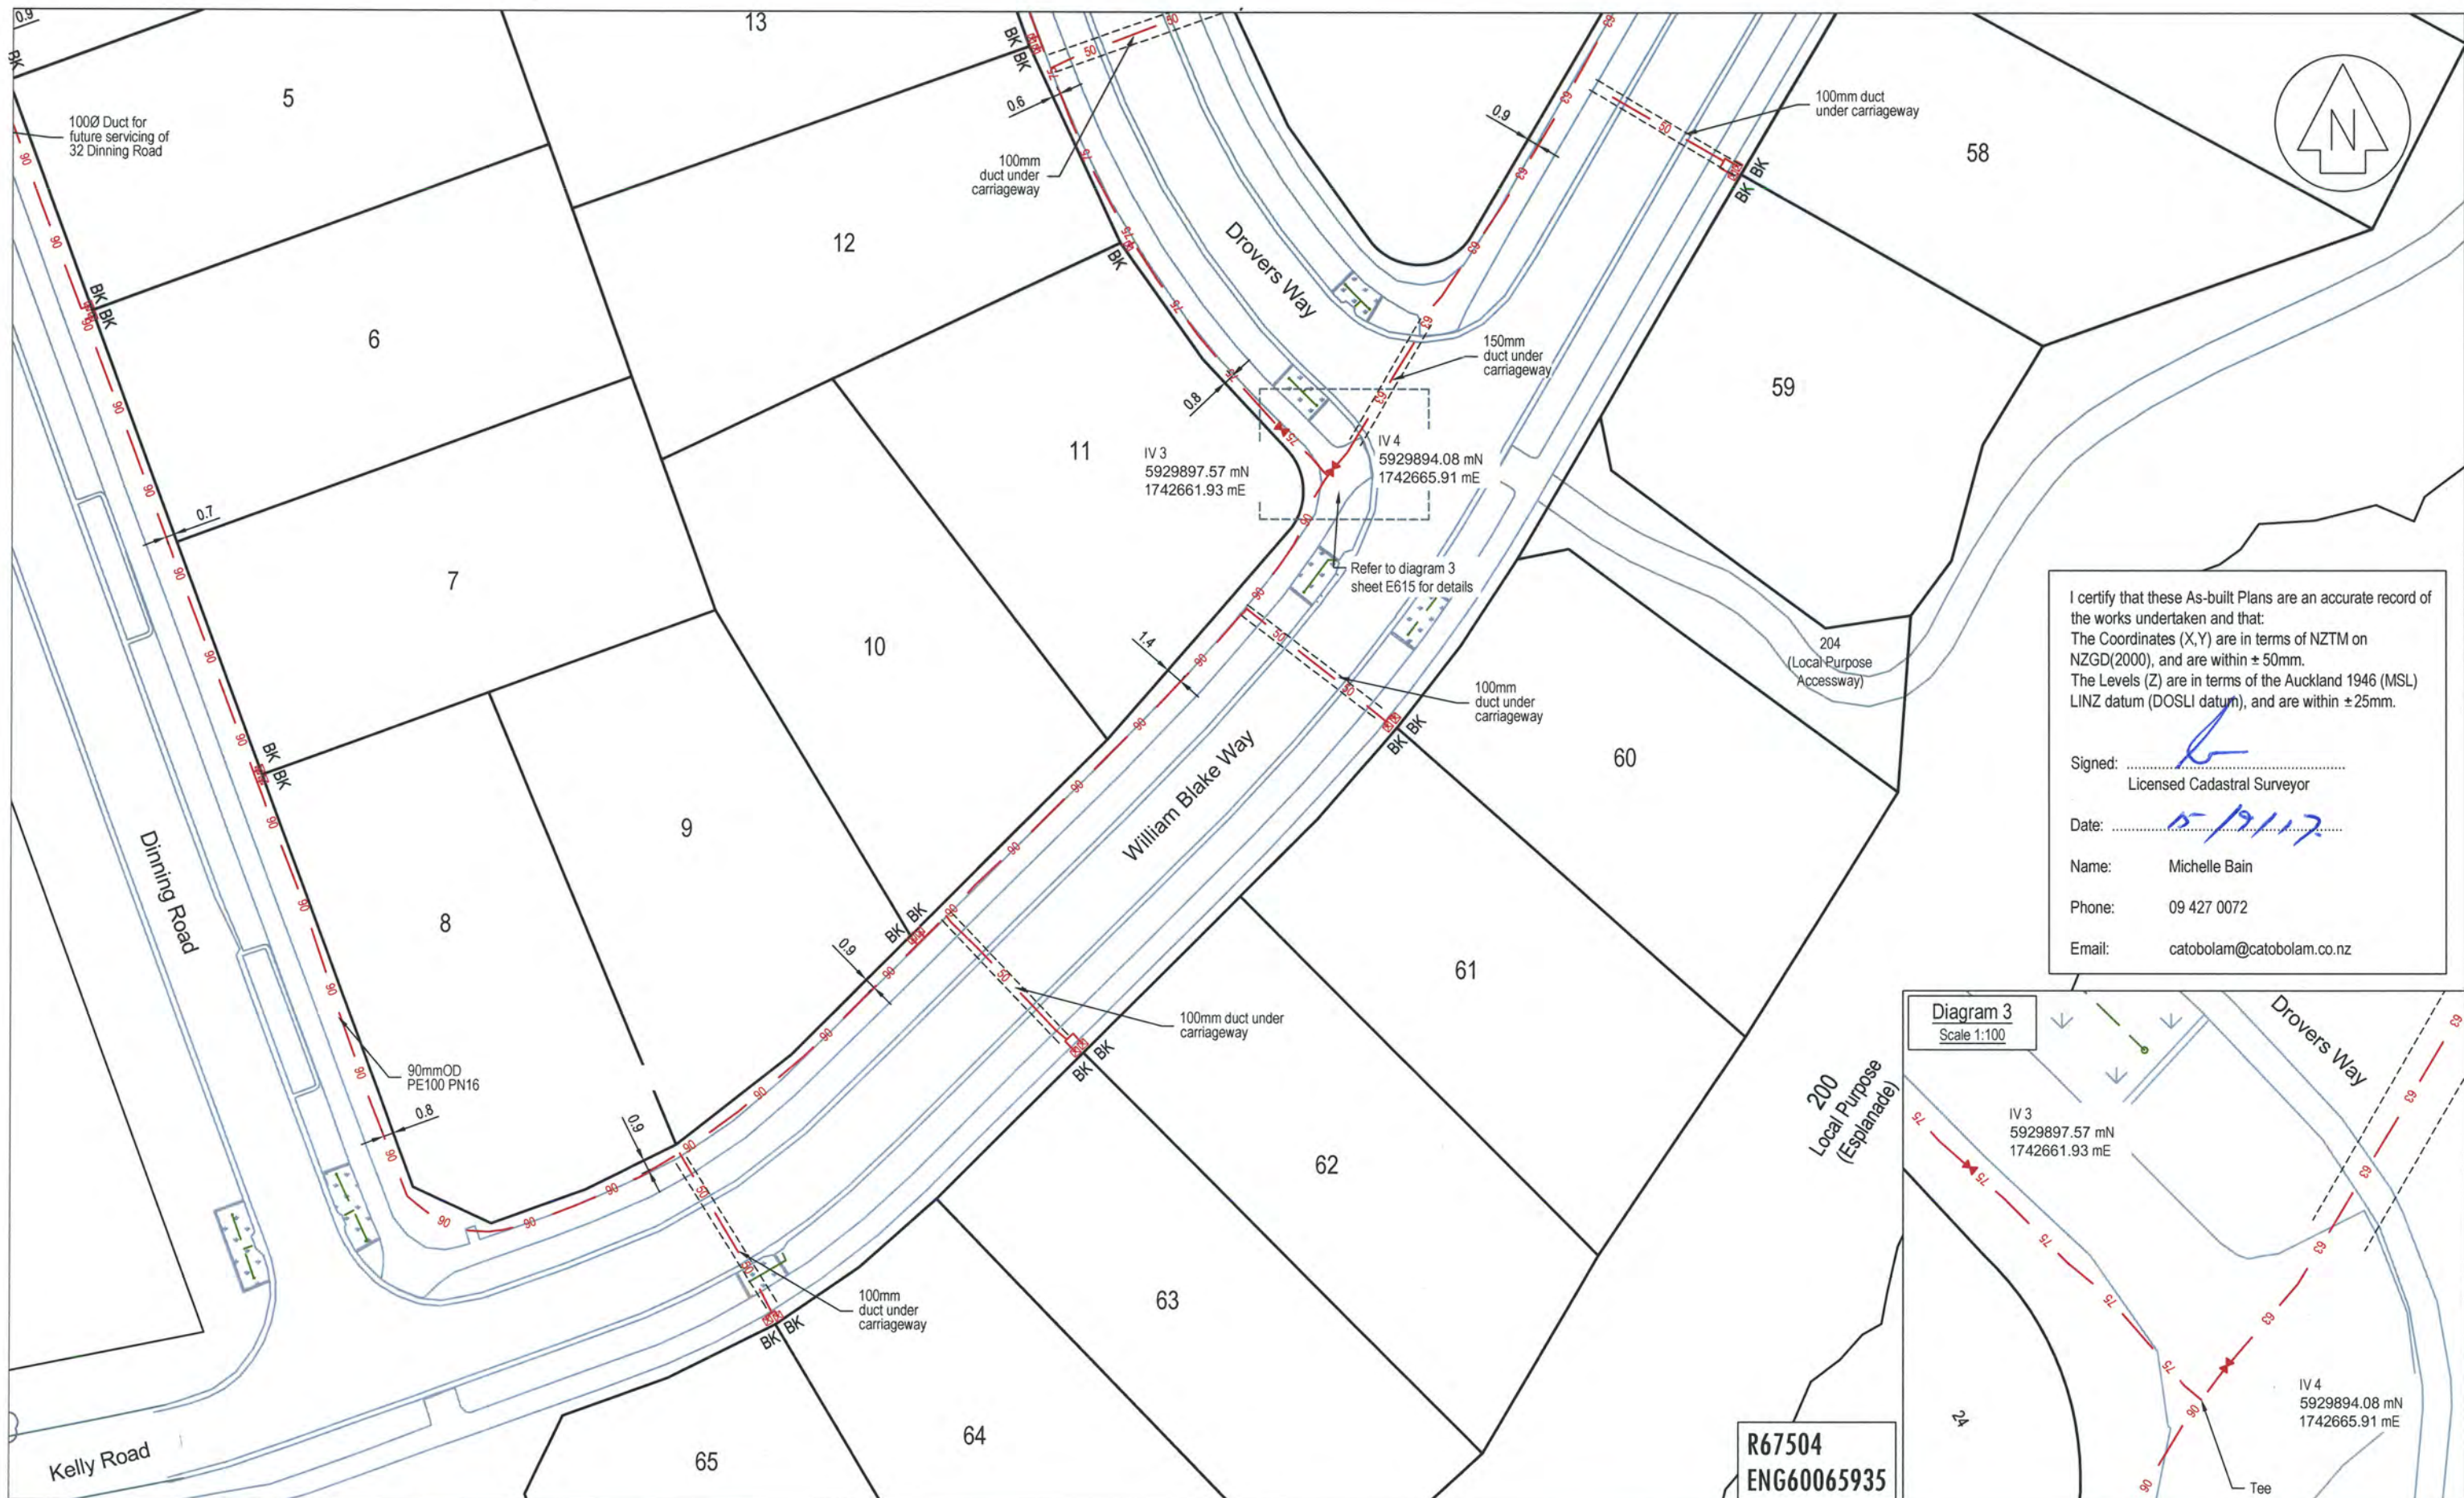


I certify that these As-built Plans are an accurate record of the works undertaken and that:
The Coordinates (X,Y) are in terms of NZTM on NZGD(2000), and are within $\pm 50\text{mm}$.
The Levels (Z) are in terms of the Auckland 1946 (MSL) LINZ datum (DOSLI datum), and are within $\pm 25\text{mm}$.

Signed: _____
Licensed Cadastral Surveyor

Date: 15/10/17

Name: Michelle Bain
Phone: 09 427 0072
Email: catobolam@catobolam.co.nz

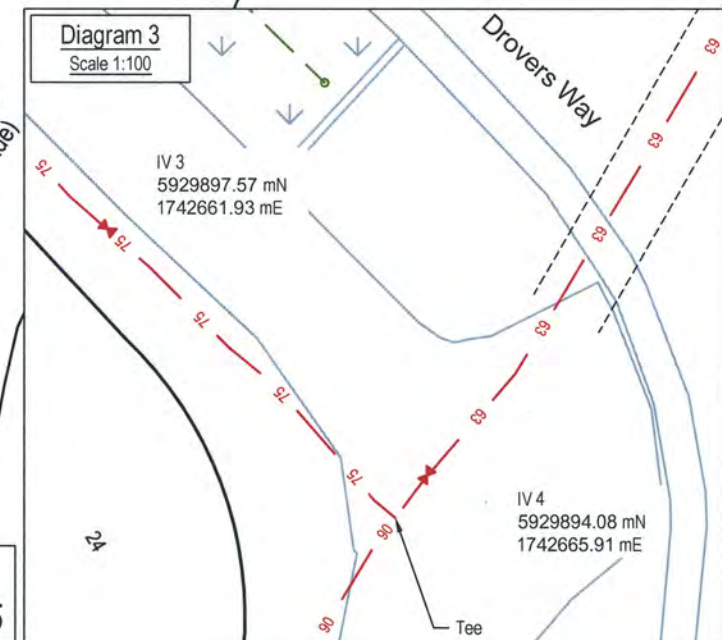

CATO BOLAM CONSULTANTS

PLANNERS | SURVEYORS | ENGINEERS | ENVIRONMENTAL

CATO BOLAM CONSULTANTS LTD
19 Tamariki Avenue
PO Box 157
Orewa 0946

phone 09-427 0072
fax 09-426 7331
email catobolam@catobolam.co.nz

REVISION (DESCRIPTIONS)	NAME	DATE
SURVEYED	LD	08/17
DESIGNED		
DRAWN	BJ	09/17
CHECKED	BM	09/17
APPROVED	TL	09/17

Refer to E613 for Drawing Legend and Notes

This plan and accompanying report(s) have been prepared for the purpose of obtaining a resource consent only and for no other purpose. Use of this plan and/or the information on it for any other purpose is at the user's risk


CLIENT

Cabra Developments Ltd
Deacon Point
Stages 1 & 2
Dinning Road, Riverhead

DRAWING TITLE

Wastewater Reticulation
As Built Plan
Sheet 3 of 5

This drawing and design remains the property of Cato Bolam Consultants Ltd and may not be reproduced without the written permission of Cato Bolam Consultants Ltd.	
ORIGINAL SCALE 1:500	ORIGINAL SIZE A3
DATE 10/09/2017	CAD REFERENCE 34147 E613-E617 Sewer Retic
DIRECTORY Z:\34147\ACAD\As Built Stage 1 and 2	REVISION NO SHEET NO JOB NO
	E615 34147

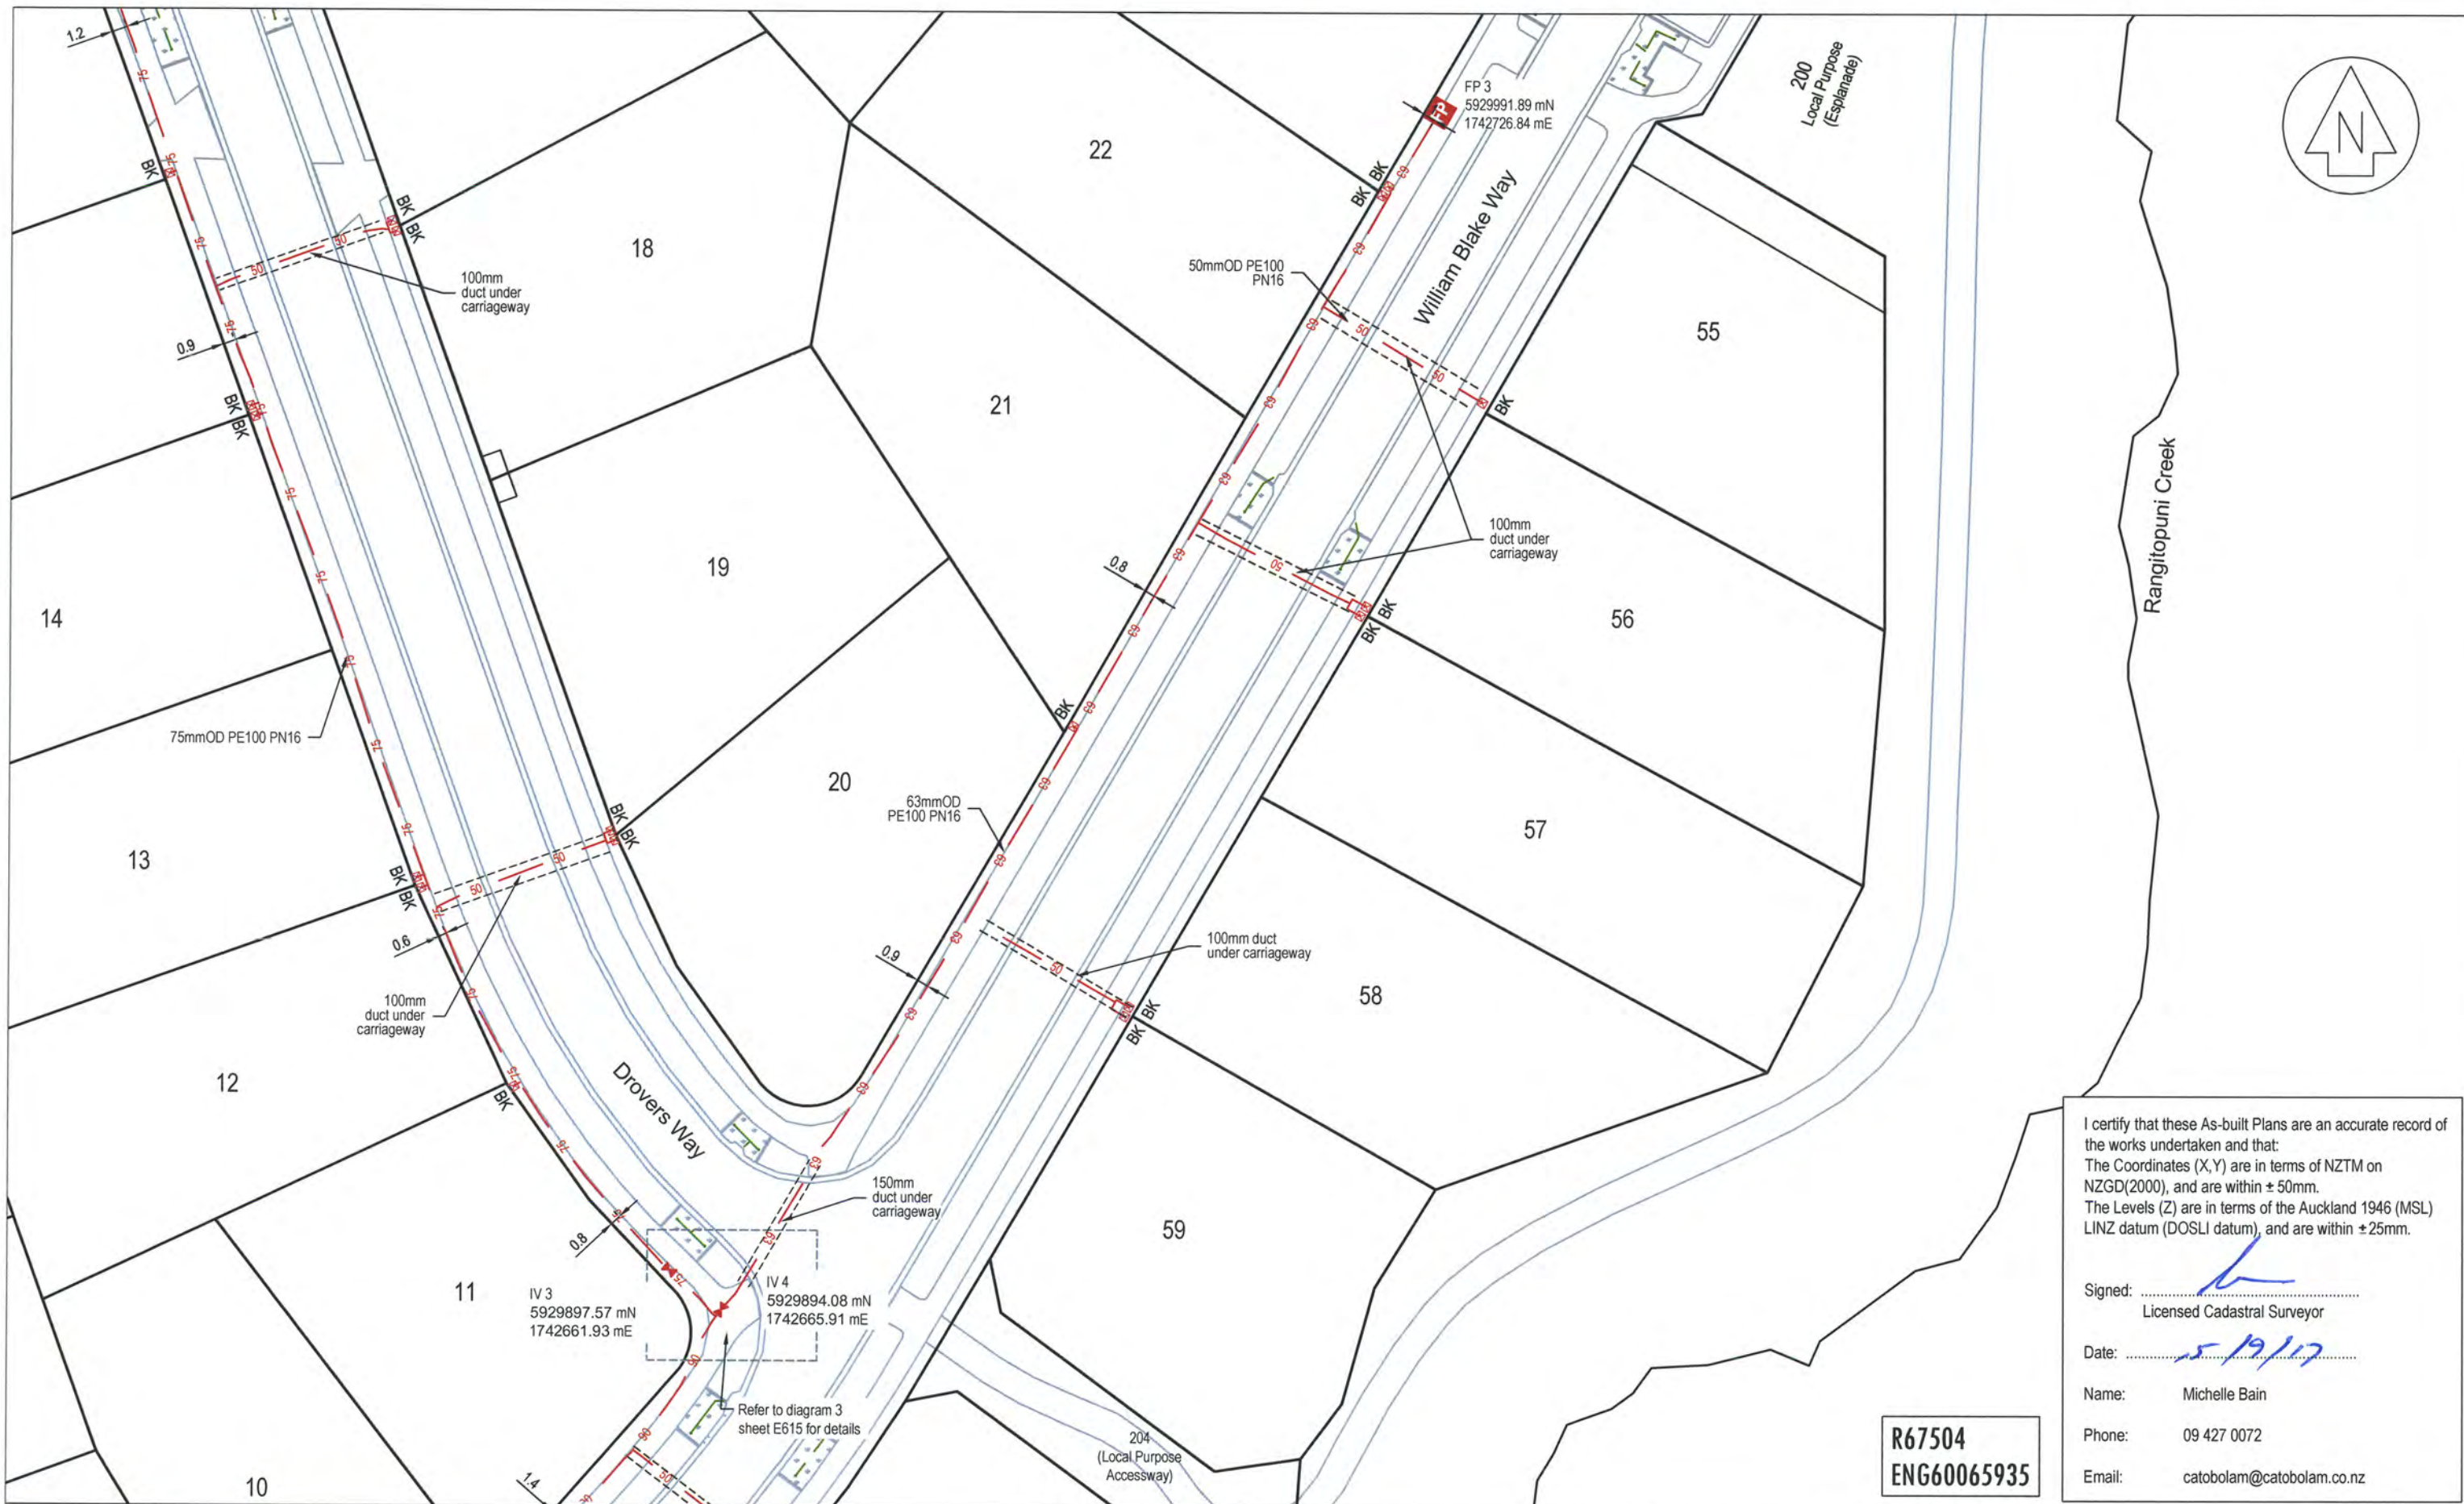

I certify that these As-built Plans are an accurate record of the works undertaken and that:
The Coordinates (X,Y) are in terms of NZTM on NZGD(2000), and are within $\pm 50\text{mm}$.
The Levels (Z) are in terms of the Auckland 1946 (MSL) LINZ datum (DOSLI datum), and are within $\pm 25\text{mm}$.

Signed: _____
Licensed Cadastral Surveyor

Date: 5/19/17

Name: Michelle Bain

Phone: 09 427 0072

Email: catobolam@catobolam.co.nz

R67504
ENG60065935

CATO BOLAM CONSULTANTS

PLANNERS | SURVEYORS | ENGINEERS | ENVIRONMENTAL

CATO BOLAM CONSULTANTS LTD
19 Tamariki Avenue
PO Box 157
Orewa 0946

phone 09-427 0072
fax 09-426 7331
email catobolam@catobolam.co.nz

REVISION (DESCRIPTIONS)	NAME	DATE
SURVEYED	LD	08/17
DESIGNED		
DRAWN	BJ	09/17
CHECKED	BM	09/17
APPROVED	TL	09/17

Refer to E613 for Drawing Legend and Notes

This plan and accompanying report(s) have been prepared for the purpose of obtaining a resource consent only and for no other purpose. Use of this plan and/or the information on it for any other purpose is at the user's risk


CLIENT

Cabra Developments Ltd
Deacon Point
Stages 1 & 2
Dinning Road, Riverhead


DRAWING TITLE

Wastewater Reticulation
As Built Plan
Sheet 4 of 5

This drawing and design remains the property of Cato Bolam Consultants Ltd and may not be reproduced without the written permission of Cato Bolam Consultants Ltd.	
ORIGINAL SCALE 1:500	ORIGINAL SIZE A3
DATE 10/09/2017	CAD REFERENCE 34147 E613-E617 Sewer Retic
DIRECTORY Z:\34147\ACAD\As Built Stage 1 and 2	
REVISION NO	SHEET NO E616
	JOB NO 34147

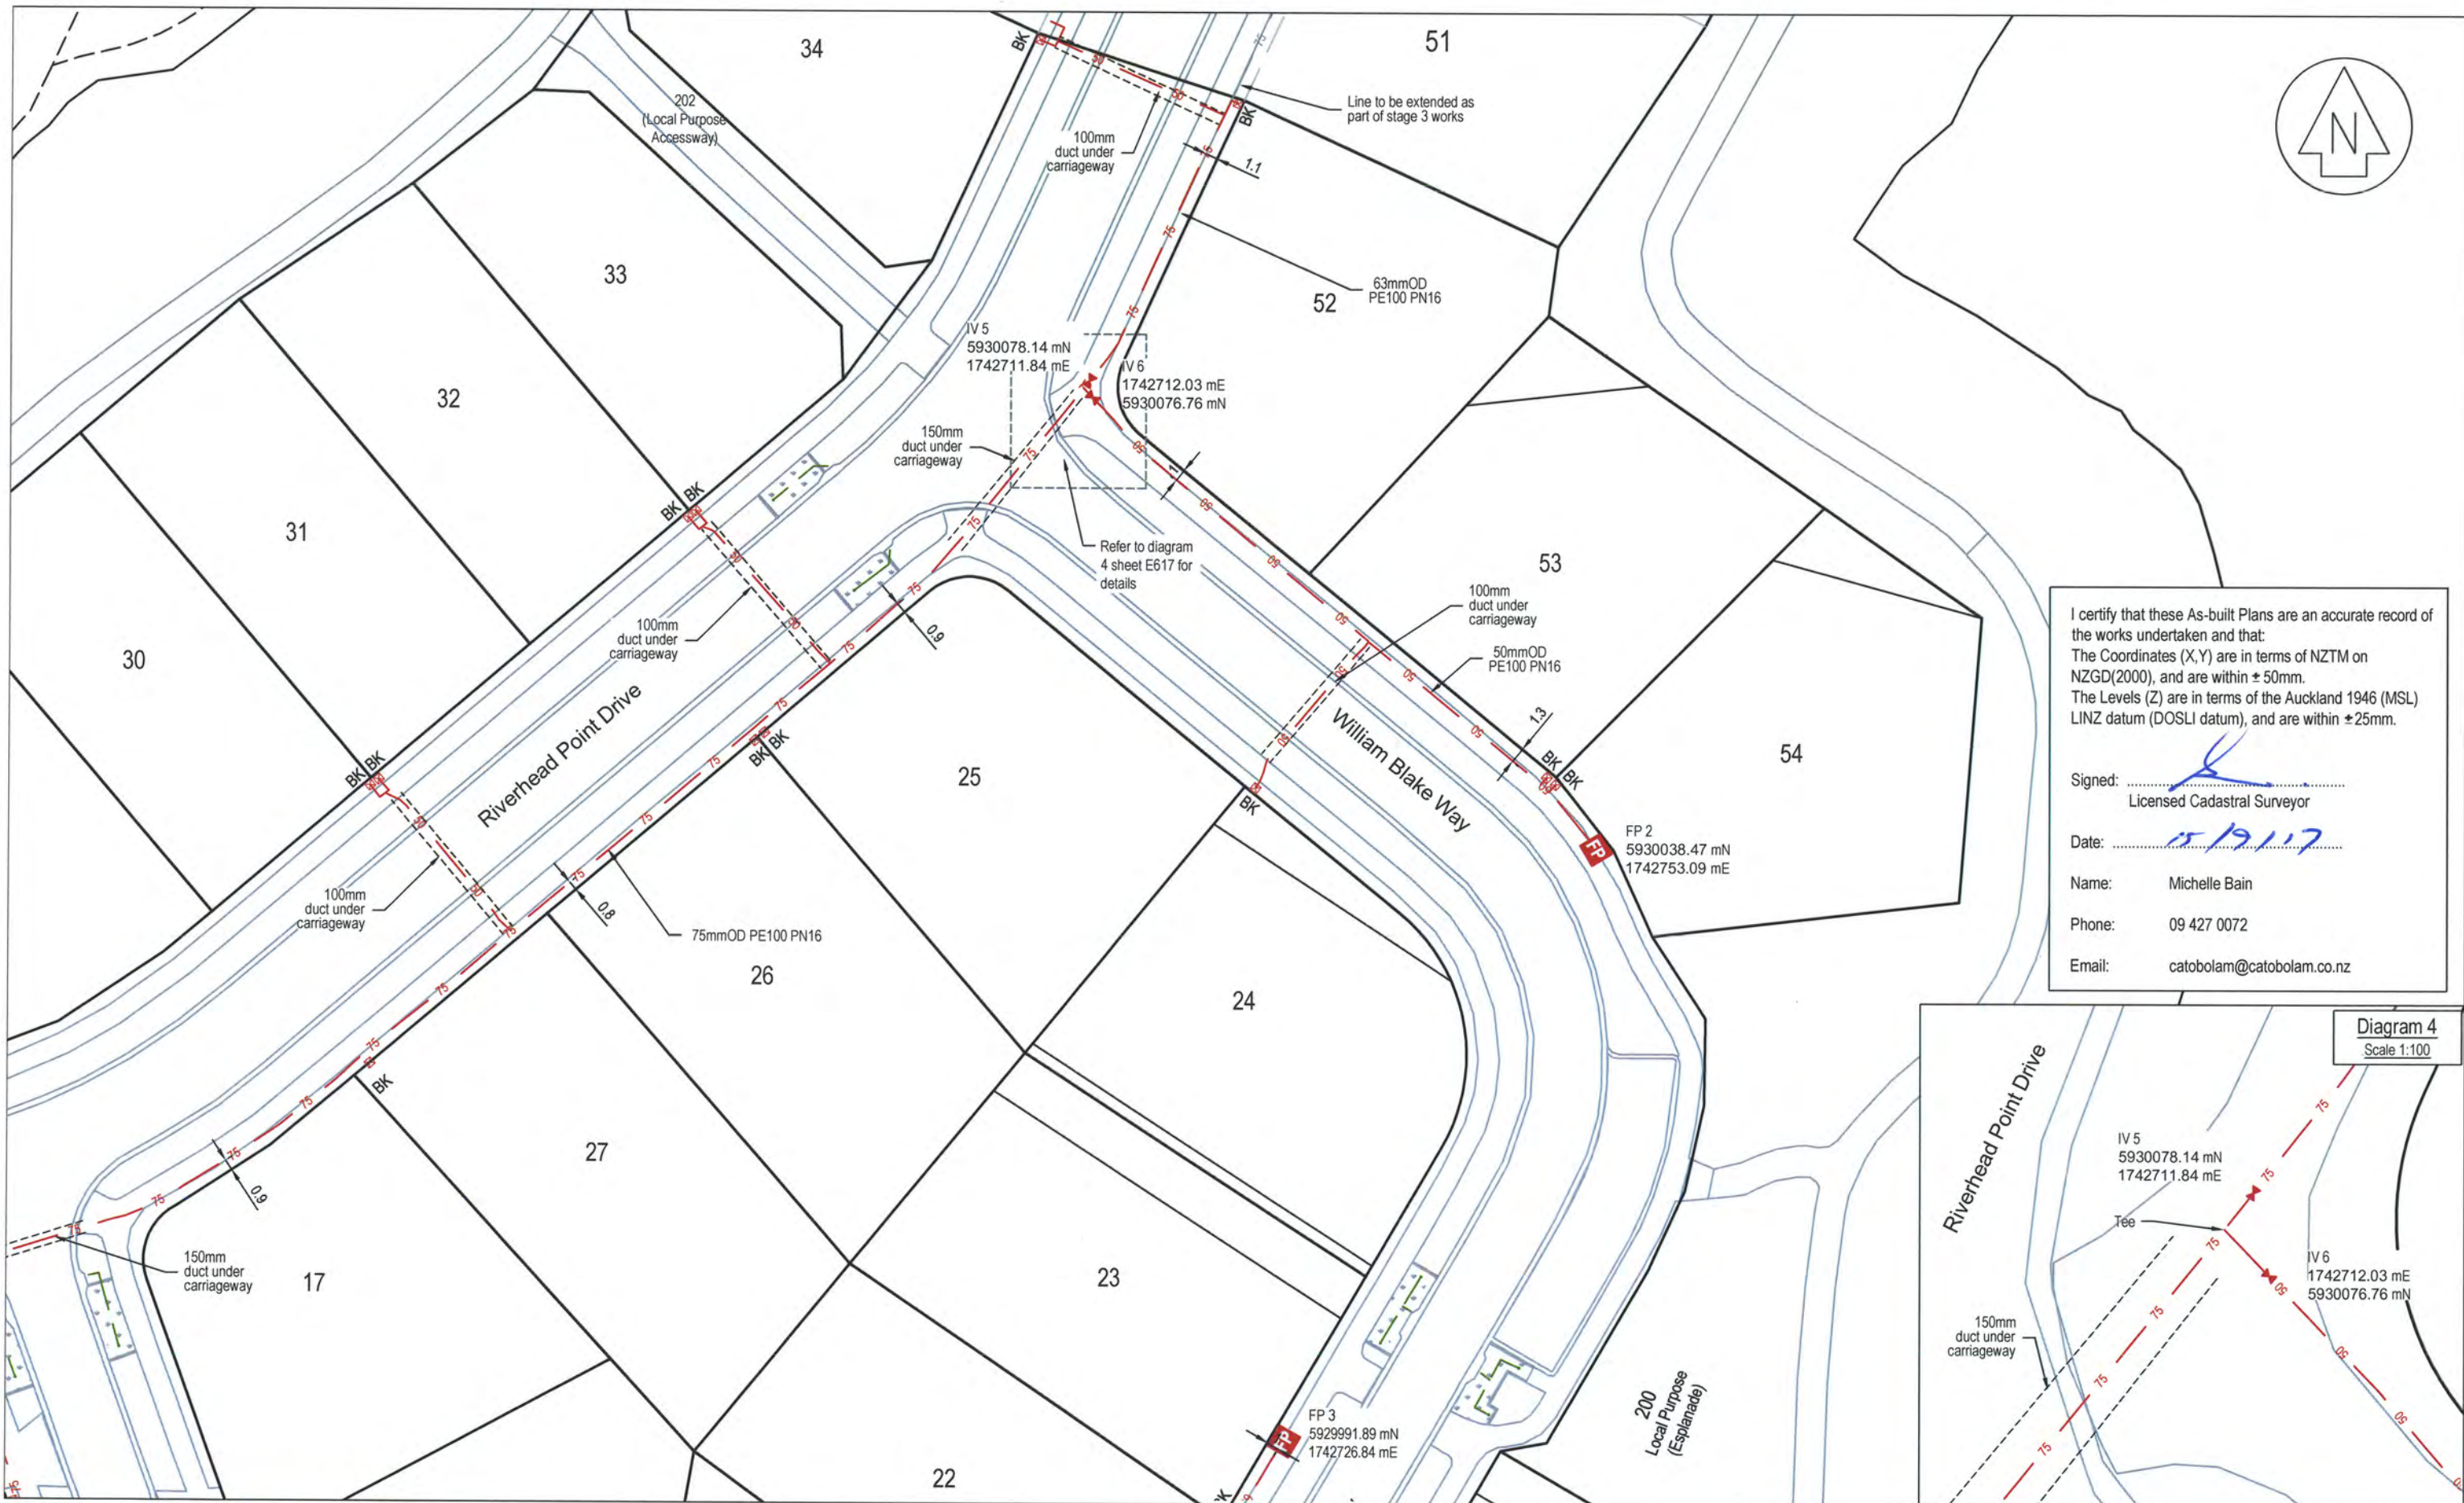

I certify that these As-built Plans are an accurate record of the works undertaken and that:
The Coordinates (X,Y) are in terms of NZTM on NZGD(2000), and are within $\pm 50\text{mm}$.
The Levels (Z) are in terms of the Auckland 1946 (MSL) LINZ datum (DOSLI datum), and are within $\pm 25\text{mm}$.

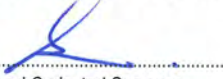
Signed: 
Licensed Cadastral Surveyor

Date: 15/12/17

Name: Michelle Bain

Phone: 09 427 0072

Email: catobolam@catobolam.co.nz

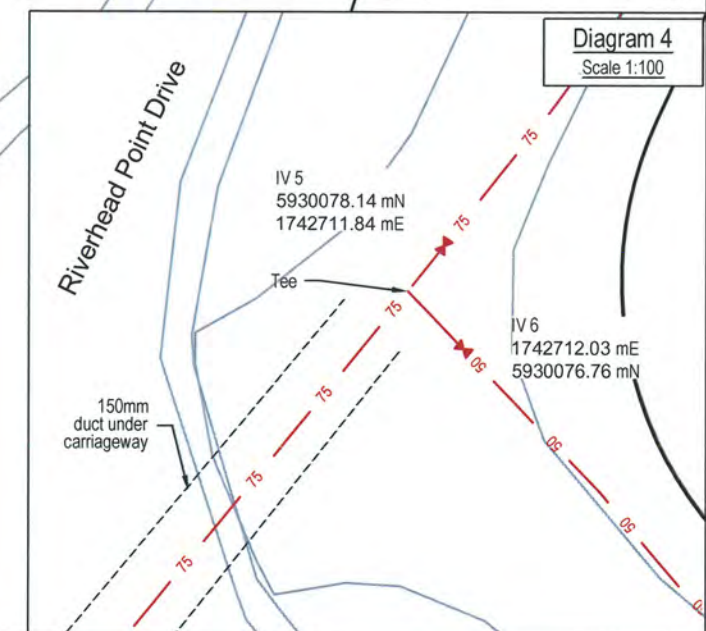

CATO BOLAM CONSULTANTS

PLANNERS | SURVEYORS | ENGINEERS | ENVIRONMENTAL

CATO BOLAM CONSULTANTS LTD
19 Tamariki Avenue
PO Box 157
Orewa 0946

phone 09-427 0072
fax 09-426 7331
email catobolam@catobolam.co.nz

REVISION (DESCRIPTIONS)	NAME	DATE
SURVEYED	LD	08/17
DESIGNED		
DRAWN	BJ	09/17
CHECKED	BM	09/17
APPROVED	TL	09/17

Refer to E613 for Drawing Legend and Notes

This plan and accompanying report(s) have been prepared for the purpose of obtaining a resource consent only and for no other purpose. Use of this plan and/or the information on it for any other purpose is at the user's risk

CLIENT

Cabra Developments Ltd
Deacon Point
Stages 1 & 2, Dinning Road
Riverhead

DRAWING TITLE


Wastewater Reticulation
As Built Plan
Sheet 5 of 5

This drawing and design remains the property of Cato Bolam Consultants Ltd and may not be reproduced without the written permission of Cato Bolam Consultants Ltd.

ORIGINAL SCALE 1:500	ORIGINAL SIZE A3	REVISION NO
DATE 10/09/2017	CAD REFERENCE 34147 E613-E617 Sewer Retic	SHEET NO E617
DIRECTORY Z:\34147\ACAD\As Built Stage 1 and 2		JOB NO 34147

NZTM Manhole Co-ordinates Table			NZTM Catchpit Co-ordinates Table		
Name	mN	mE	Name	mN	mE
A-4	5930078.1	1742716.7	CP 1	5929994.1	1742528.6
A-5	5930082.9	1742694.4	CP 2	5929993.3	1742521.8
A-6	5930030	1742629.9	CP 4	5929884.9	1742673.8
A-7	5930023.7	1742613.3	CP 5	5929832.2	1742577
A-8	5930025.5	1742594.1	CP 6	5929833.7	1742583.6
A-9	5930031.3	1742563.6	CP 7	5929831	1742619.3
A-10	5930022.1	1742532.9	CP 8	5929901.3	1742664.5
A-11	5930006.3	1742533.2	CP 9	5929907.2	1742667.6
A-12	5929943	1742554.7	CP 10	5930009.9	1742611.5
A-13	5929934.5	1742534	CP11	5930017.3	1742611.2
F-1	5930060.2	1742699.2	CP 12	5930003	1742622.4
F-2	5930036.2	1742670.4	CP 13	5930005.4	1742628.4
G-1	5930014.6	1742632	CP 16	5930070.9	1742690.5
G-2	5929982.9	1742643.4	CP 17	5930064.9	1742694.7
G-3	5929971.4	1742631.5	CP 23	5929886.7	1742667
H-2	5930011.8	1742586.5	CP 24	5929957.8	1742718.4
I-1	5929992.9	1742512.3	CP 25	5929961.0	1742713.0
J-2	5929998	1742767.2	CP 14	5930000.0	1742736.7
J-3	5929986.9	1742744.2	CP 14/1	5930001.0	1742737.3
J-4	5929900.9	1742691.9	CP 15	5929997.5	1742742.6
J-5	5929880.6	1742679.5	CP 15/1	5929997.5	1742742.6
J-6	5929860	1742661	CP 26	5930051.7	1742502.1
J-7	5929829.1	1742628.1	CP 26/1	5930050.8	1742502.5
J-8	5929842.2	1742611.8			
J-9	5929837.5	1742590.9			
J-10	5929907.8	1742566.7			
K-1	5930025.3	1742764.1			
L-1	5929997.5	1742727.6			
L-2	5929970.9	1742711			
M-1	5929911.7	1742673.2			
M-2	5929928.8	1742661.3			
M-3	5929929.2	1742645.6			
N-1	5929870.6	1742651			

NOTES
GENERAL
1. Levels are in terms of LINZ Datum 1946.
2. Coordinates are in terms of NZTM.
3. All infrastructure is public unless otherwise shown.
STORMWATER
1. All pipes are Class 4 reinforced concrete rubber ring jointed (RCRRJ), unless otherwise shown.
2. All manholes are 1050mmØ concrete flange base and riser, unless otherwise shown.
2. Bedding is H2 type unless otherwise stated.
3. All catchpits are 675mm x 450mm steel grate lids semi recessed unless otherwise shown.
4. All lot connections are 100Ø uPVC SEH-C unless otherwise stated.
5. All 150Ø pipes are uPVC SEH-C SN16.
6. Wall drain outlets to be connected to private drainage at building consent stage.

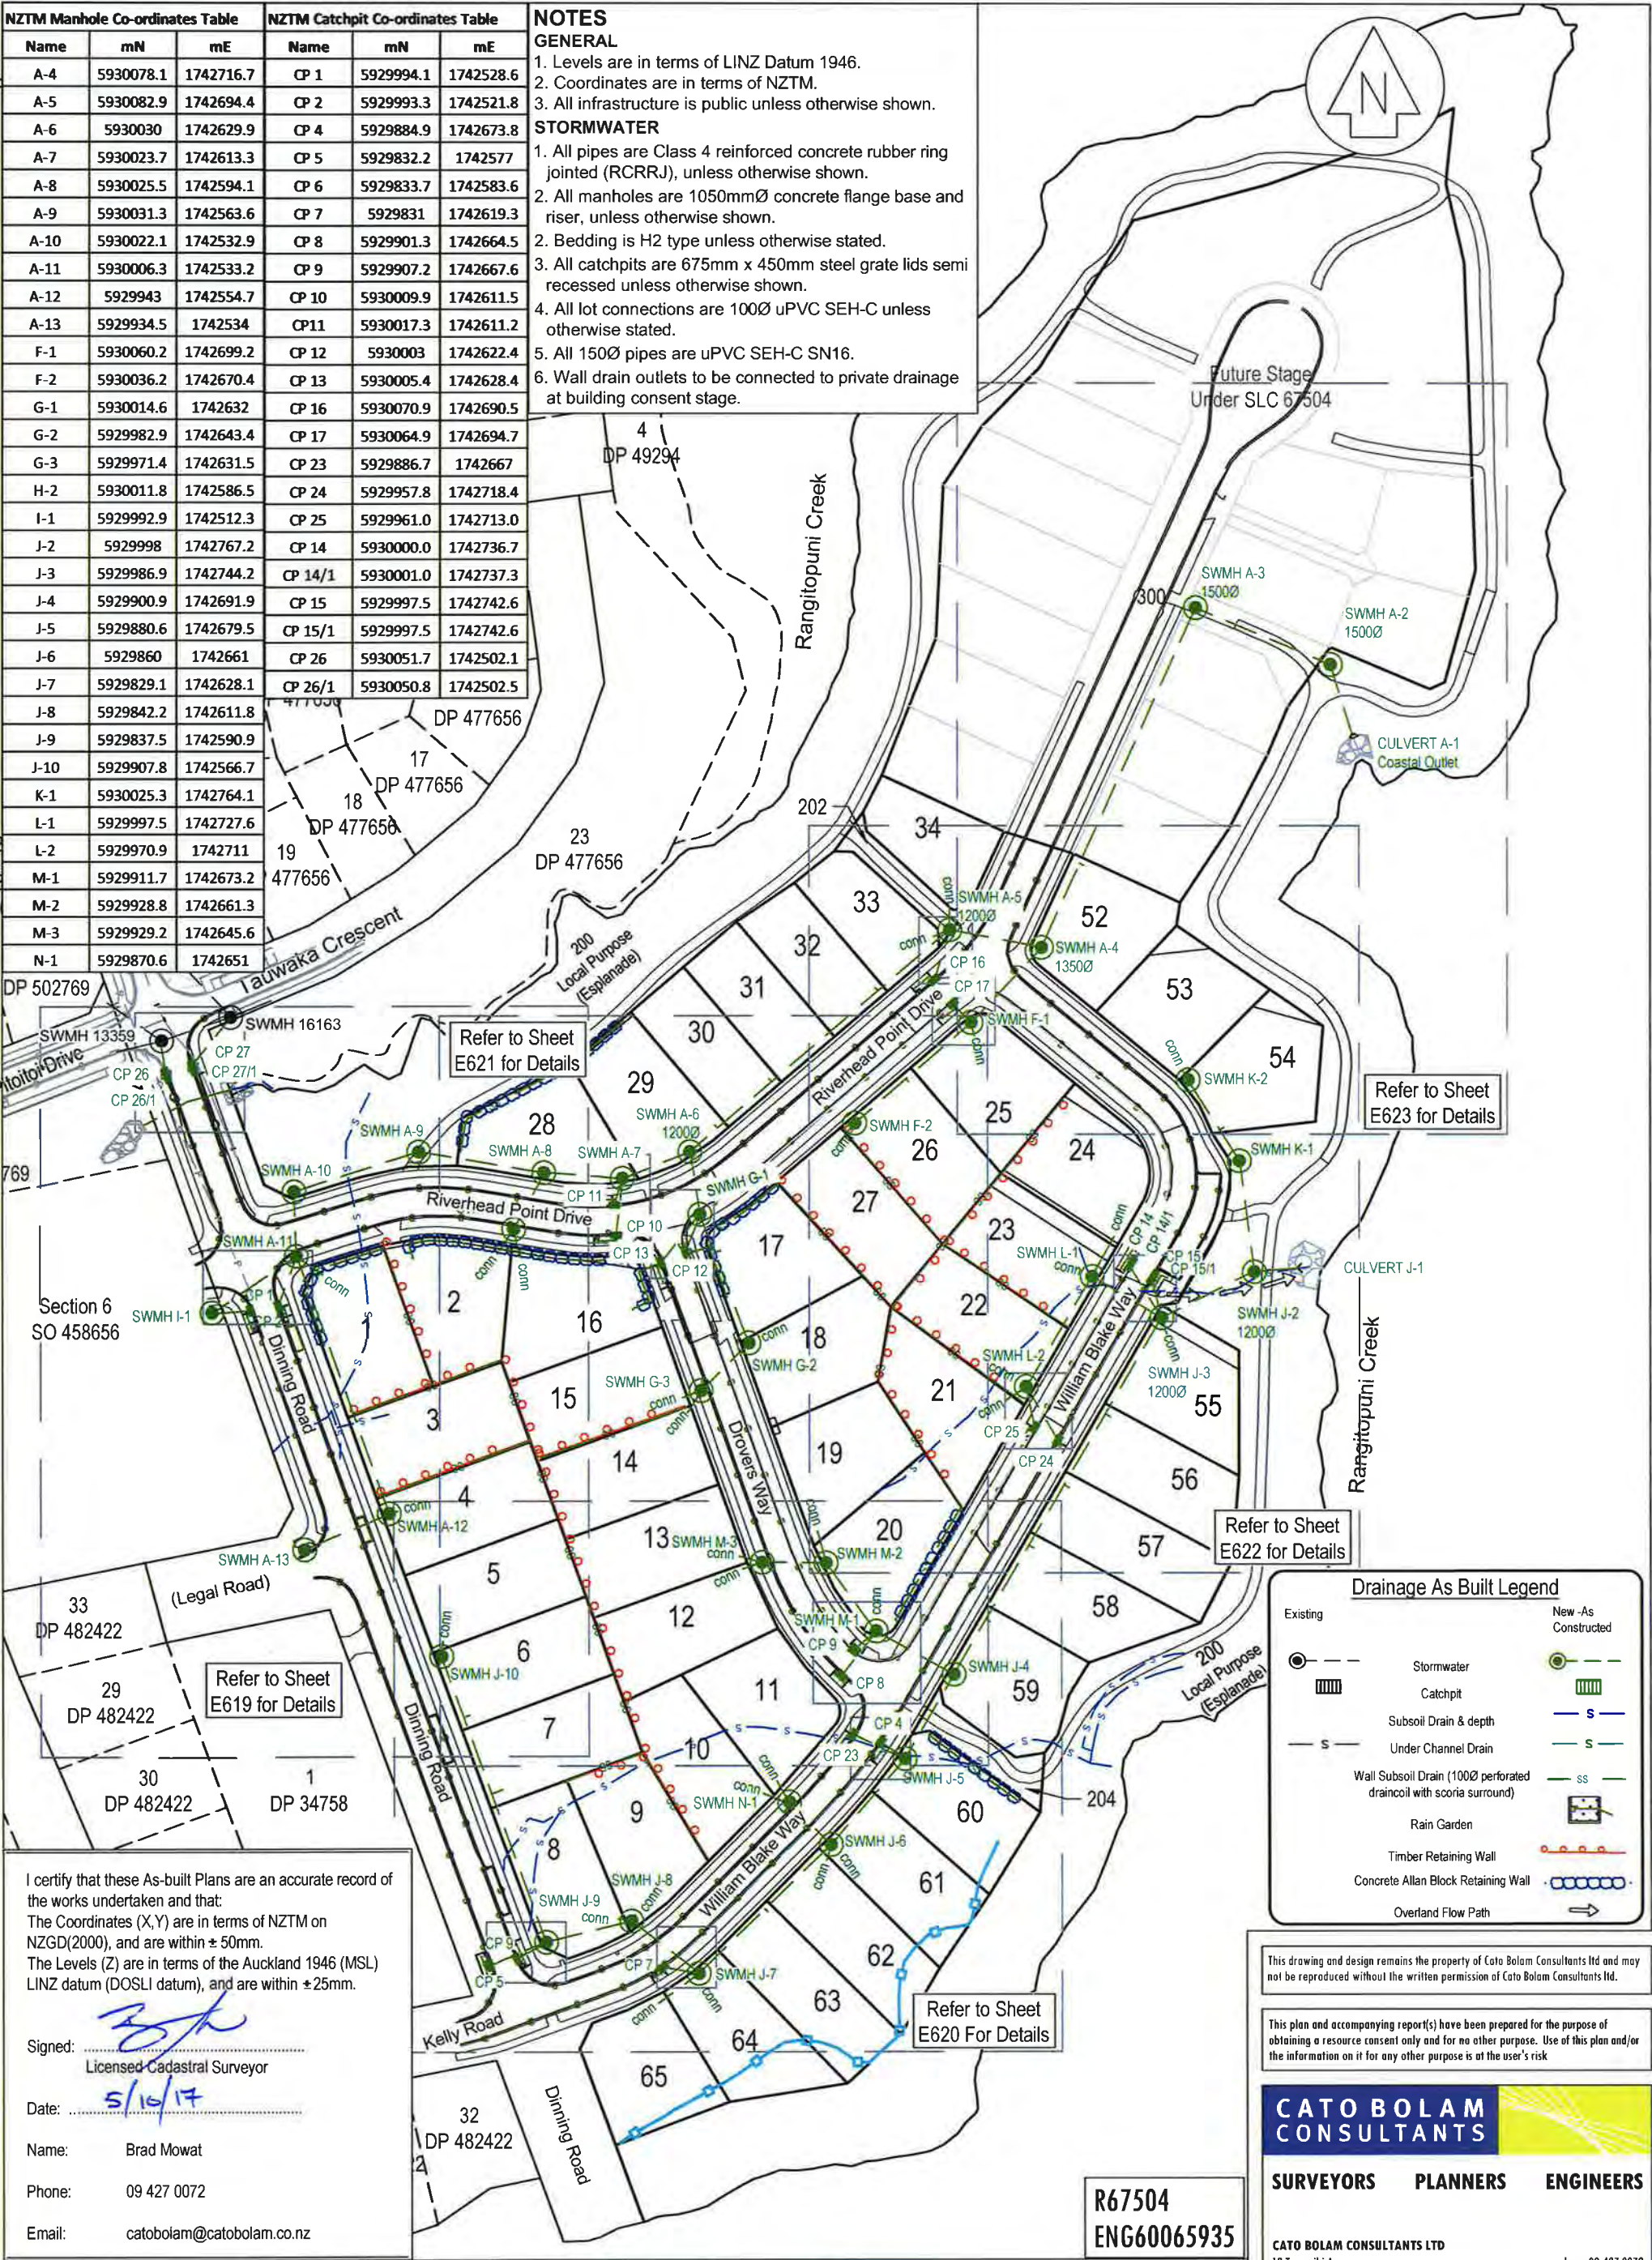

I certify that these As-built Plans are an accurate record of the works undertaken and that:
The Coordinates (X,Y) are in terms of NZTM on NZGD(2000), and are within ± 50mm.
The Levels (Z) are in terms of the Auckland 1946 (MSL) LINZ datum (DOSLI datum), and are within ± 25mm.

Signed: 
Licensed Cadastral Surveyor

Date: 5/10/17

Name: Brad Mowat

Phone: 09 427 0072

Email: catobolam@catobolam.co.nz

Drainage As Built Legend	
Existing	New - As Constructed
	
	
	
	
	
	
	
	

This drawing and design remains the property of Cato Bolam Consultants Ltd and may not be reproduced without the written permission of Cato Bolam Consultants Ltd.

This plan and accompanying report(s) have been prepared for the purpose of obtaining a resource consent only and for no other purpose. Use of this plan and/or the information on it for any other purpose is at the user's risk

CATO BOLAM CONSULTANTS

SURVEYORS PLANNERS ENGINEERS




CATO BOLAM CONSULTANTS LTD
19 Tamariki Avenue
PO Box 157
Orewa 0946
phone 09-427 0072
fax 09-426 7331
email catobolam@catobolam.co.nz

REVISION (DESCRIPTIONS)	NAME	DATE
SURVEYED	LD & AA	09/17
DESIGNED		
DRAWN	BJ	10/17
CHECKED	BM	09/17
APPROVED	TL	09/17

CLIENT
Cabra Developments Ltd
Deacon Point
Stages 1 & 2
Dinning Road, Riverhead

DRAWING TITLE
Stormwater Reticulation
As Built Plan
Sheet 1 of 6

ORIGINAL SCALE 1:1500	ORIGINAL SIZE A3	REVISION NO R2
DATE 04/10/17	CAD REFERENCE 34147 E618-E623	SHEET NO E618
DIRECTORY Z:\34147\ACAD\AsBuilt\		JOB NO 34147

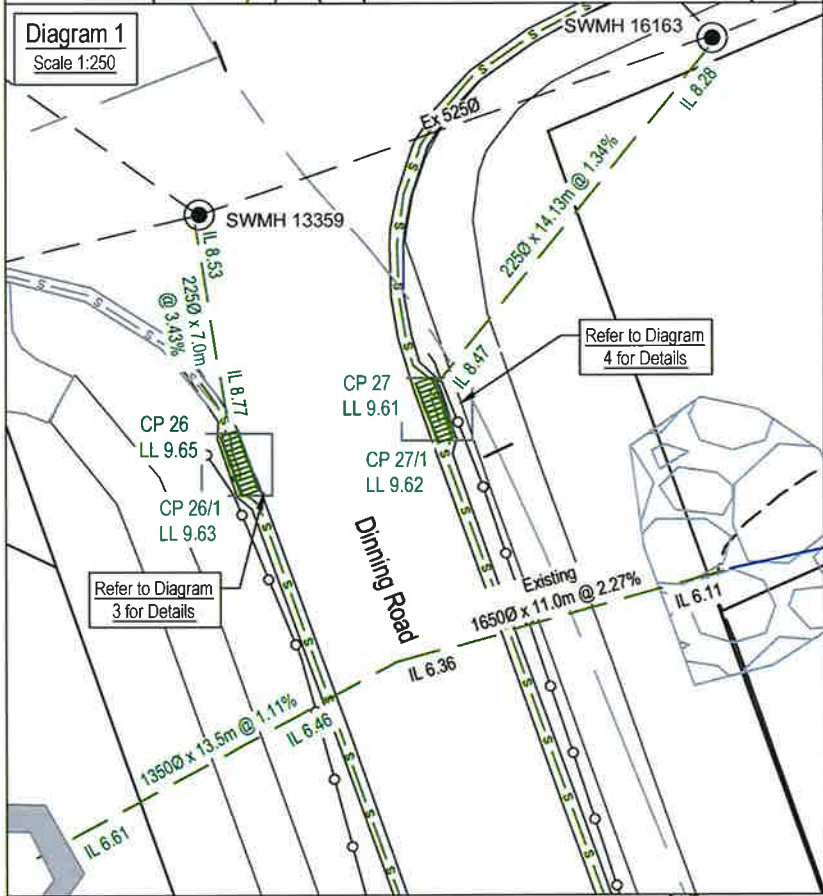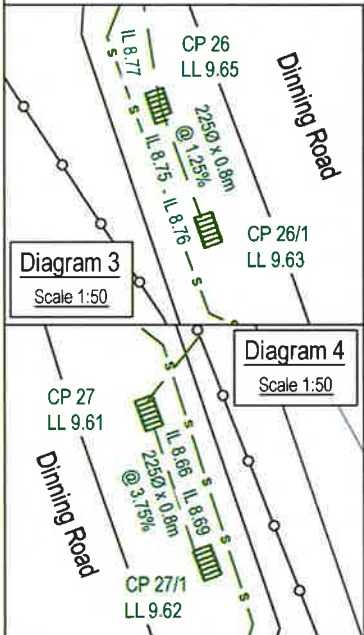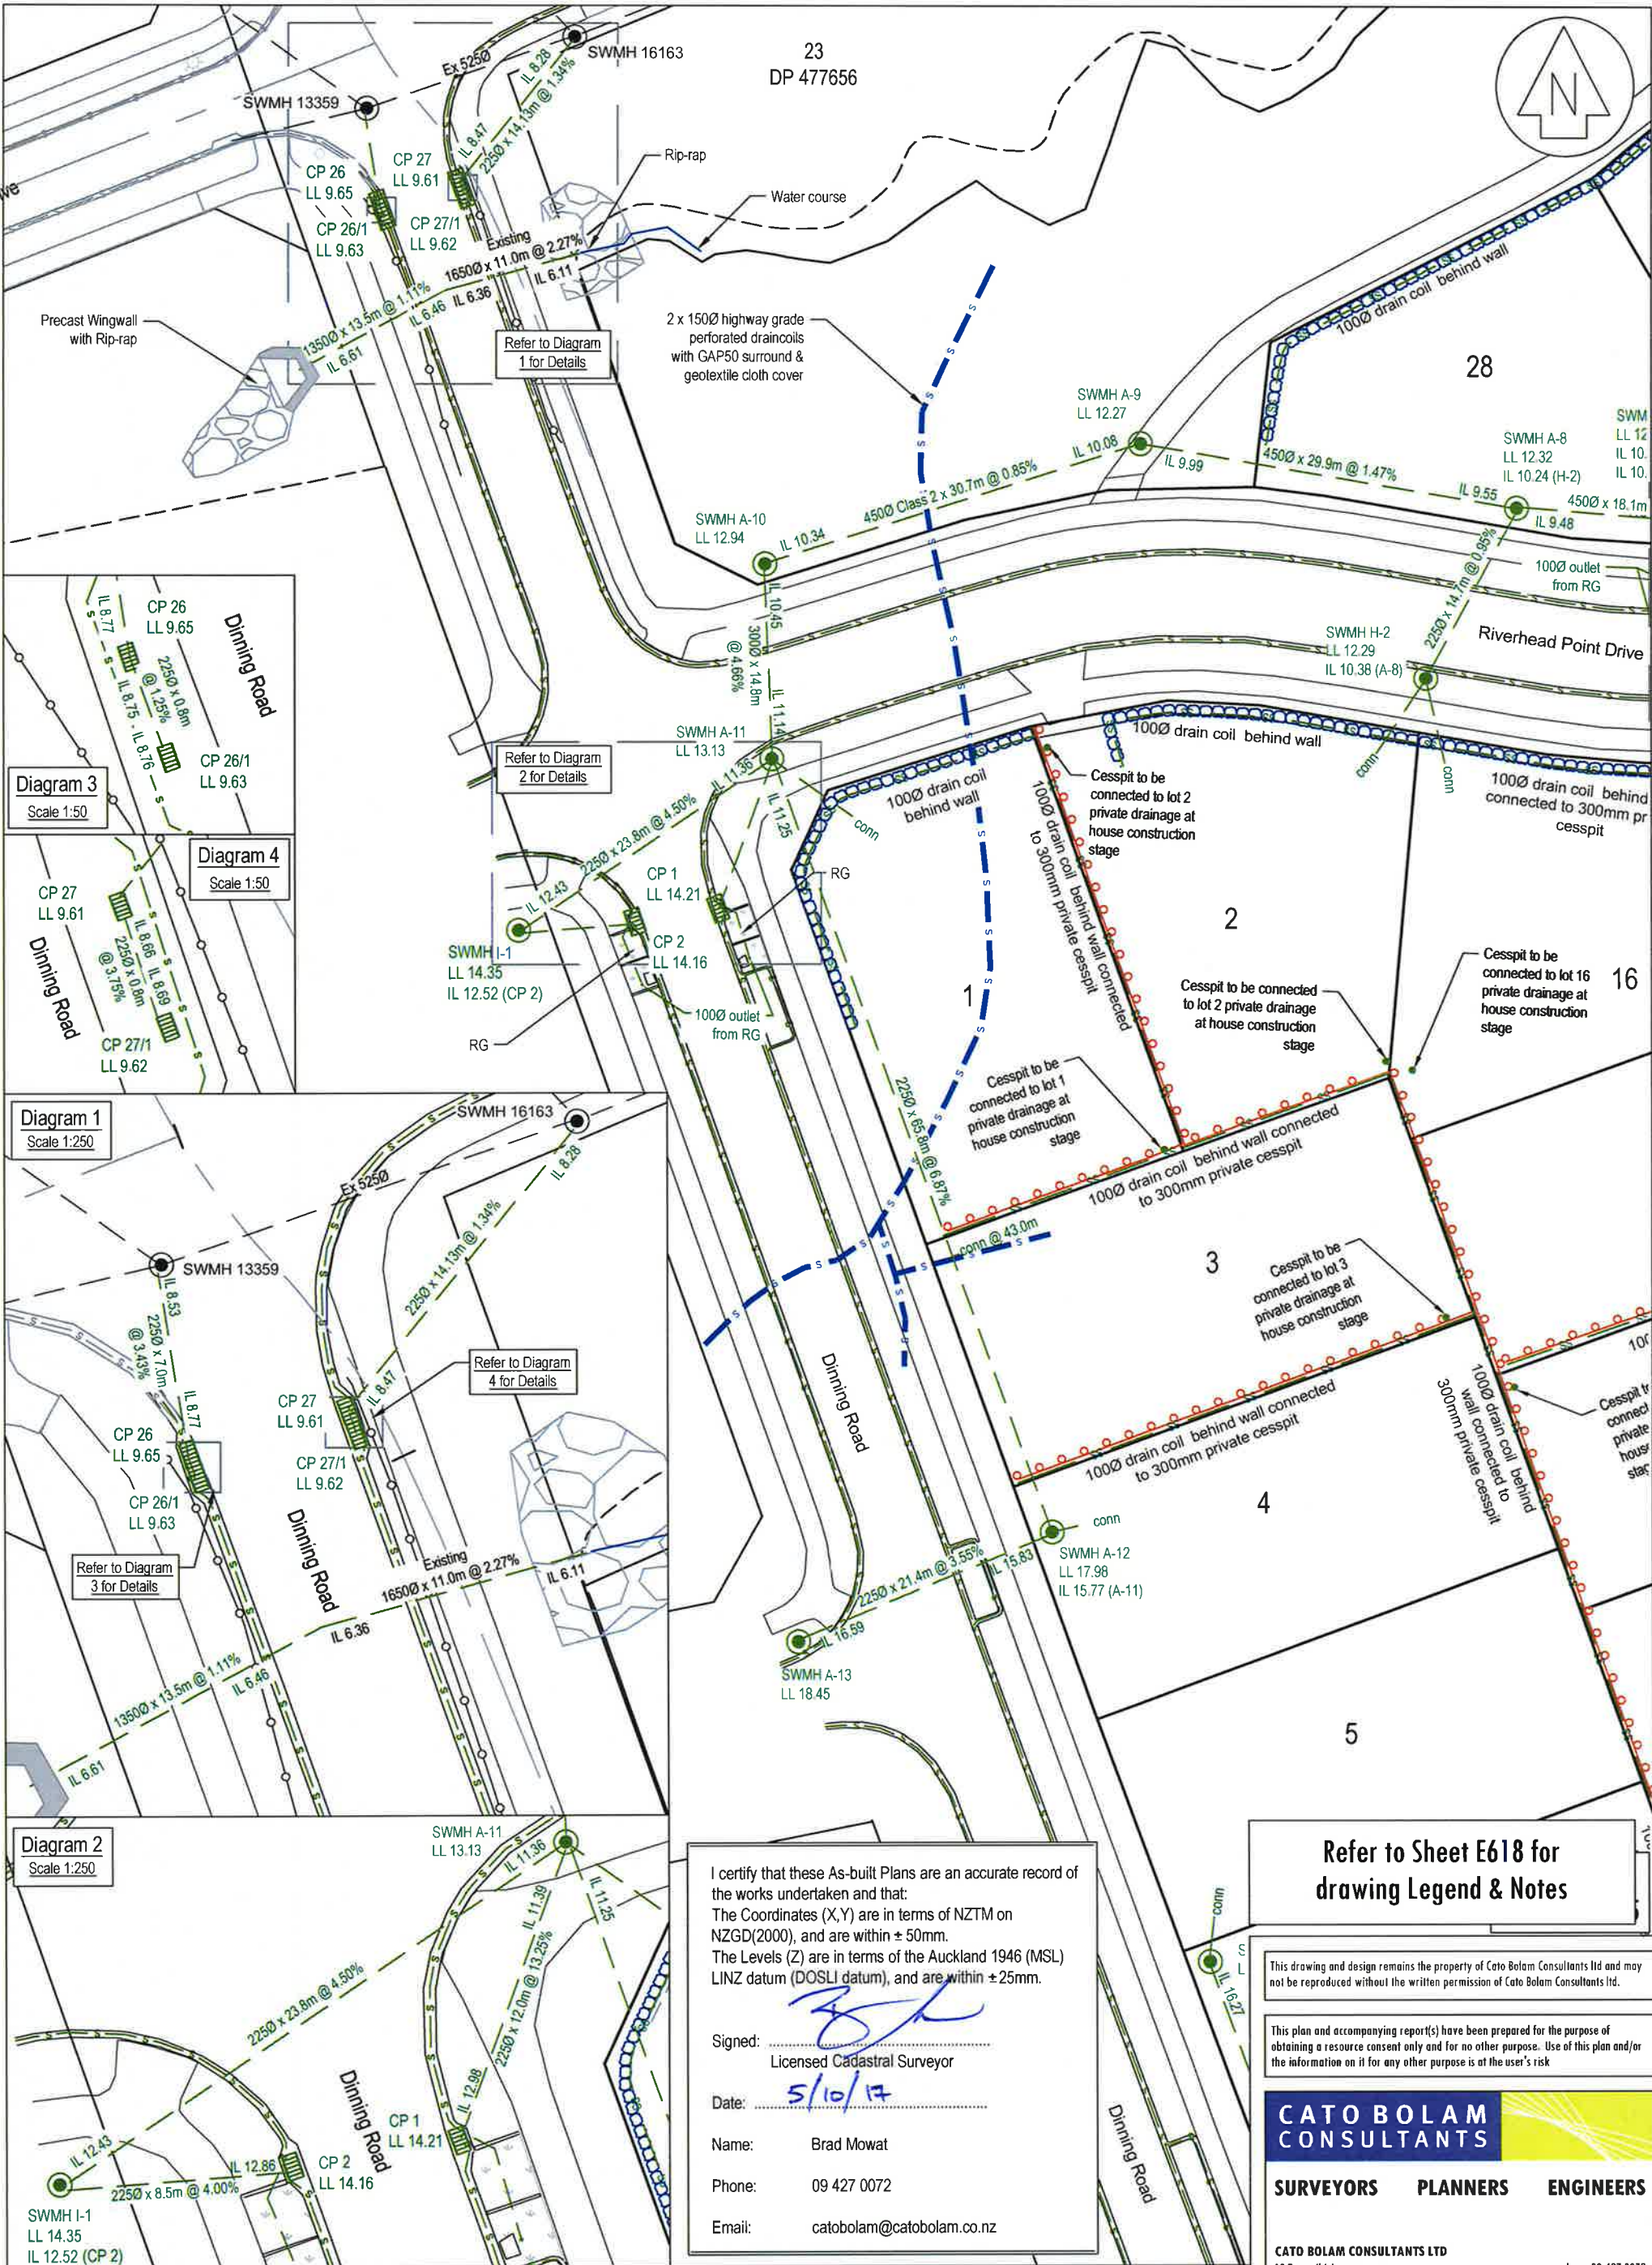

I certify that these As-built Plans are an accurate record of the works undertaken and that:
The Coordinates (X,Y) are in terms of NZTM on NZGD(2000), and are within ± 50mm.
The Levels (Z) are in terms of the Auckland 1946 (MSL) LINZ datum (DOSLI datum), and are within ± 25mm.

Signed:
Licensed Cadastral Surveyor

Date: 5/10/17

Name: Brad Mowat
Phone: 09 427 0072
Email: catobolam@catobolam.co.nz

Refer to Sheet E618 for drawing Legend & Notes

This drawing and design remains the property of Cato Bolam Consultants Ltd and may not be reproduced without the written permission of Cato Bolam Consultants Ltd.

This plan and accompanying report(s) have been prepared for the purpose of obtaining a resource consent only and for no other purpose. Use of this plan and/or the information on it for any other purpose is at the user's risk

CATO BOLAM CONSULTANTS

SURVEYORS PLANNERS ENGINEERS


CATO BOLAM CONSULTANTS LTD
19 Tamariki Avenue
PO Box 157
Drewham 0946
phone 09-427 0072
fax 09-426 7331
email catobolam@catobolam.co.nz

REVISION (DESCRIPTIONS)	NAME	DATE
SURVEYED	LD & AA	09/17
DESIGNED	RI	10/17
DRAWN	BM	09/17
CHECKED	TL	09/17
APPROVED		

CLIENT
Cabra Developments Ltd
Deacon Point
Stages 1 & 2
Dinning Road, Riverhead

DRAWING TITLE
Stormwater Reticulation
As Built Plan
Sheet 2 of 6

ORIGINAL SCALE	ORIGINAL SIZE	REVISION NO
1:500	A3	R2
DATE	CAD REFERENCE	SHEET NO
04/10/2017	34147 E618-E623	E619
DIRECTORY		JOB NO
Z:\34147\ACAD\		34147

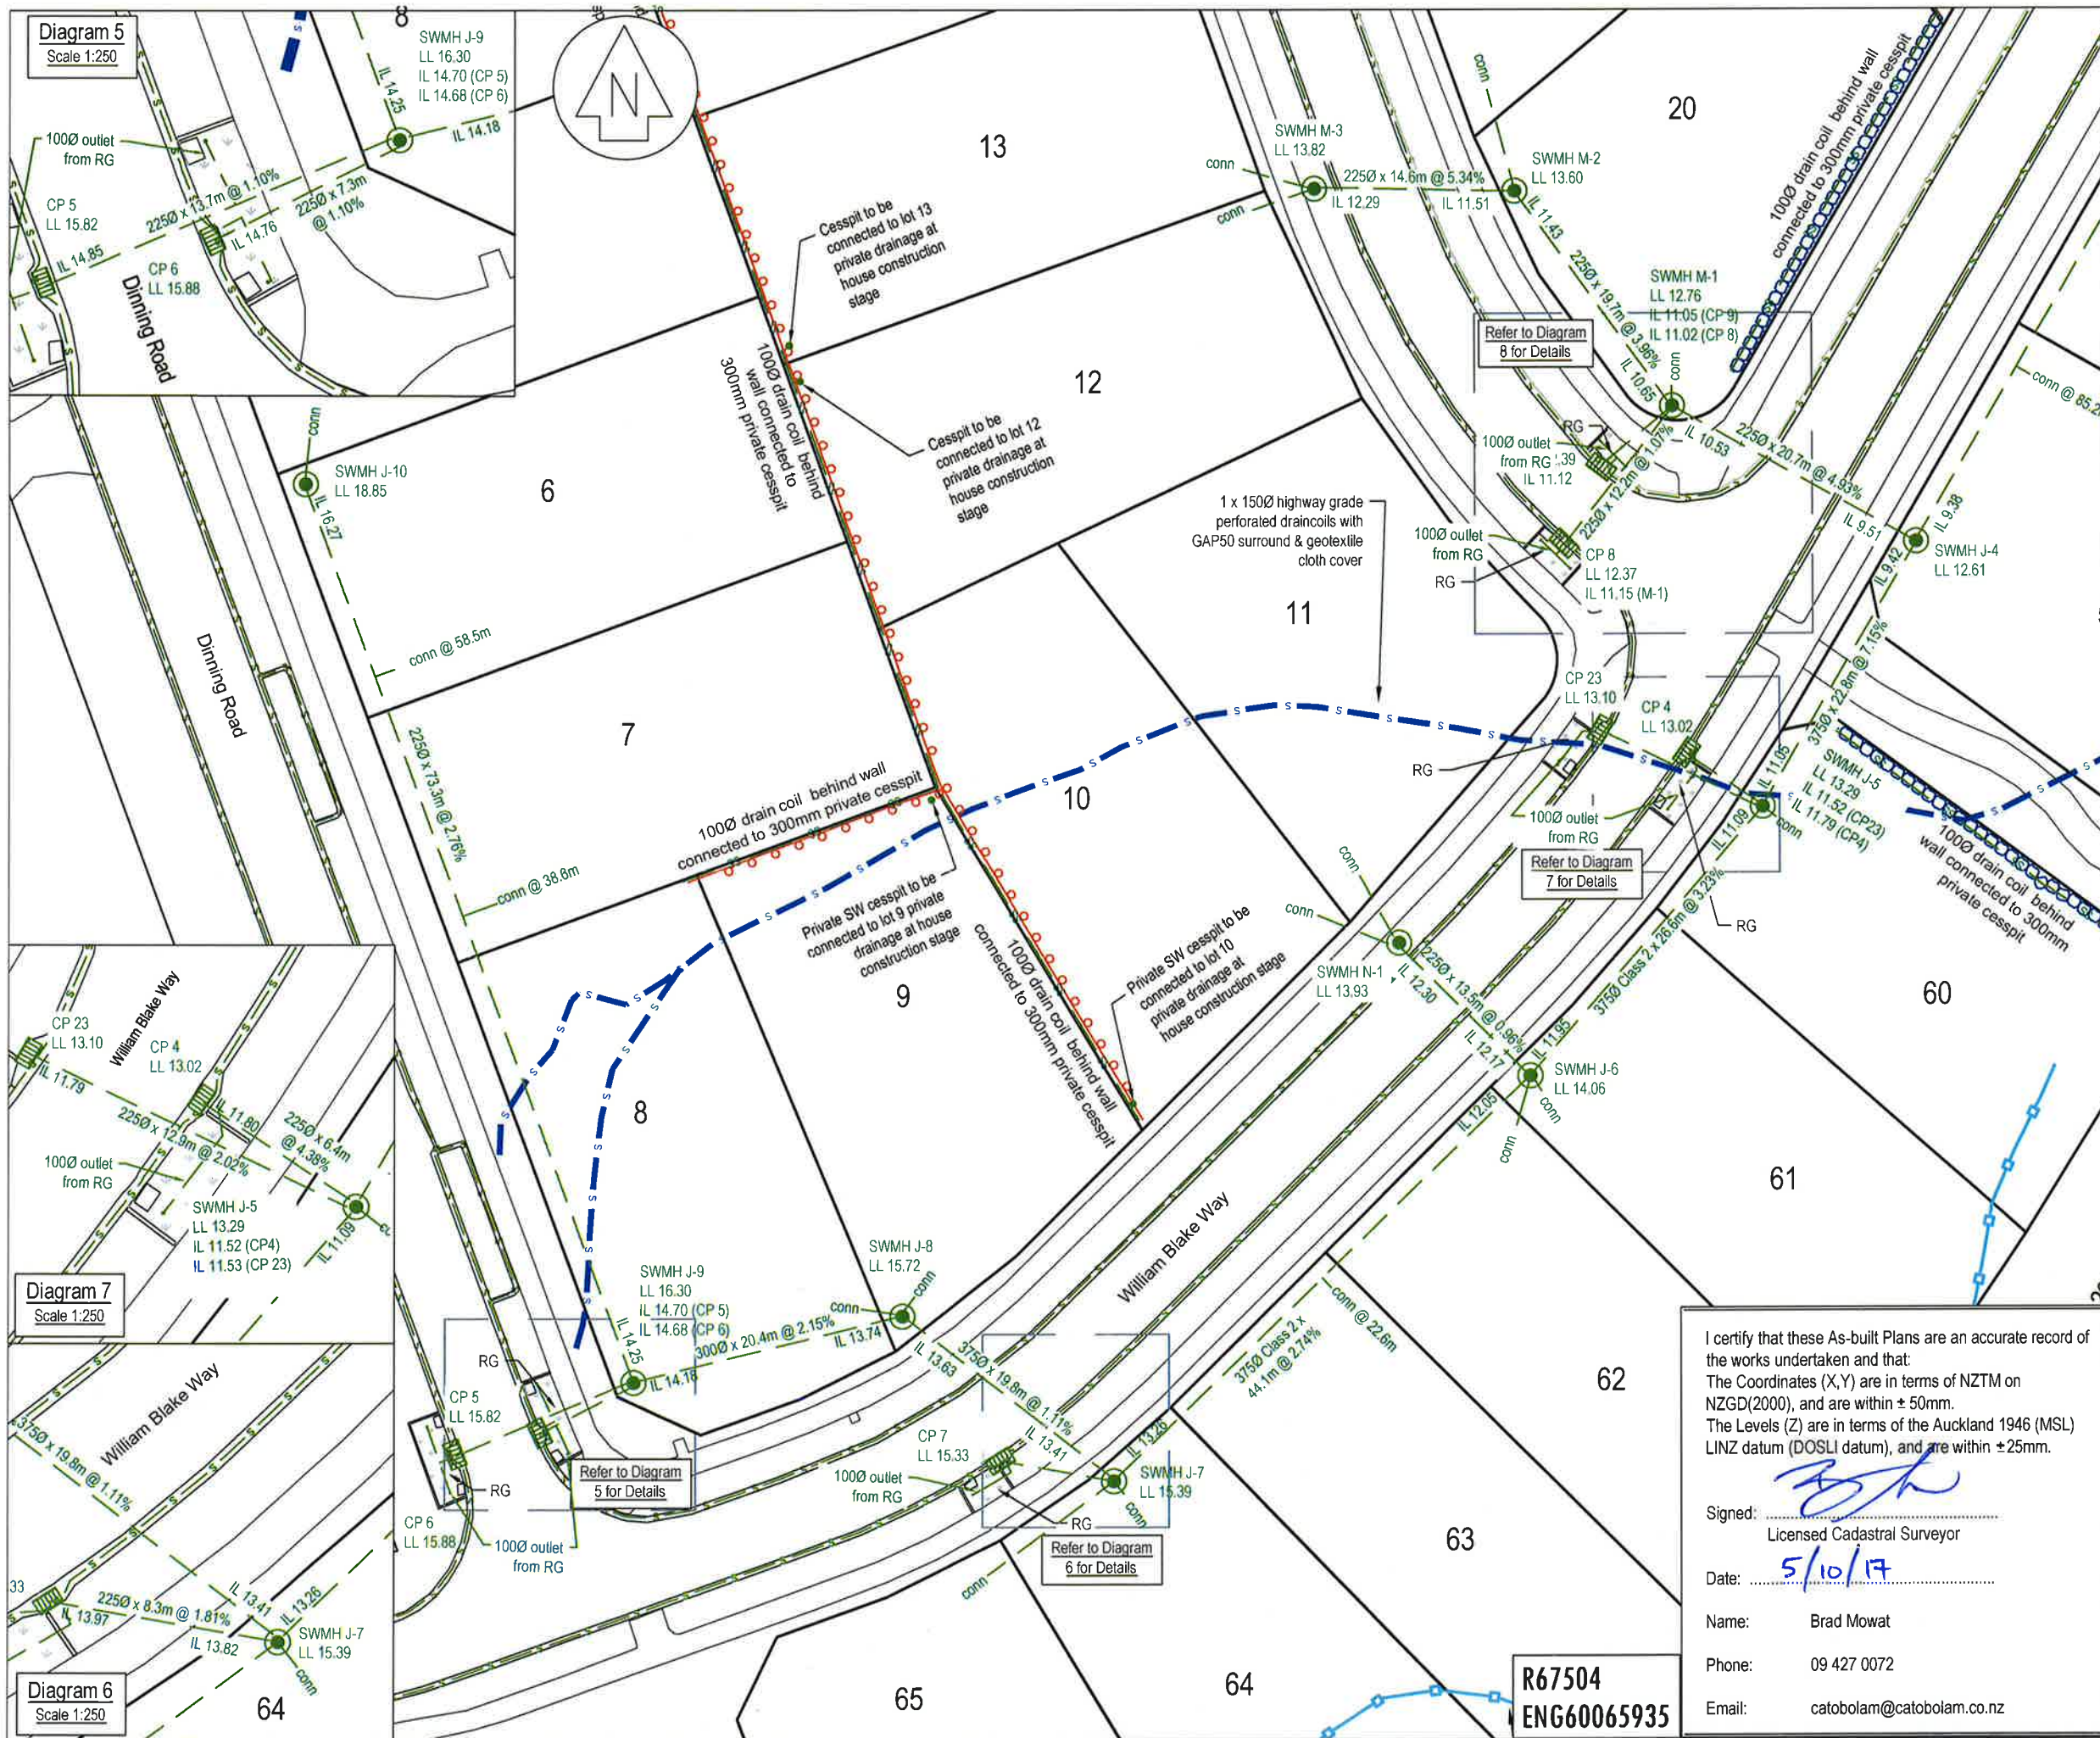

This drawing and design remains the property of Cato Bolam Consultants Ltd and may not be reproduced without the written permission of Cato Bolam Consultants Ltd.

This plan and accompanying report(s) have been prepared for the purpose of obtaining a resource consent only and for no other purpose. Use of this plan and/or the information on it for any other purpose is at the user's risk.

Refer to Sheet E618 for drawing Legend & Notes

REVISION (DESCRIPTIONS)	NAME	DATE
SURVEYED	LD & AA	09/17
DESIGNED		
DRAWN	BJ	10/17
CHECKED	BM	09/17
APPROVED	TL	09/17

CATO BOLAM CONSULTANTS

SURVEYORS PLANNERS ENGINEERS

CATO BOLAM CONSULTANTS LTD
 19 Tamariki Avenue
 PO Box 157
 Orewa 0946
 phone 09-427 0072
 fax 09-426 7331
 email catobolam@catobolam.co.nz

CLIENT Cabra Developments Ltd
Deacon Point
Stages 1 & 2
Dinning Road, Riverhead

DRAWING TITLE
Stormwater Reticulation
As Built Plan
Sheet 3 of 6


ORIGINAL SCALE 1:500	ORIGINAL SIZE A3	REVISION NO R2
DATE 04/10/17	CAD REFERENCE 34147 E618-E623	SHEET NO E620
DIRECTORY Z:\34147\ACAD\		JOB NO 34147

I certify that these As-built Plans are an accurate record of the works undertaken and that:
 The Coordinates (X,Y) are in terms of NZTM on NZGD(2000), and are within ± 50mm.
 The Levels (Z) are in terms of the Auckland 1946 (MSL) LINZ datum (DOSLI datum), and are within ± 25mm.


Signed: *[Signature]*
 Licensed Cadastral Surveyor
 Date: 5/10/17

Name: Brad Mowat
 Phone: 09 427 0072
 Email: catobolam@catobolam.co.nz

R67504
ENG60065935

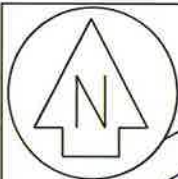

I certify that these As-built Plans are an accurate record of the works undertaken and that:
The Coordinates (X,Y) are in terms of NZTM on NZGD(2000), and are within ± 50mm.
The Levels (Z) are in terms of the Auckland 1946 (MSL) LINZ datum (DOSLI datum), and are within ± 25mm.

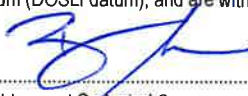Signed: 

Licensed Cadastral Surveyor

Date: 5/10/17

Name: Brad Mowat

Phone: 09 427 0072

Email: catobolam@catobolam.co.nz

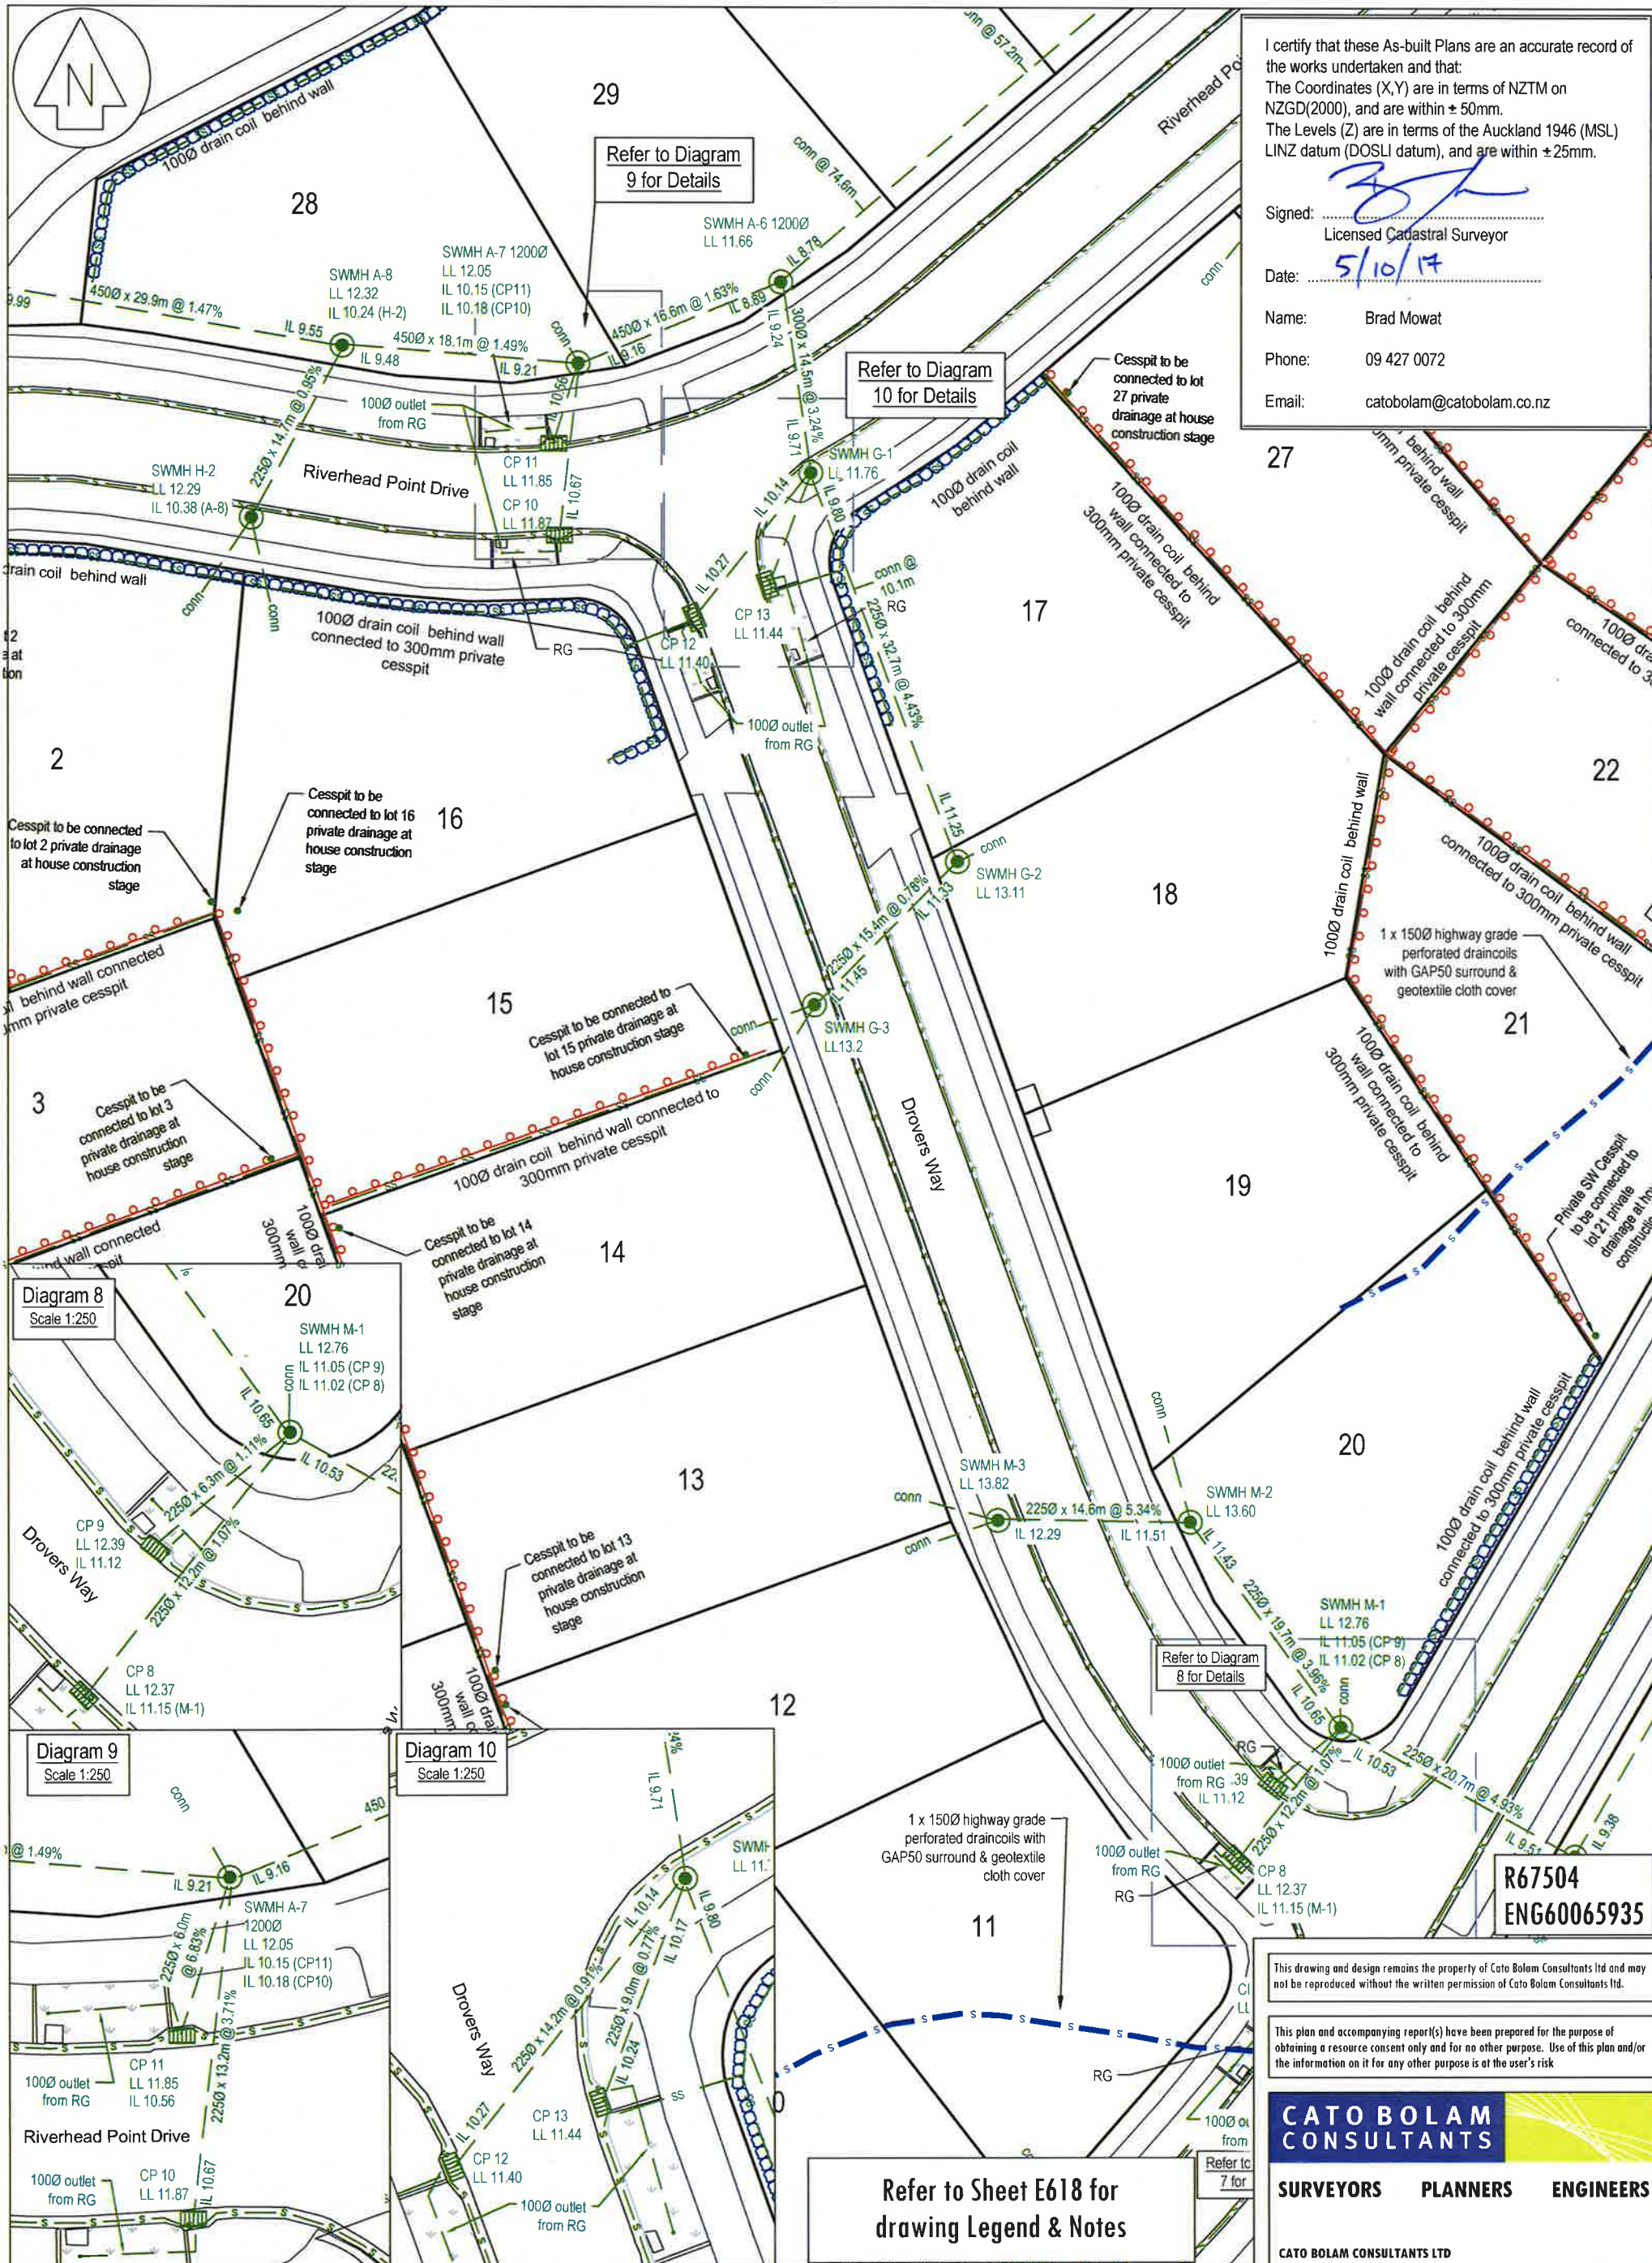


Diagram 8
Scale 1:250

Diagram 9
Scale 1:250

Diagram 10
Scale 1:250

R67504
ENG60065935

This drawing and design remains the property of Cato Bolam Consultants Ltd and may not be reproduced without the written permission of Cato Bolam Consultants Ltd.

This plan and accompanying report(s) have been prepared for the purpose of obtaining a resource consent only and for no other purpose. Use of this plan and/or the information on it for any other purpose is at the user's risk.

CATO BOLAM CONSULTANTS

SURVEYORS PLANNERS ENGINEERS


CATO BOLAM CONSULTANTS LTD
19 Tamariki Avenue
PO Box 157
Drewa 0946
phone 09-427 0072
fax 09-426 7331
email catobolam@catobolam.co.nz

ORIGINAL SCALE	ORIGINAL SIZE	REVISION NO
1:500	A3	R2
DATE	CAD REFERENCE	SHEET NO
04/10/17	34147 E618-E623	E621
DIRECTORY		JOB NO
Z:\34147\ACAD\		34147

REVISION (DESCRIPTIONS)	NAME	DATE
SURVEYED	LD & AA	09/17
DESIGNED		
DRAWN	BJ	10/17
CHECKED	BM	09/17
APPROVED	TL	09/17

CLIENT
Cabra Developments Ltd
Deacon Point
Stages 1 & 2
Dinning Road, Riverhead

DRAWING TITLE
Stormwater Reticulation
As Built Plan
Sheet 4 of 6

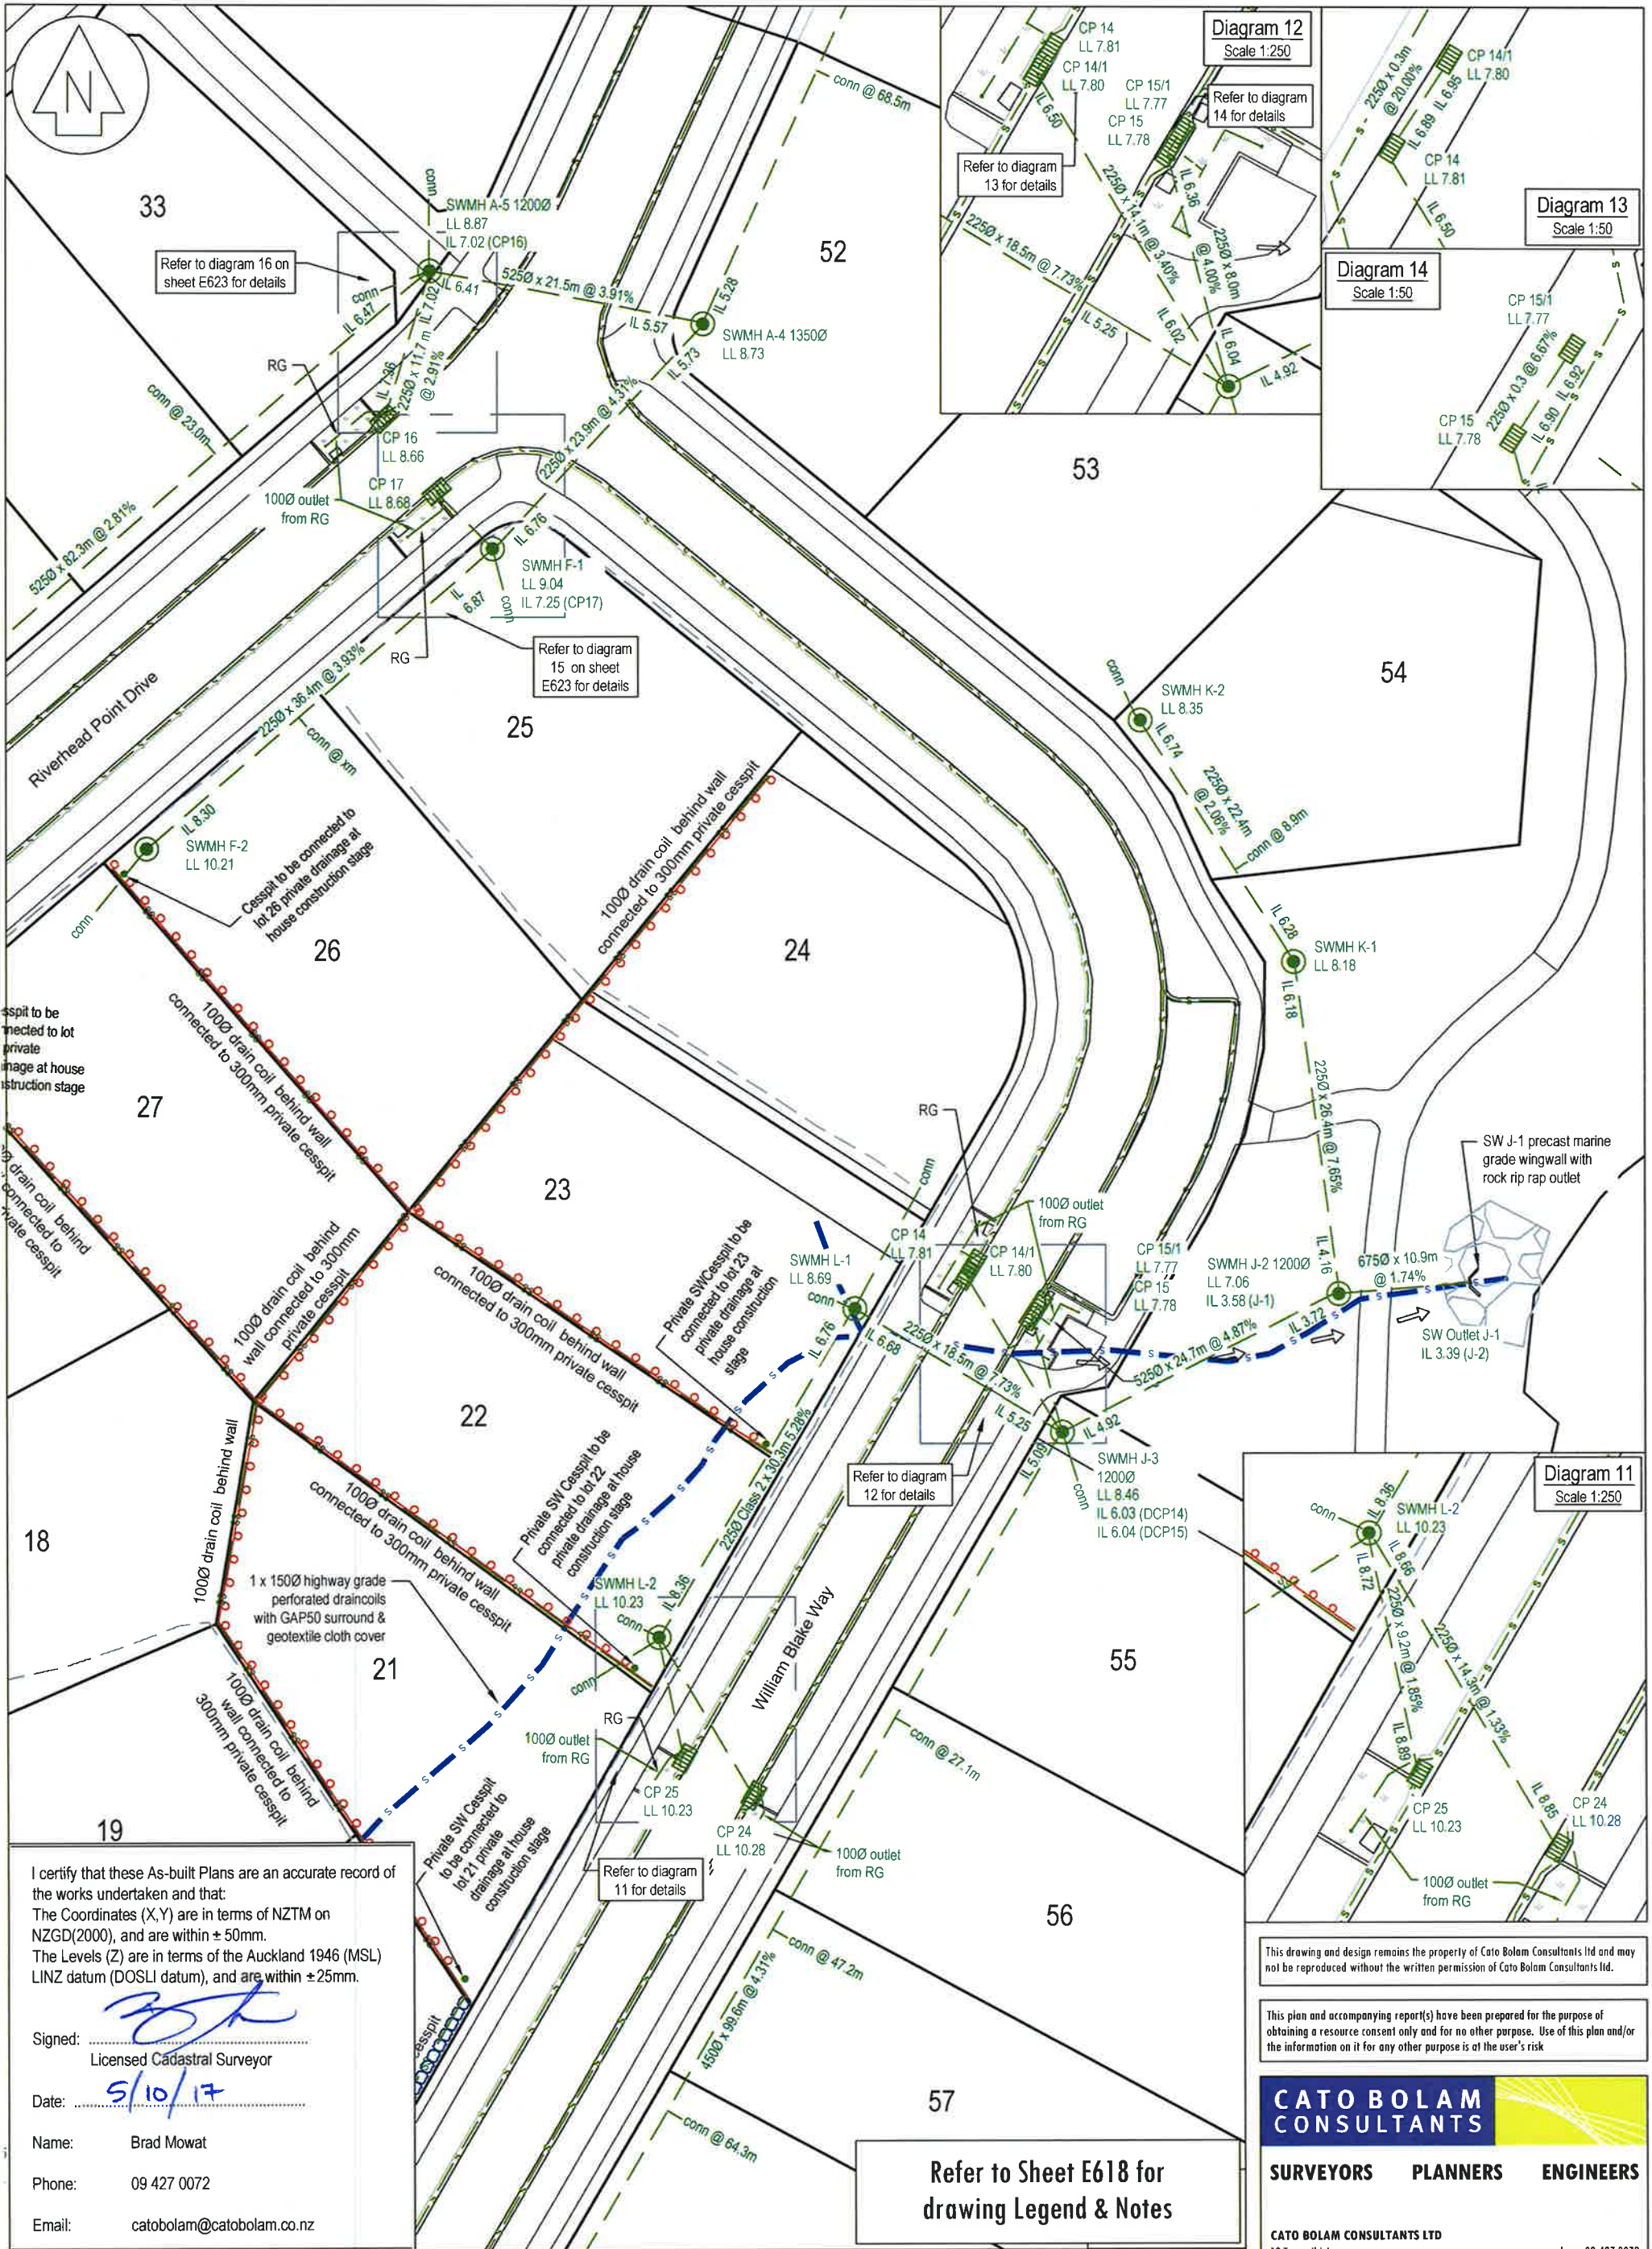

I certify that these As-built Plans are an accurate record of the works undertaken and that:
The Coordinates (X,Y) are in terms of NZTM on NZGD(2000), and are within ± 50mm.
The Levels (Z) are in terms of the Auckland 1946 (MSL) LINZ datum (DOSLI datum), and are within ± 25mm.

Signed: 
Licensed Cadastral Surveyor
Date: 5/10/17
Name: Brad Mowat
Phone: 09 427 0072
Email: catobolam@catobolam.co.nz

REVISION (DESCRIPTIONS)	NAME	DATE
SURVEYED	LD & AA	09/17
DESIGNED		
DRAWN	BJ	10/17
CHECKED	BM	09/17
APPROVED	TL	09/17

CLIENT
Cabra Developments Ltd
Deacon Point
Stages 1 & 2
Dinning Road, Riverhead

DRAWING TITLE
Stormwater Reticulation
As Built Plan
Sheet 5 of 6

This drawing and design remains the property of Cato Bolam Consultants Ltd and may not be reproduced without the written permission of Cato Bolam Consultants Ltd.

This plan and accompanying report(s) have been prepared for the purpose of obtaining a resource consent only and for no other purpose. Use of this plan and/or the information on it for any other purpose is at the user's risk.

CATO BOLAM CONSULTANTS
SURVEYORS PLANNERS ENGINEERS
CATO BOLAM CONSULTANTS LTD
19 Tamariki Avenue
PO Box 157
Orewa 0946
phone 09-427 0072
fax 09-426 7331
email catobolam@catobolam.co.nz

ORIGINAL SCALE	ORIGINAL SIZE	REVISION NO
1:500	A3	R2
DATE	CAD REFERENCE	SHEET NO
04/10/17	34147 E618-E623	E622
DIRECTORY		JOB NO
Z:\34147\ACAD\		34147



Email: catobolam@catobolam.co.nz



REVISION (DESCRIPTIONS)	NAME	DATE
	NAME	DATE
SURVEYED	LD & AA	09/17
DESIGNED		
DRAWN	BJ	10/17
CHECKED	BM	09/17
APPROVED	TL	09/17

**CATO BOLAM
CONSULTANTS**

SURVEYORS PLANNERS ENGINEERS

CATO BOLAM CONSULTANTS LTD
19 Tamariki Avenue
PO Box 157
Orewa 0946

phone 09-427 0072

fax 09-426 7331

email catobolam@catobolam.co.nz

CLIENT **Cabra Developments Ltd**
Deacon Point
Stages 1 & 2
Dinning Road, Riverhead

DRAWING TITLE
**Stormwater Reticulation
As Built Plan
Sheet 6 of 6**

ORIGINAL SCALE 1:500	ORIGINAL SIZE A3	REVISION NO R2
DATE 04/10/17	CAD REFERENCE 34147 E618-E623	SHEET NO E623
DIRECTORY Z:\34147\ACAD\		JOB NO 34147

R67504
ENG60065935

Water Reticulation Legend

Existing New - constructed under SLC 67504

32 32 Watermain (Ø) 32

63 63 63

125 125 125

Sluice Valve Sluice Valve

Peet Valve Peet Valve

Lot Service Connections Lot Service Connections

Fire Hydrant Fire Hydrant

NOTES

GENERAL

1. Coordinates are in terms of NZTM 2000.

WATER RETICULATION

1. Cover for water reticulation.

a) Mains under grass berms and footpaths 600mm


b) Mains under road carriageway 900mm

2. Watermain 125, OD - PE100 PN12.5

3. All ridermains 63 OD - PE80 PN12.5

4. Stainless Steel bolts and nuts used for flanged connections.

5. Metallic Detector Tape provided above all watermains and ridermains

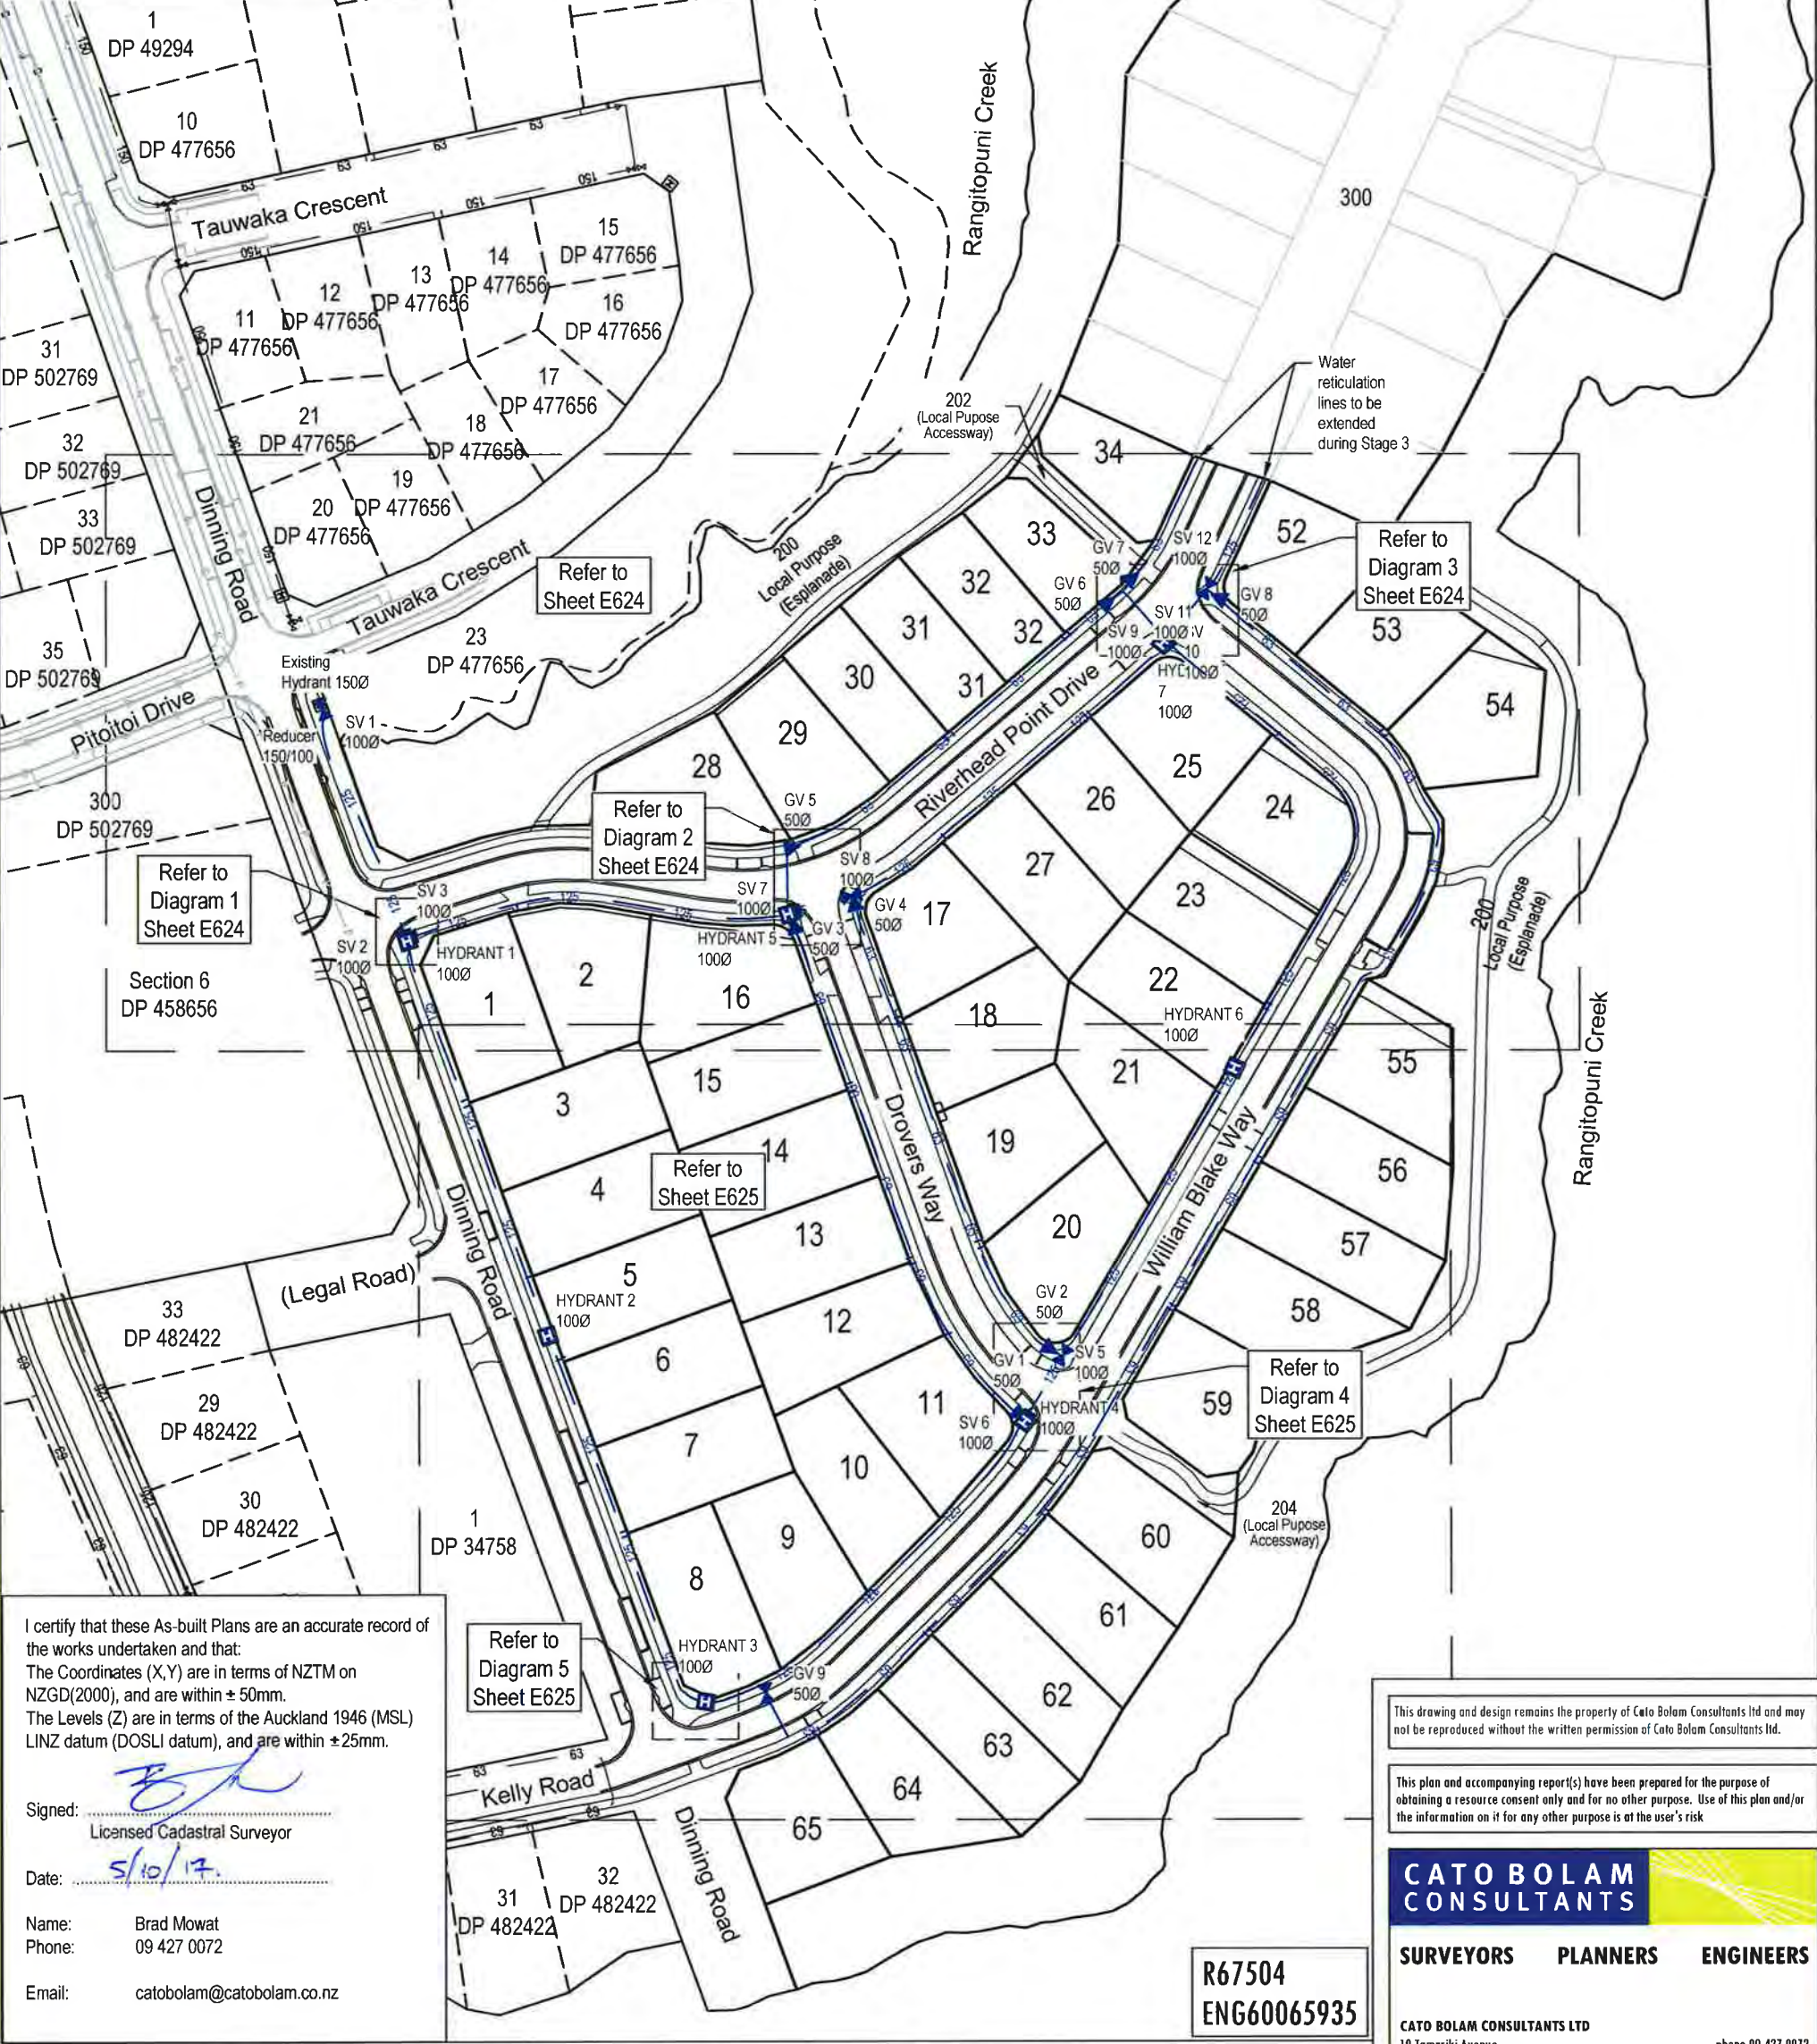

I certify that these As-built Plans are an accurate record of the works undertaken and that:

The Coordinates (X,Y) are in terms of NZTM on NZGD(2000), and are within ± 50mm.

The Levels (Z) are in terms of the Auckland 1946 (MSL) LINZ datum (DOSLI datum), and are within ± 25mm.

Signed: *[Signature]*
Licensed Cadastral Surveyor

Date: 5/10/17

Name: Brad Mowat
Phone: 09 427 0072
Email: catobolam@catobolam.co.nz

This drawing and design remains the property of Cato Bolam Consultants Ltd and may not be reproduced without the written permission of Cato Bolam Consultants Ltd.

This plan and accompanying report(s) have been prepared for the purpose of obtaining a resource consent only and for no other purpose. Use of this plan and/or the information on it for any other purpose is at the user's risk.

CATO BOLAM CONSULTANTS

SURVEYORS PLANNERS ENGINEERS

CATO BOLAM CONSULTANTS LTD
19 Tamariki Avenue
PO Box 157
Drewa 0946

phone 09-427 0072
fax 09-426 7331
email catobolam@catobolam.co.nz

GV 9 installed	AA	09/17
REVISION (DESCRIPTIONS)	NAME	DATE
SURVEYED	NAME	DATE
DESIGNED	LD	09/17
DRAWN	AA	10/17
CHECKED	BJ	09/17
APPROVED	TL	09/17


CLIENT

Cabra Developments Ltd
Deacon Point
Stages 1 & 2
Dinning Road, Riverhead

DRAWING TITLE

Water Reticulation
As Built Plan
Sheet 1 of 3

ORIGINAL SCALE	ORIGINAL SIZE	REVISION NO
1:1500	A3	R2
DATE	CAD REFERENCE	SHEET NO
04/10/17	34147 E624-E626	E624
DIRECTORY		JOB NO
Z:\34147\ACAD\As Built Stage 1 and 2		34147

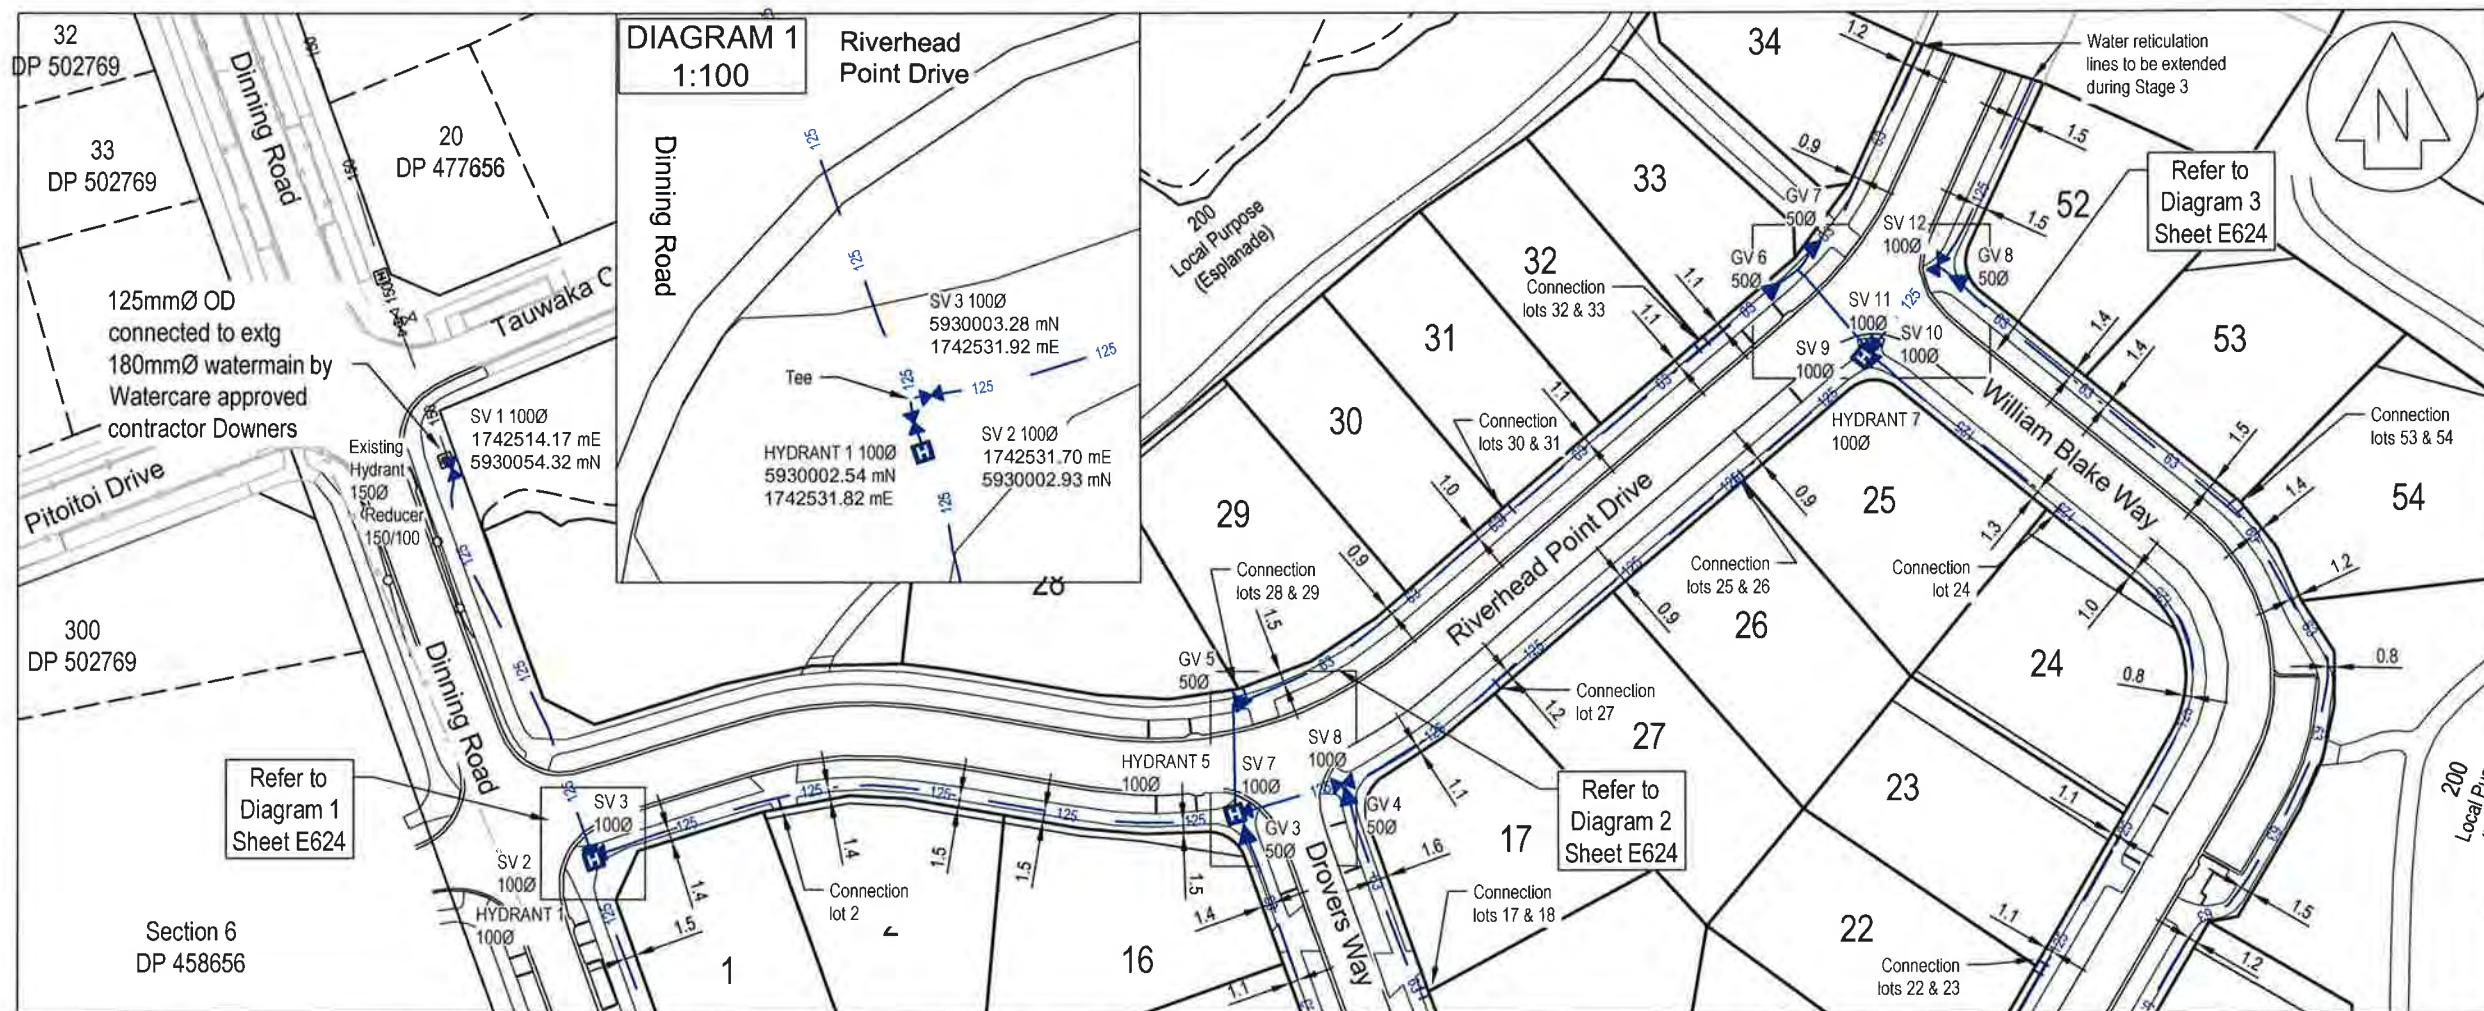

This drawing and design remains the property of Cato Bolam Consultants Ltd and may not be reproduced without the written permission of Cato Bolam Consultants Ltd.

This plan and accompanying report(s) have been prepared for the purpose of obtaining a resource consent only and for no other purpose. Use of this plan and/or the information on it for any other purpose is at the user's risk.

Water Reticulation Legend

Existing	New - constructed under SLC 67504
— 32 — — 63 — — 125 —	— 32 — — 63 — — 125 —
⊗	⊗
△	△
—	—
⊞	⊞

REVISION (DESCRIPTIONS)	NAME	DATE
SURVEYED	LD	09/17
DESIGNED	AA	10/17
CHECKED	BJ	09/17
APPROVED	TL	09/17

CATO BOLAM CONSULTANTS

SURVEYORS PLANNERS ENGINEERS

CATO BOLAM CONSULTANTS LTD
19 Tamariki Avenue
PO Box 157
Orewa 0946
phone 09-427 0072
fax 09-426 7331
email catobolam@catobolam.co.nz

CLIENT Cabra Developments Ltd
Deacon Point
Stages 1 & 2
Dinning Road, Riverhead

DRAWING TITLE
Water Reticulation
As Built Plan
Sheet 2 of 3

ORIGINAL SCALE 1:1000	ORIGINAL SIZE A3	REVISION NO R2
DATE 04/10/17	CAD REFERENCE 34147 E624-E626	SHEET NO E625
DIRECTORY Z:\34147\ACAD\As Built Stage 1 and 2		JOB NO 34147

NOTES
GENERAL
1. Coordinates are in terms of NZTM 2000.

WATER RETICULATION

- Cover for water reticulation:
a) Mains under grass berms and footpaths 600mm
b) Mains under road carriageway 900mm
- Watermain 125, OD - PE100 PN12.5
- All rider mains 63 OD - PE80 PN12.5
- Stainless Steel bolts and nuts used for flanged connections
- Metallic Detector Tape provided above all water mains and rider mains



I certify that these As-built Plans are an accurate record of the works undertaken and that:
The Coordinates (X,Y) are in terms of NZTM on NZGD(2000), and are within ± 50mm.
The Levels (Z) are in terms of the Auckland 1946 (MSL) LINZ datum (DOSL datum), and are within ± 25mm.


Signed:
Licensed Cadastral Surveyor

Date: 5/10/17

Name: Brad Mowat
Phone: 09 427 0072

Email: catobolam@catobolam.co.nz

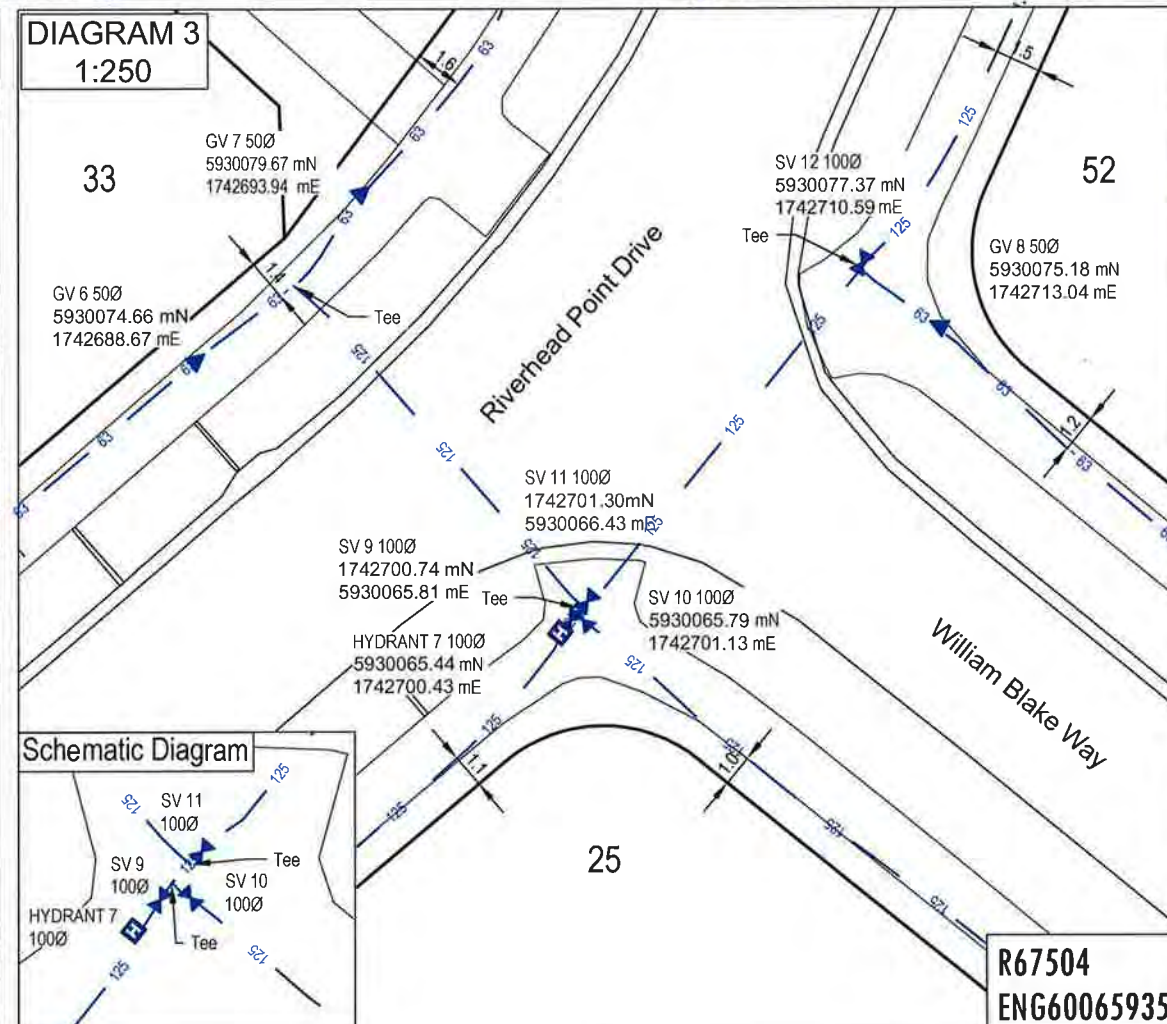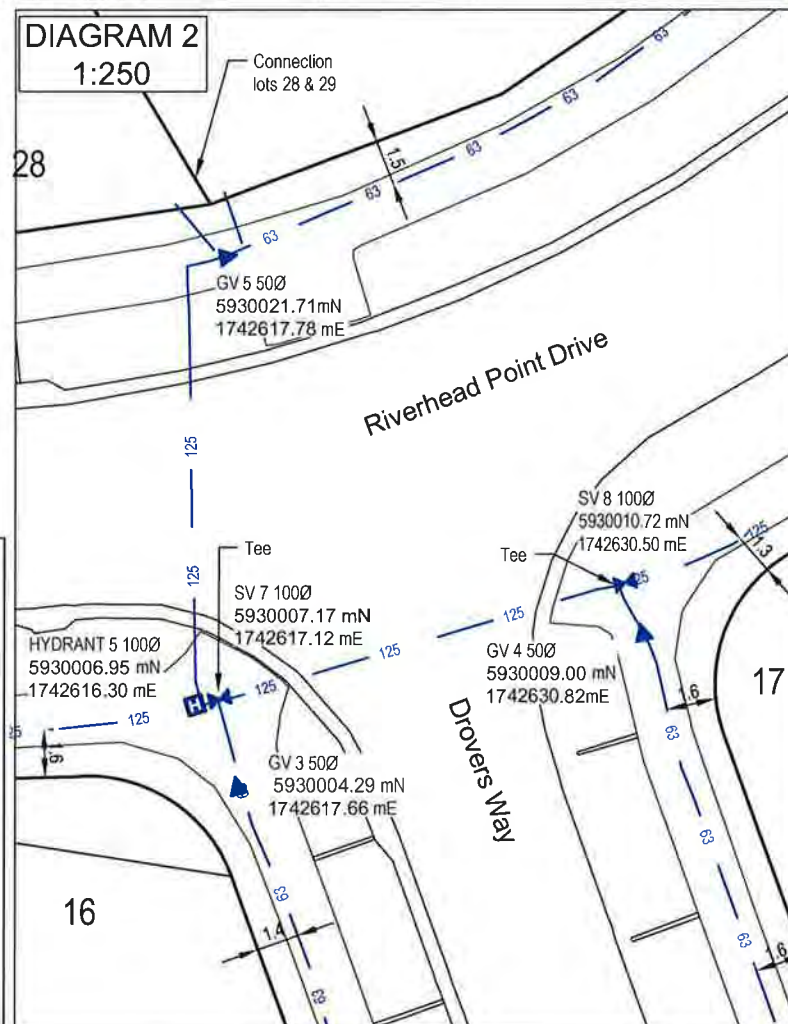

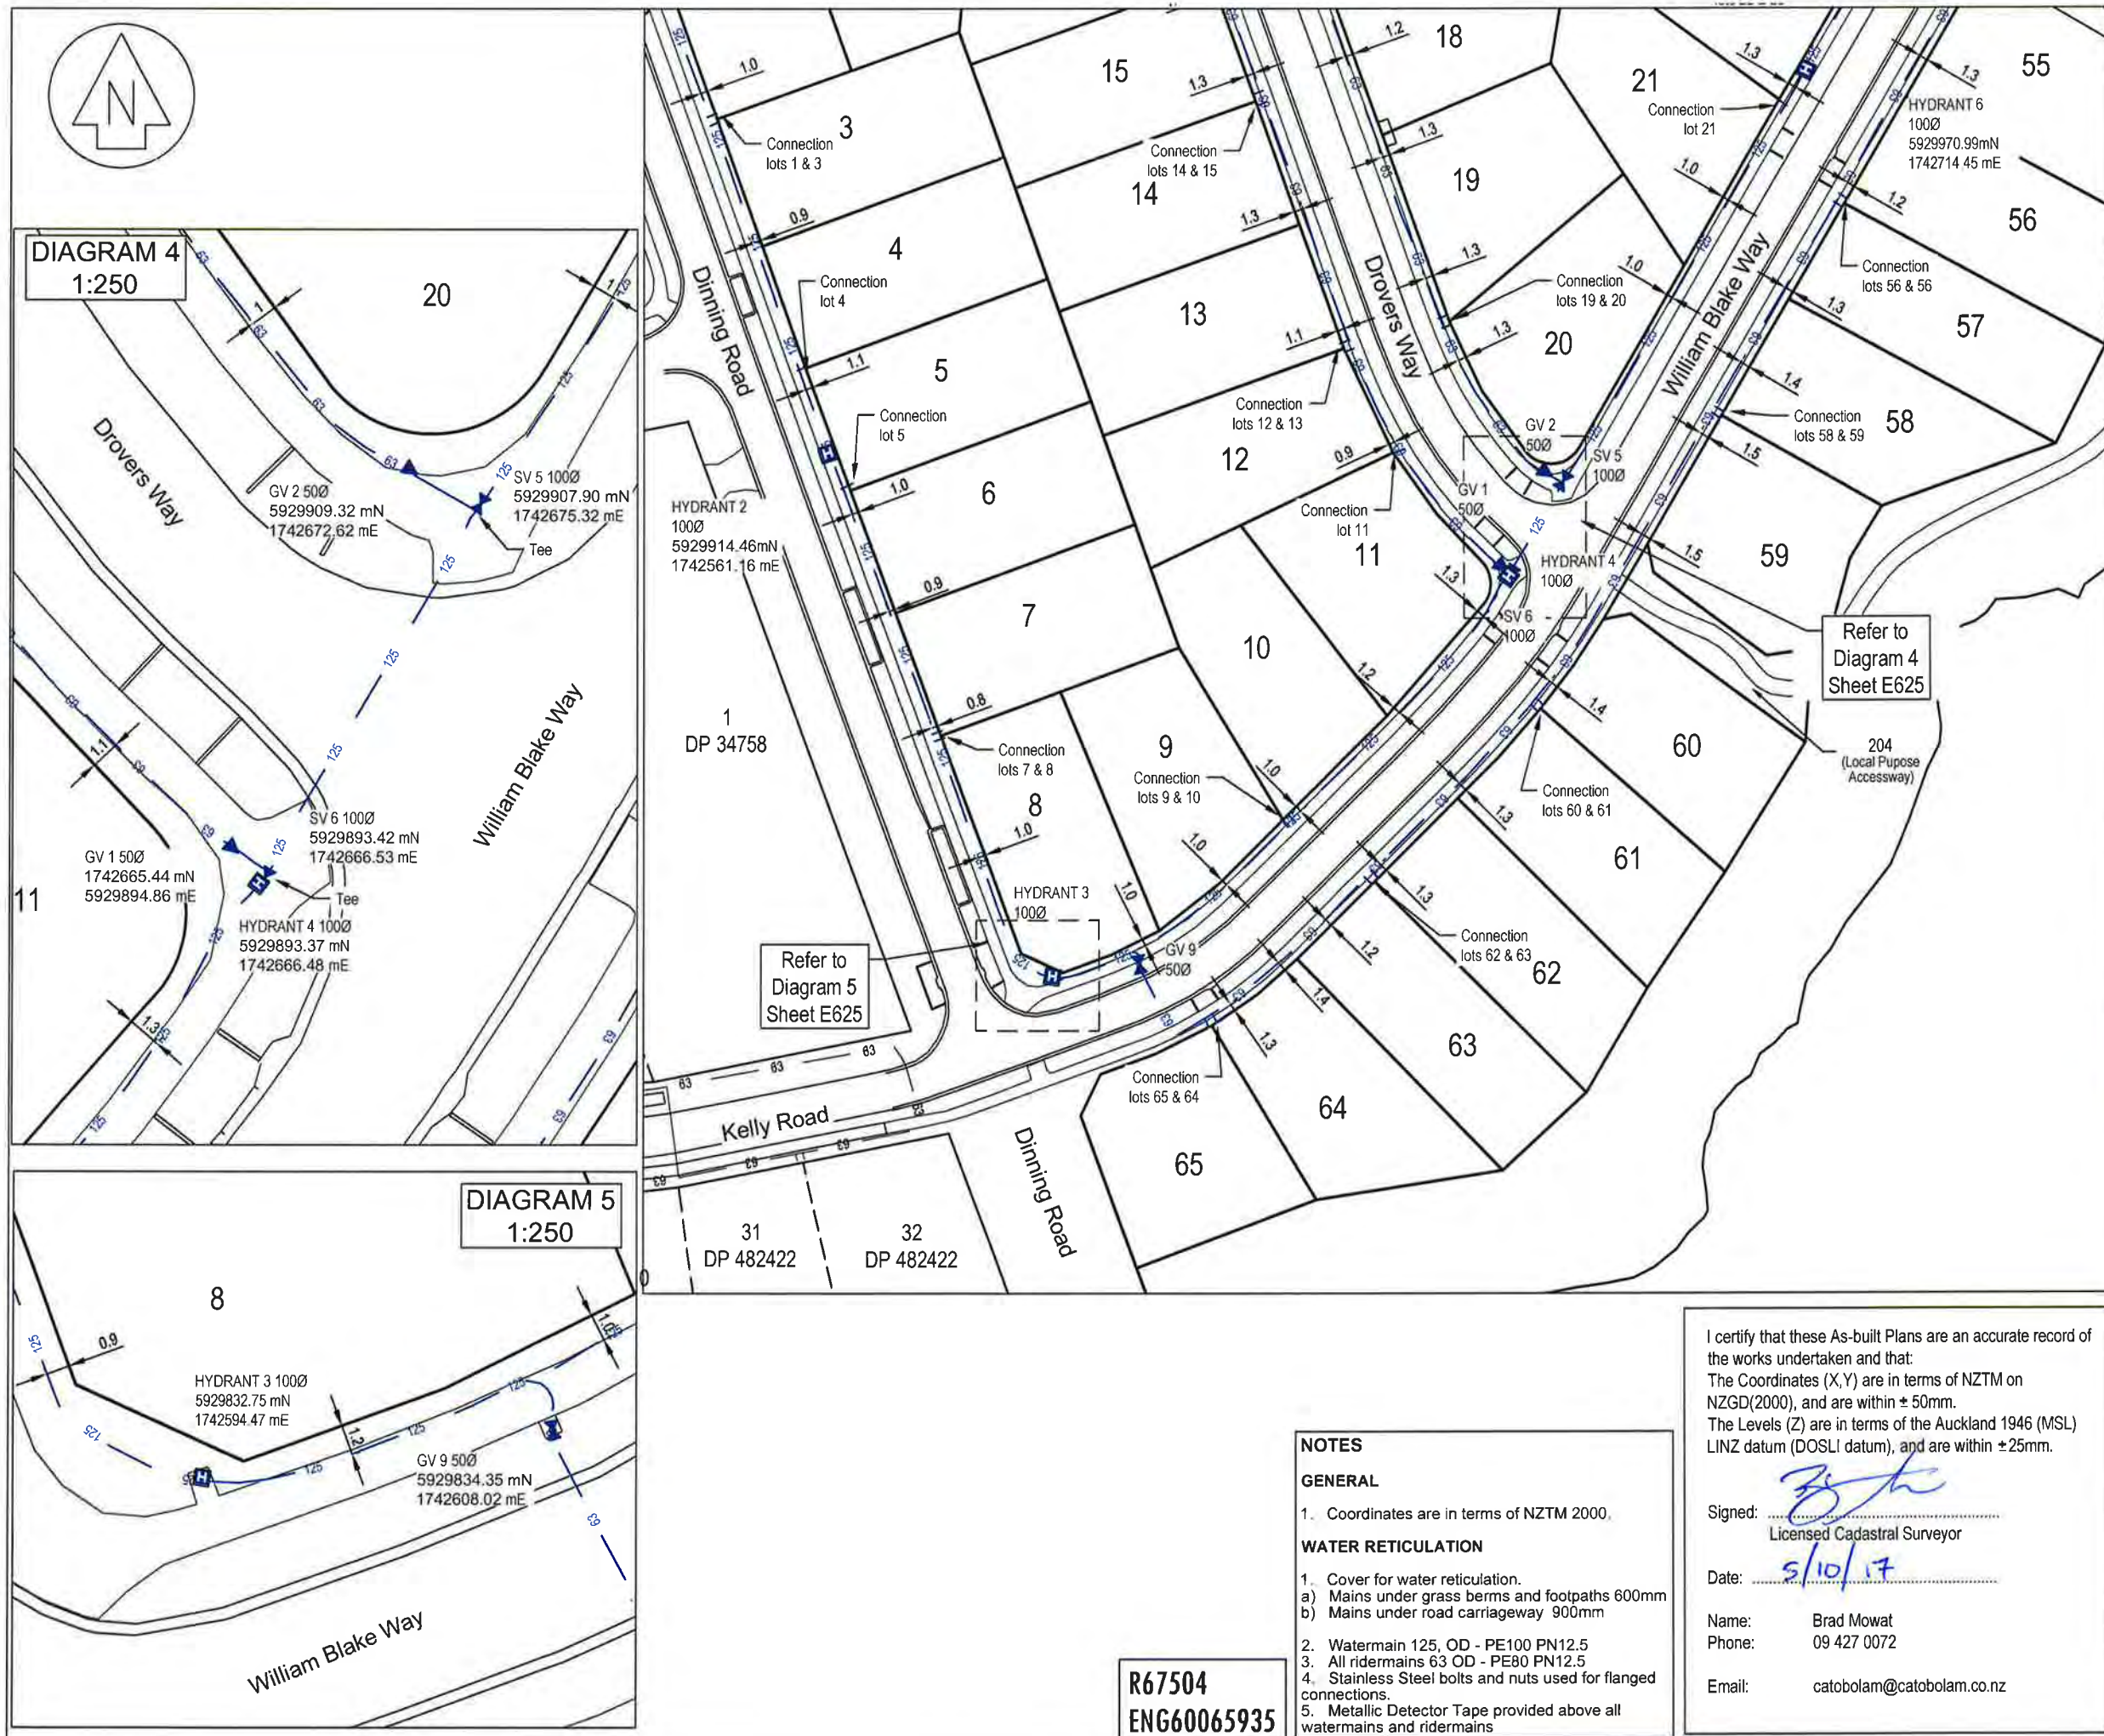

This drawing and design remains the property of Cato Bolam Consultants Ltd and may not be reproduced without the written permission of Cato Bolam Consultants Ltd.

This plan and accompanying report(s) have been prepared for the purpose of obtaining a resource consent only and for no other purpose. Use of this plan and/or the information on it for any other purpose is at the user's risk.

Water Reticulation Legend

Existing	New - constructed under SLC 67504
32	32
63	63
125	125
Watermain (Ø)	Watermain (Ø)
Sluice Valve	Sluice Valve
Peet Valve	Peet Valve
Lot Service Connections	Lot Service Connections
Fire Hydrant	Fire Hydrant

REVISION (DESCRIPTIONS)	NAME	DATE
GV 9 installed	AA	09/17
SURVEYED	LD	09/17
DESIGNED		
DRAWN	AA	10/17
CHECKED	BJ	09/17
APPROVED	TL	09/17

CATO BOLAM CONSULTANTS

SURVEYORS PLANNERS ENGINEERS

CATO BOLAM CONSULTANTS LTD
19 Tamariki Avenue
PO Box 157
Orewa 0946
phone 09-427 0072
fax 09-426 7331
email catobolam@catobolam.co.nz

CLIENT
Cabra Developments Ltd
Deacon Point
Stages 1 & 2
Dinning Road, Riverhead

DRAWING TITLE
Water Reticulation
As Built Plan
Sheet 3 of 3

ORIGINAL SCALE 1:1000	ORIGINAL SIZE A3	REVISION NO
DATE 04/10/17	CAD REFERENCE 34147 E624-E626	SHEET NO E626
DIRECTORY Z:\34147\ACAD\As Built Stage 1 and 2	JOB NO	34147

NOTES

GENERAL

- Coordinates are in terms of NZTM 2000.

WATER RETICULATION

- Cover for water reticulation.
 - Mains under grass berms and footpaths 600mm
 - Mains under road carriageway 900mm
- Watermain 125, OD - PE100 PN12.5
- All rider mains 63 OD - PE80 PN12.5
- Stainless Steel bolts and nuts used for flanged connections.
- Metallic Detector Tape provided above all water mains and rider mains


I certify that these As-built Plans are an accurate record of the works undertaken and that:
The Coordinates (X,Y) are in terms of NZTM on NZGD(2000), and are within ± 50 mm.
The Levels (Z) are in terms of the Auckland 1946 (MSL) LINZ datum (DOSLI datum), and are within ± 25 mm.

Signed:
Licensed Cadastral Surveyor

Date: 5/10/17

Name: Brad Mowat
Phone: 09 427 0072
Email: catobolam@catobolam.co.nz

R67504
ENG60065935

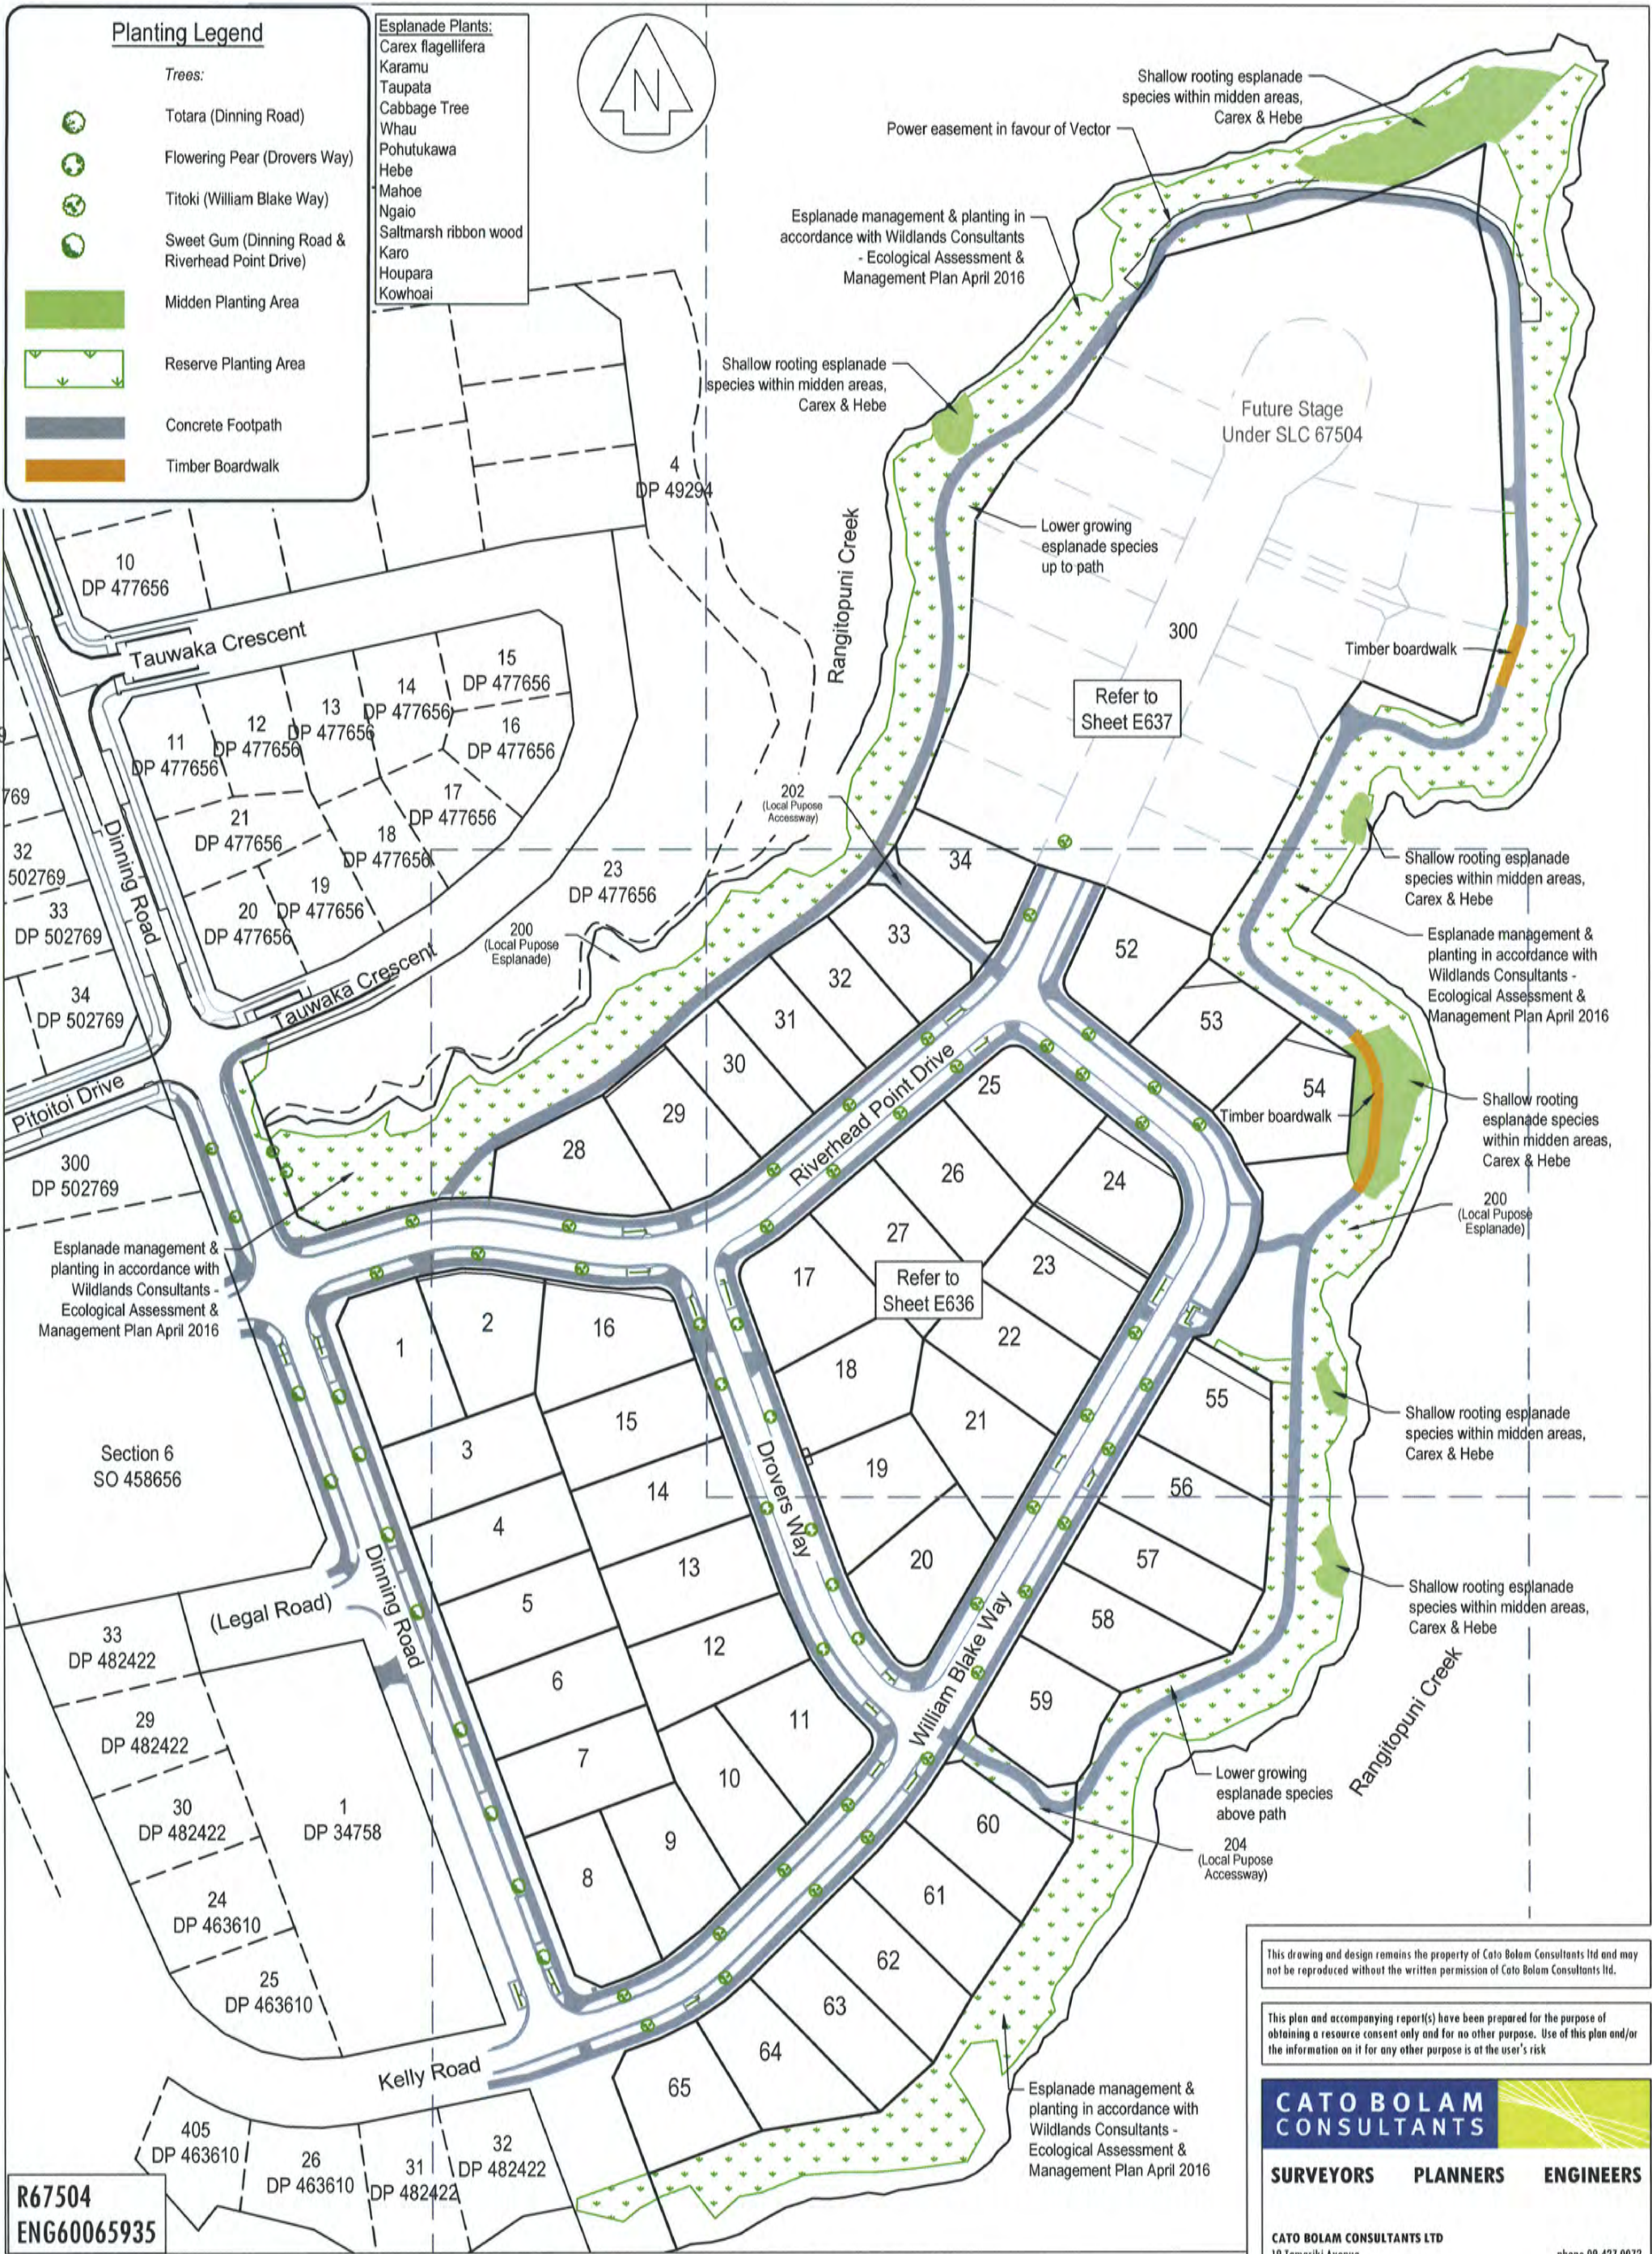

R67504
ENG60065935

REVISION (DESCRIPTIONS)	NAME	DATE
SURVEYED	LD	09/17
DESIGNED	AA	09/17
DRAWN	BJ	09/17
CHECKED	TL	09/17
APPROVED		

CLIENT
Cabra Developments Ltd
Deacon Point
Stages 1 & 2
Dinning Road
Riverhead

DRAWING TITLE
Esplanade Reserve Planting
As Built Plan
Sheet 1 of 3

This drawing and design remains the property of Cato Bolam Consultants Ltd and may not be reproduced without the written permission of Cato Bolam Consultants Ltd.

This plan and accompanying report(s) have been prepared for the purpose of obtaining a resource consent only and for no other purpose. Use of this plan and/or the information on it for any other purpose is at the user's risk.

CATO BOLAM CONSULTANTS

SURVEYORS PLANNERS ENGINEERS

CATO BOLAM CONSULTANTS LTD
19 Tamariki Avenue
PO Box 157
Orewa 0946

phone 09-427 0072
fax 09-426 7331
email cato bolam@cato bolam.co.nz

ORIGINAL SCALE 1:1500	ORIGINAL SIZE A3	REVISION NO
DATE 14/09/17	CAD REFERENCE 34147 E627-E629	SHEET NO E627
DIRECTORY Z:\34147\ACAD\ASBUILTS		JOB NO 34147



Esplanade management & planting in accordance with Wildlands Consultants - Ecological Assessment & Management Plan April 2016

200
(Local Purpose Esplanade)

Shallow rooting esplanade species within midden areas, Carex & Hebe

Esplanade management & planting in accordance with Wildlands Consultants - Ecological Assessment & Management Plan April 2016

Timber boardwalk

Shallow rooting esplanade species within midden areas, Carex & Hebe

Esplanade management & planting in accordance with Wildlands Consultants - Ecological Assessment & Management Plan April 2016

Shallow rooting esplanade species within midden areas, Carex & Hebe

Shallow rooting esplanade species within midden areas, Carex & Hebe

Lower growing esplanade species above path

Rangitopuni Creek

Esplanade management & planting in accordance with Wildlands Consultants - Ecological Assessment & Management Plan April 2016

Planting Legend

Trees:

- Totara (Dinning Road)
- Flowering Pear (Drovers Way)
- Titoki (William Blake Way)
- Sweet Gum (Dinning Road & Riverhead Point Drive)

Midden Planting Area

Reserve Planting Area

Concrete Footpath

Timber Boardwalk

R67504
ENG60065935

This drawing and design remains the property of Cato Bolam Consultants Ltd and may not be reproduced without the written permission of Cato Bolam Consultants Ltd.

This plan and accompanying report(s) have been prepared for the purpose of obtaining a resource consent only and for no other purpose. Use of this plan and/or the information on it for any other purpose is at the user's risk.

CATO BOLAM CONSULTANTS

SURVEYORS PLANNERS ENGINEERS

CATO BOLAM CONSULTANTS LTD
19 Tamariki Avenue
PO Box 157
Orewa 0946

phone 09-427 0072
fax 09-426 7331
email catobolam@catobolam.co.nz

ORIGINAL SCALE 1:1000	ORIGINAL SIZE A3	REVISION NO
DATE 10/09/17	CAD REFERENCE 34147 E627-E629	SHEET NO E628
DIRECTORY Z:\34147\ACAD\ASBUILTS		JOB NO 34147

REVISION (DESCRIPTIONS)	NAME	DATE
SURVEYED	LD	09/17
DESIGNED	AA	09/17
DRAWN	TL	09/17
CHECKED	TL	09/17
APPROVED	TL	09/17

CLIENT

Cabra Developments Ltd
Deacon Point
Stages 1 & 2
Dinning Road, Riverhead

DRAWING TITLE

Esplanade Reserve Planting
As Built Plan
Sheet 2 of 3



This drawing and design remains the property of Cato Bolam Consultants Ltd and may not be reproduced without the written permission of Cato Bolam Consultants Ltd.

This plan and accompanying report(s) have been prepared for the purpose of obtaining a resource consent only and for no other purpose. Use of this plan and/or the information on it for any other purpose is at the user's risk.

CATO BOLAM CONSULTANTS

SURVEYORS PLANNERS ENGINEERS


CATO BOLAM CONSULTANTS LTD
19 Tamariki Avenue
PO Box 157
Orewa 0946
phone 09-427 0072
fax 09-426 7331
email catobolam@catobolam.co.nz

ORIGINAL SCALE 1:1000	ORIGINAL SIZE A3	REVISION NO
DATE 10/09/17	CAD REFERENCE 34147 E627-E629	SHEET NO E629
DIRECTORY Z:\34147\ACAD\ASBUILT		JOB NO 34147

REVISION (DESCRIPTIONS)	NAME	DATE
SURVEYED	LD	09/17
DESIGNED	AA	09/17
DRAWN	TL	09/17
CHECKED	TL	09/17
APPROVED	TL	09/17

CLIENT
Cabra Developments Ltd
Deacon Point
Stages 1 & 2
Dinning Road, Riverhead

DRAWING TITLE
Esplanade Reserve Planting
As Built Plan
Sheet 3 of 3

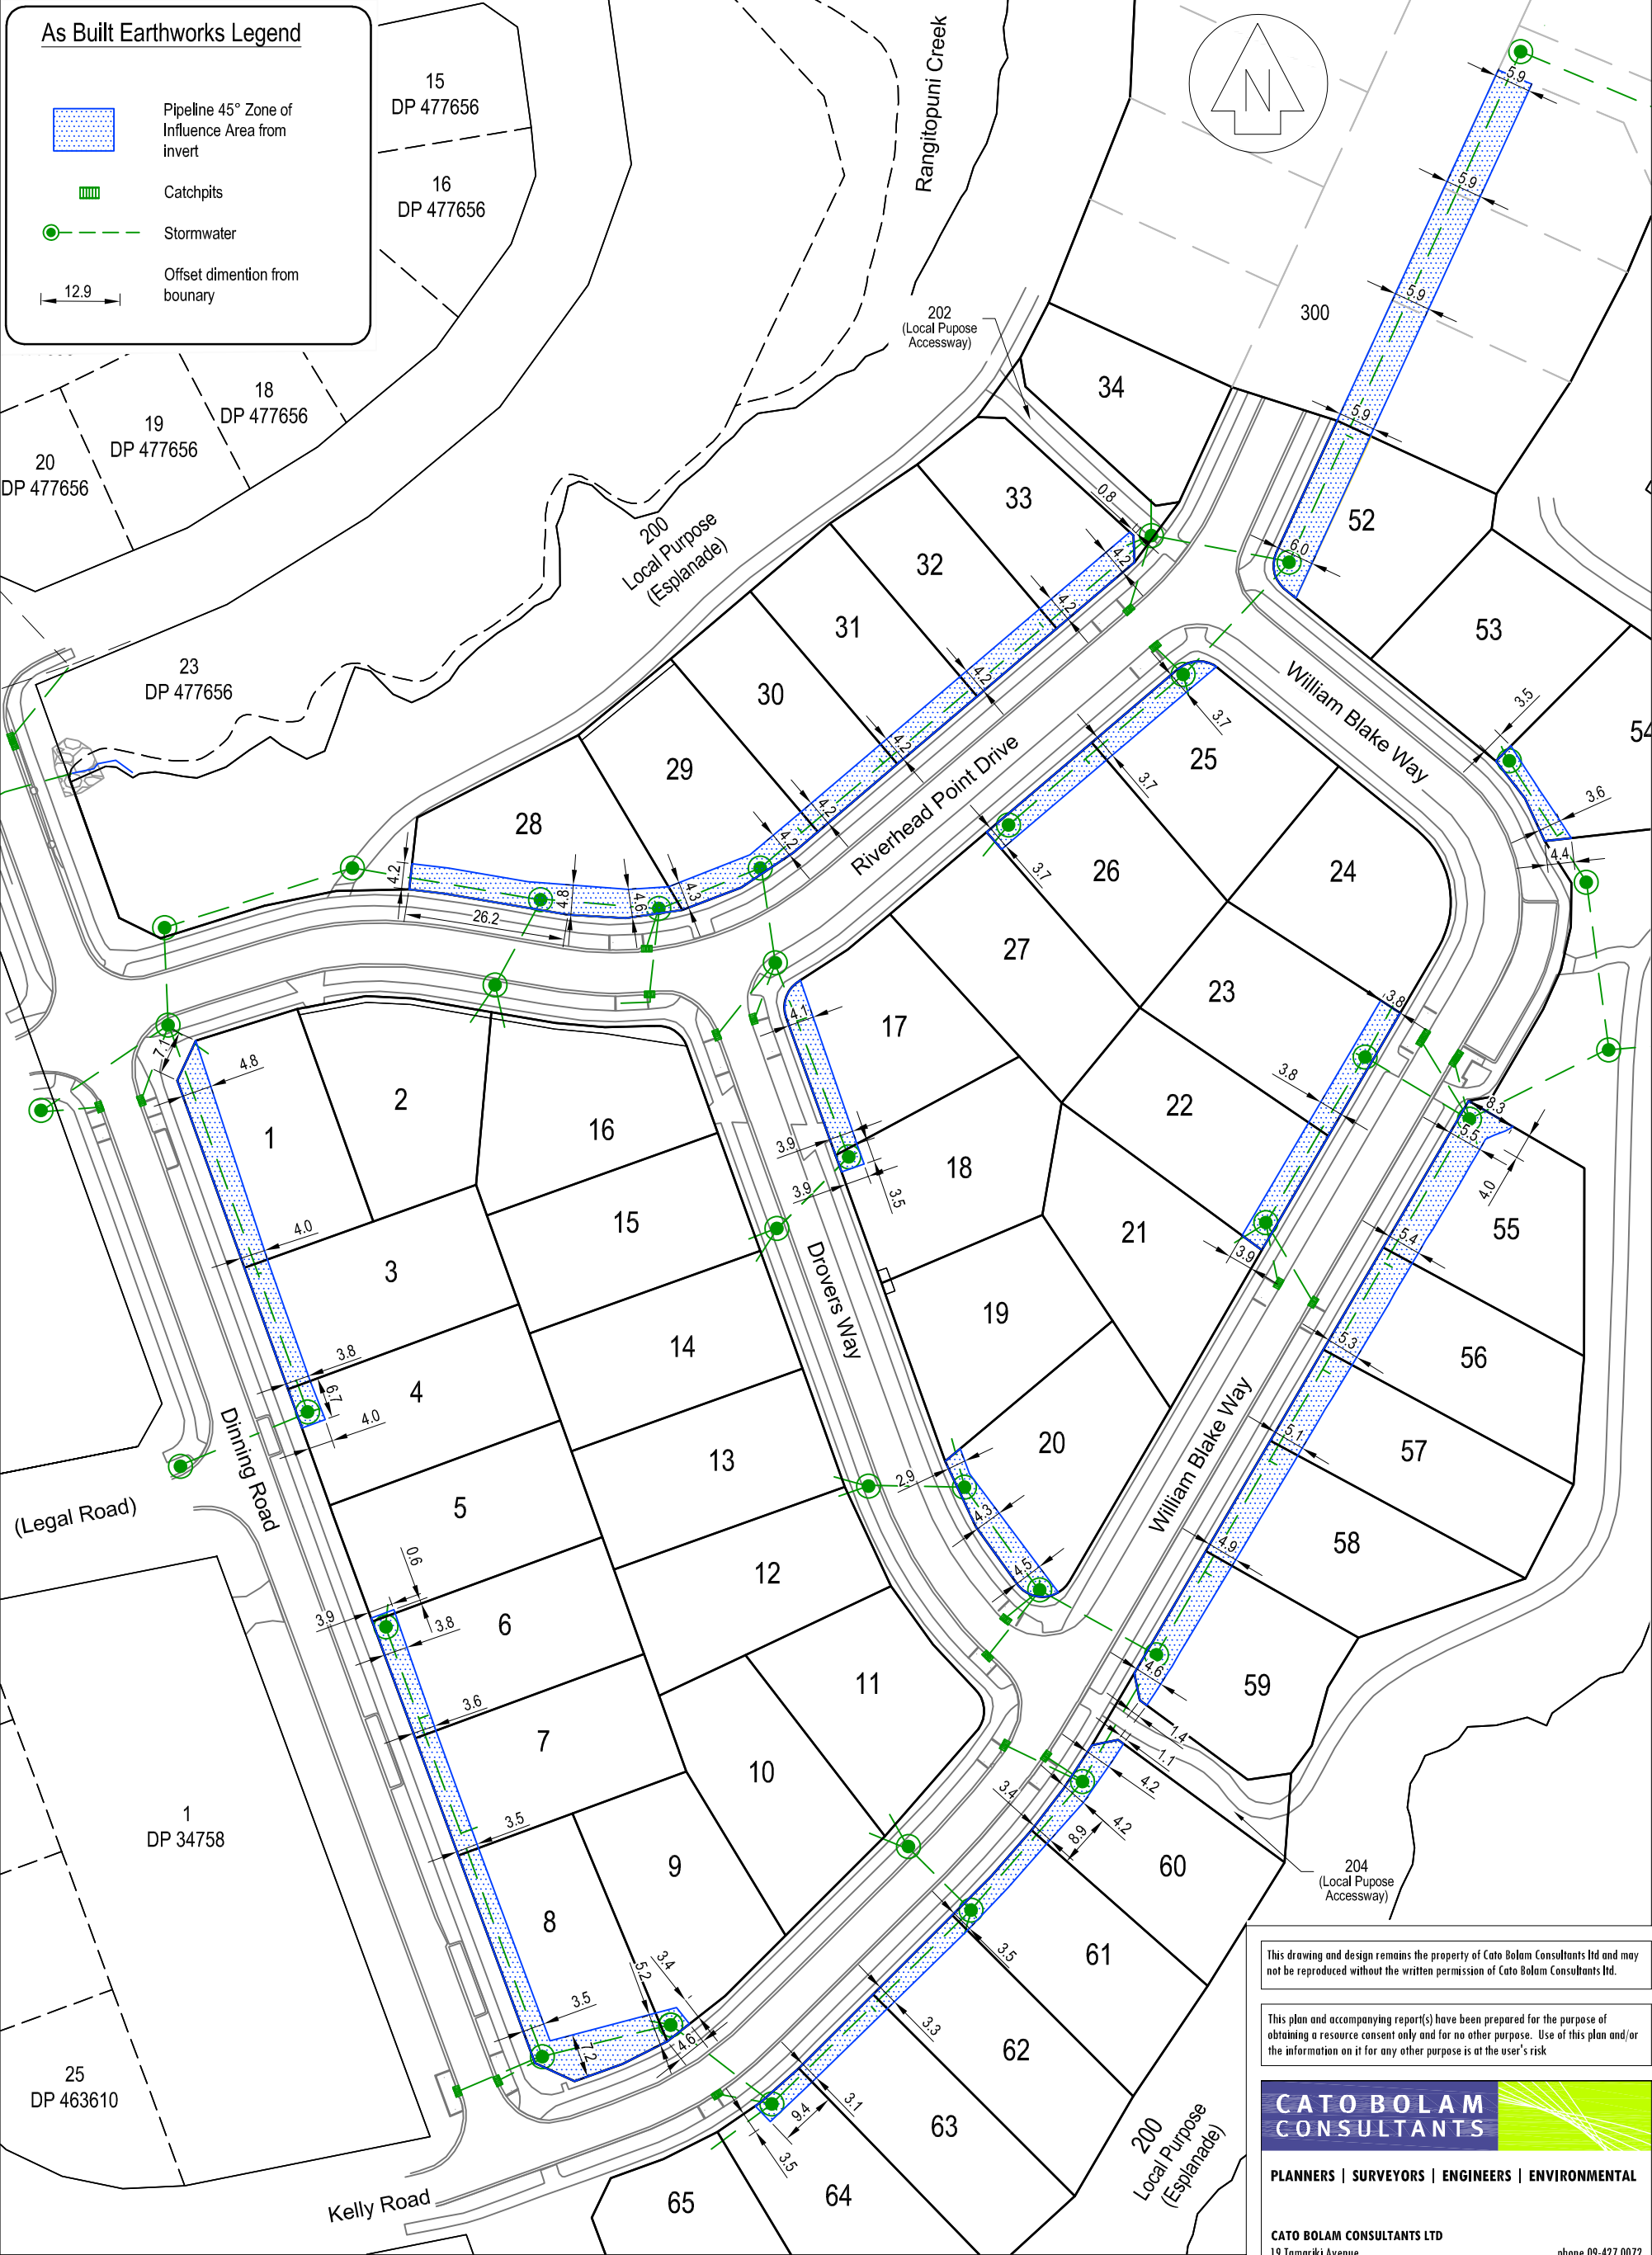

REVISION (DESCRIPTIONS)	NAME	DATE
SURVEYED	LD & AA	09/17
DESIGNED	AA	09/17
CHECKED	BM	09/17
APPROVED	TL	09/17

CLIENT

Cabra Developments Ltd
Deacon Point
Stages 1 & 2
Dinning Road, Riverhead

DRAWING TITLE

Stormwater Drainage Zone
of Influence Plan

This drawing and design remains the property of Cato Bolam Consultants Ltd and may not be reproduced without the written permission of Cato Bolam Consultants Ltd.

This plan and accompanying report(s) have been prepared for the purpose of obtaining a resource consent only and for no other purpose. Use of this plan and/or the information on it for any other purpose is at the user's risk.


CATO BOLAM CONSULTANTS

PLANNERS | SURVEYORS | ENGINEERS | ENVIRONMENTAL

CATO BOLAM CONSULTANTS LTD
19 Tamariki Avenue
PO Box 157
Orewa 0946

phone 09-427 0072
fax 09-426 7331
email [catobolam@catobolam.co.nz](mailto:cato bolam@catobolam.co.nz)

ORIGINAL SCALE 1:1000	ORIGINAL SIZE A3	REVISION NO
DATE 10/09/17	CAD REFERENCE 34147 E630	SHEET NO E630
DIRECTORY Z:\34147\Acad		JOB NO 34147

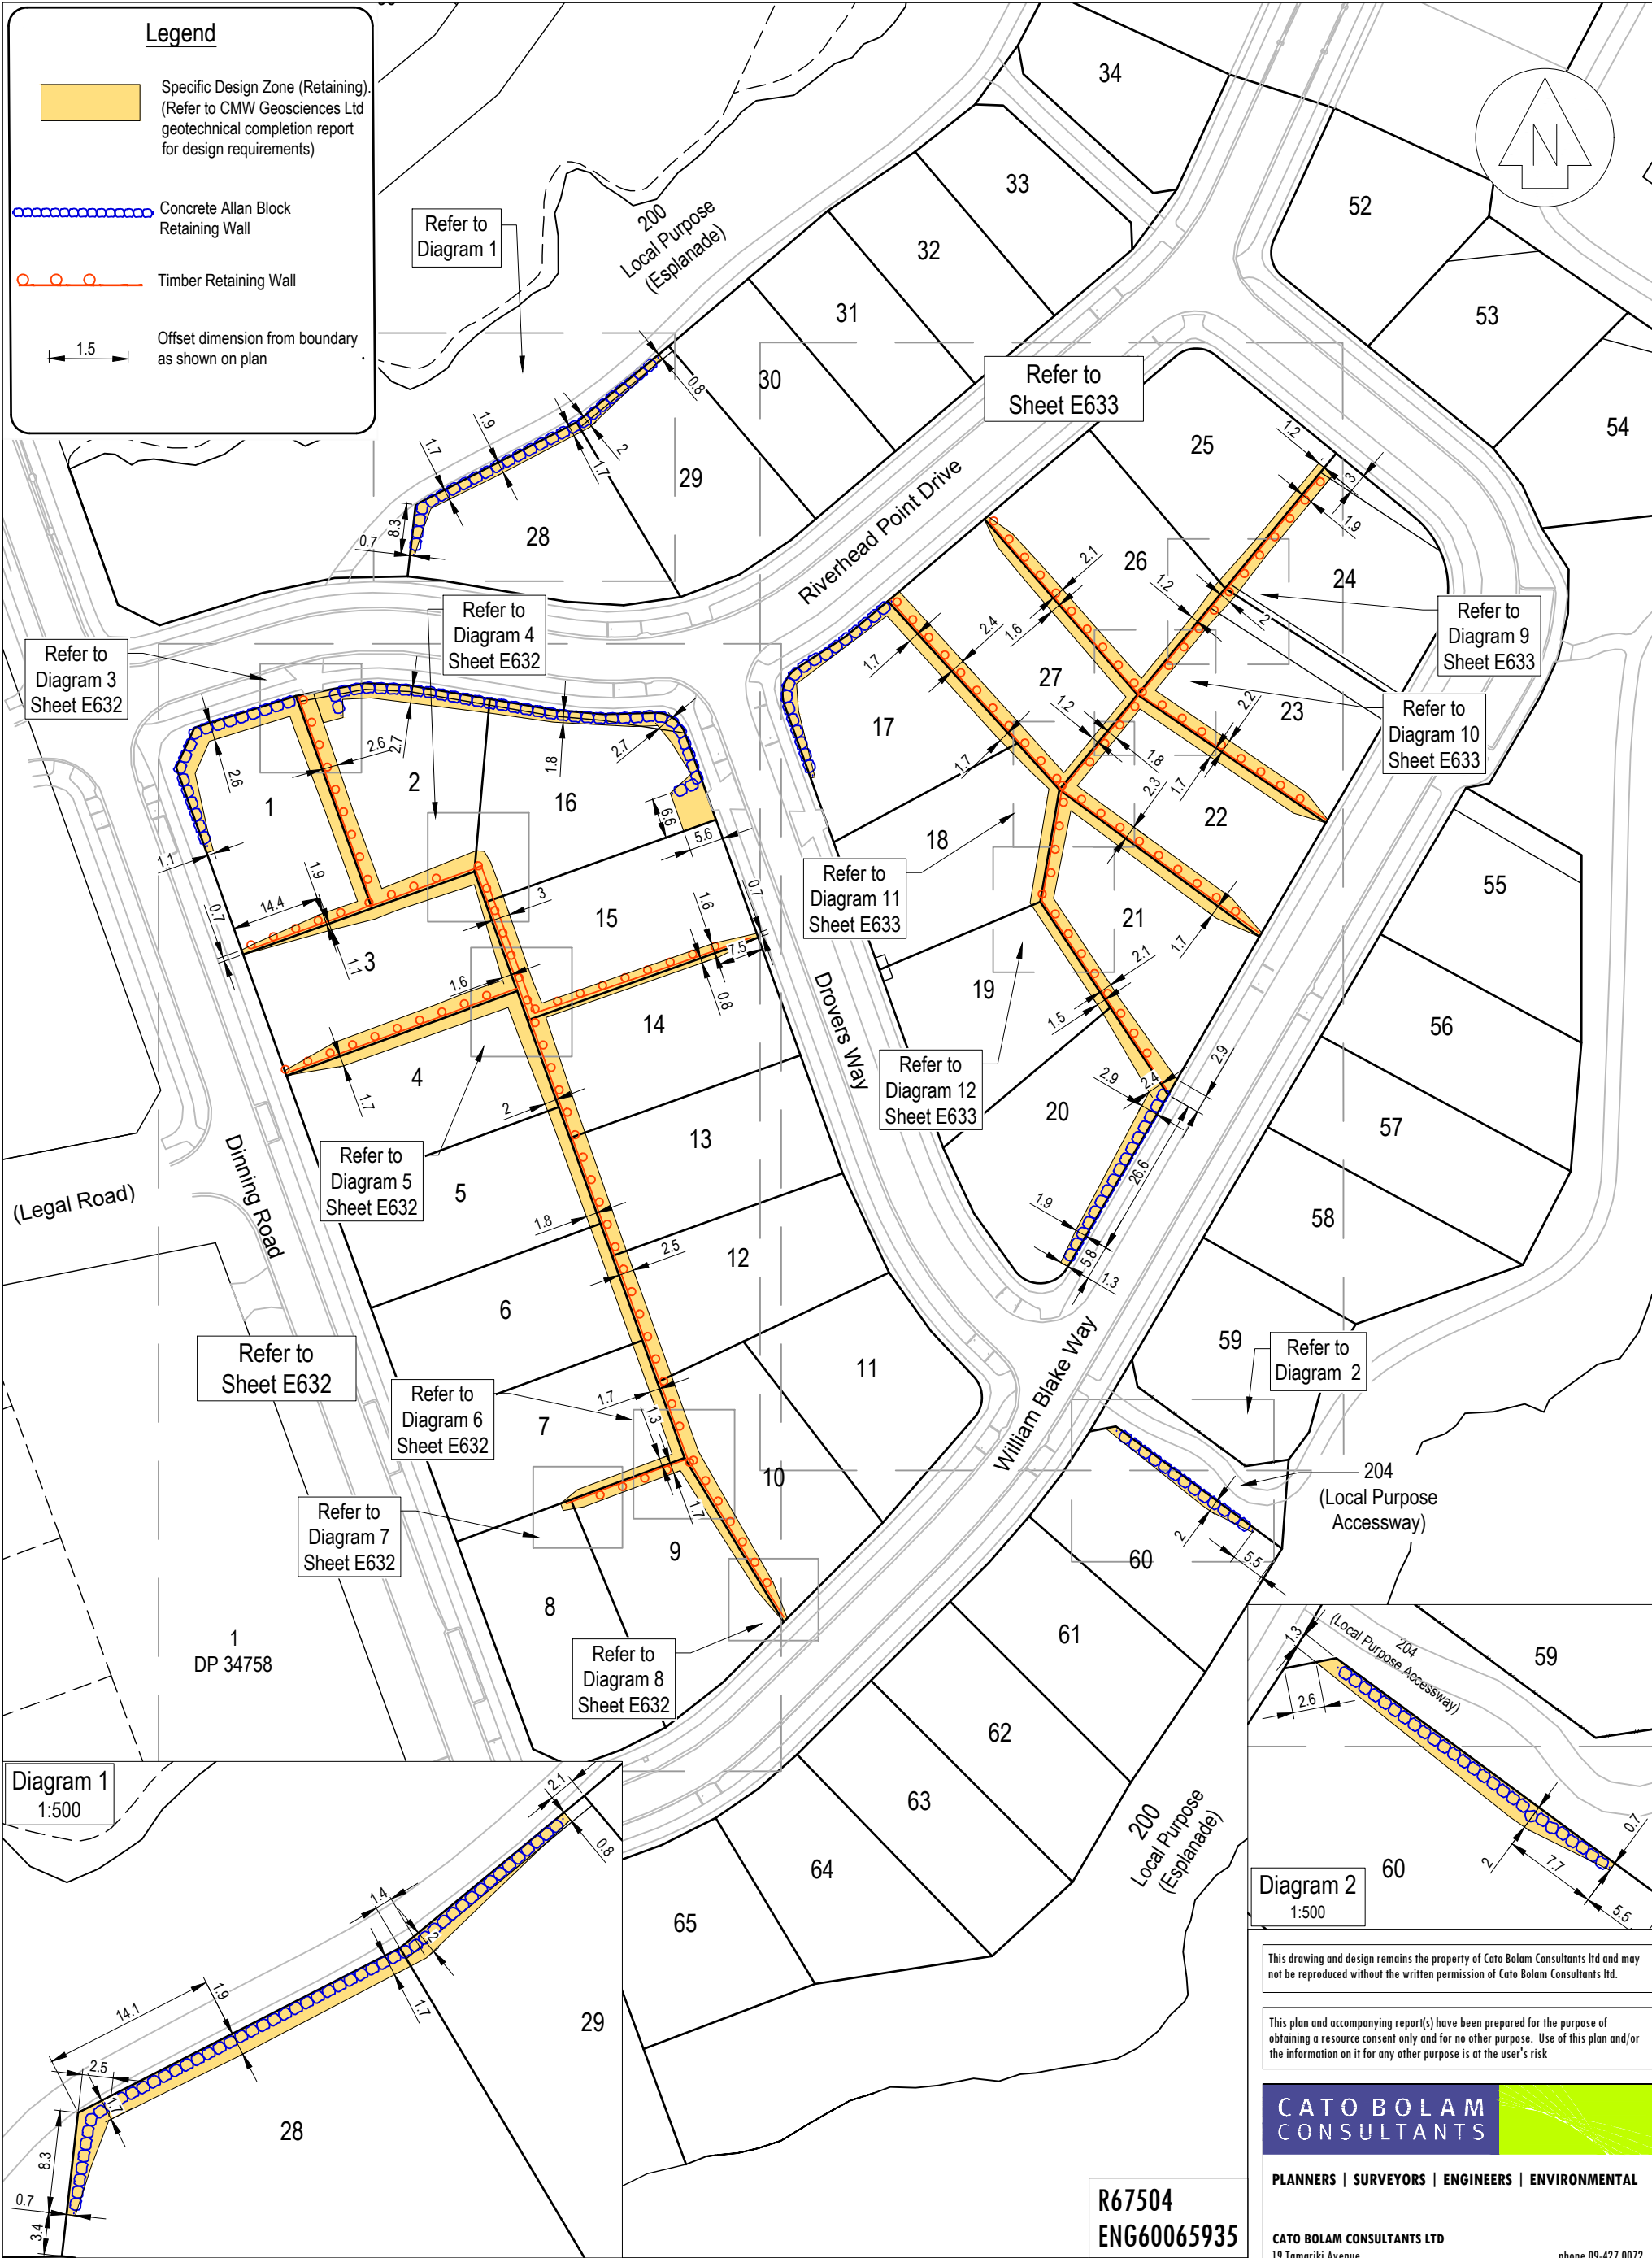





REVISION (DESCRIPTIONS)	NAME	DATE
SURVEYED	LD & BJ	09/17
DESIGNED	AA	09/17
DRAWN	BM	09/17
CHECKED	TL	09/17
APPROVED		

CLIENT

**Cabra Developments Ltd
Deacon Point
Stages 1 & 2
Dinning Road, Riverhead**

DRAWING TITLE

**Retaining Wall
Specific Design Plan
Sheet 1 of 3**

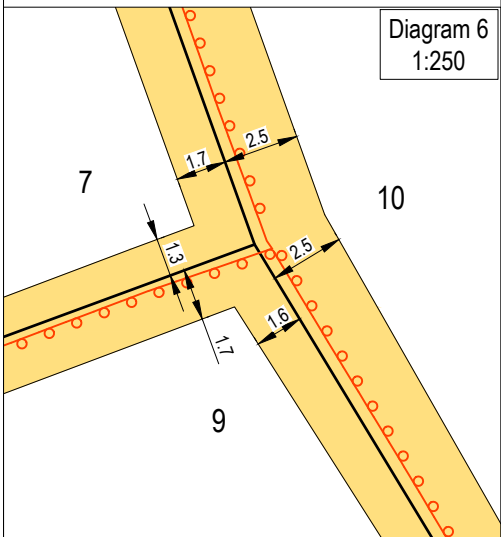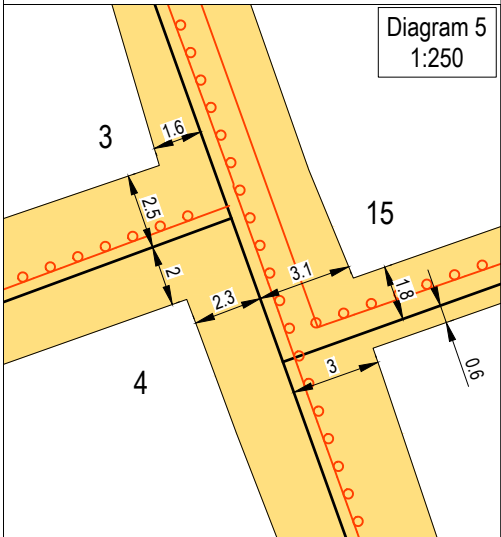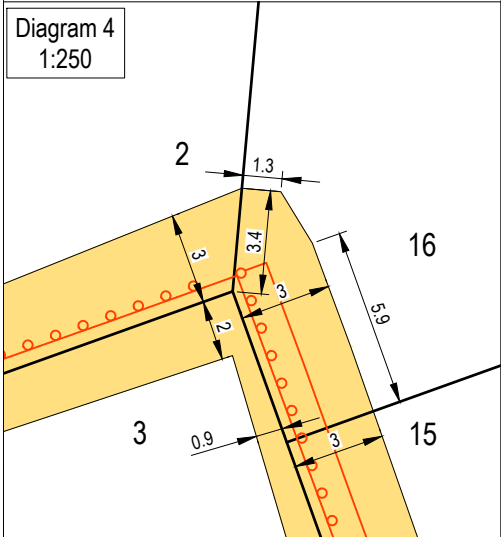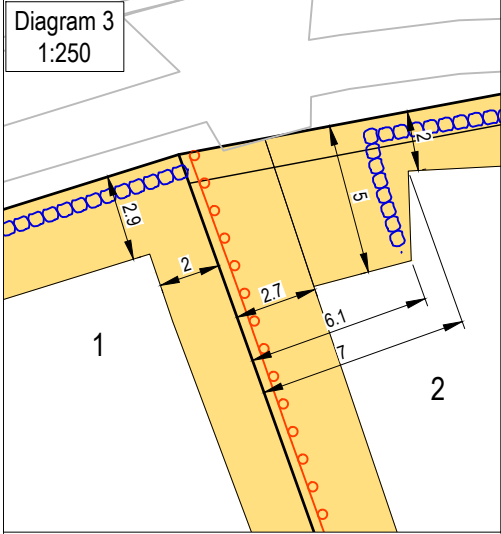

This drawing and design remains the property of Cato Bolam Consultants Ltd and may not be reproduced without the written permission of Cato Bolam Consultants Ltd.

This plan and accompanying report(s) have been prepared for the purpose of obtaining a resource consent only and for no other purpose. Use of this plan and/or the information on it for any other purpose is at the user's risk




CATO BOLAM CONSULTANTS

PLANNERS | SURVEYORS | ENGINEERS | ENVIRONMENTAL

CATO BOLAM CONSULTANTS LTD
19 Tamariki Avenue
PO Box 157
Orewa 0946

phone 09-427 0072
fax 09-426 7331
email catabolam@catabolam.co.nz

ORIGINAL SCALE	ORIGINAL SIZE	REVISION NO
1:500	A3	
DATE	CAD REFERENCE	SHEET NO
10/09/17	34147 E631-E63	E632
DIRECTORY		JOB NO
Z:\34147\Acad		34147

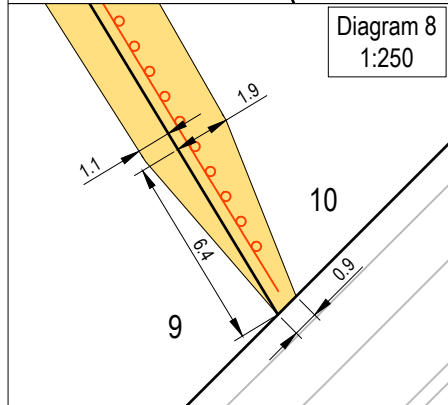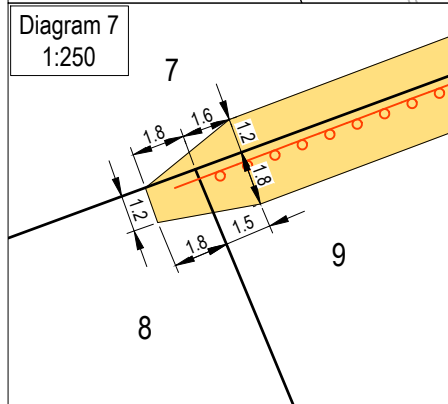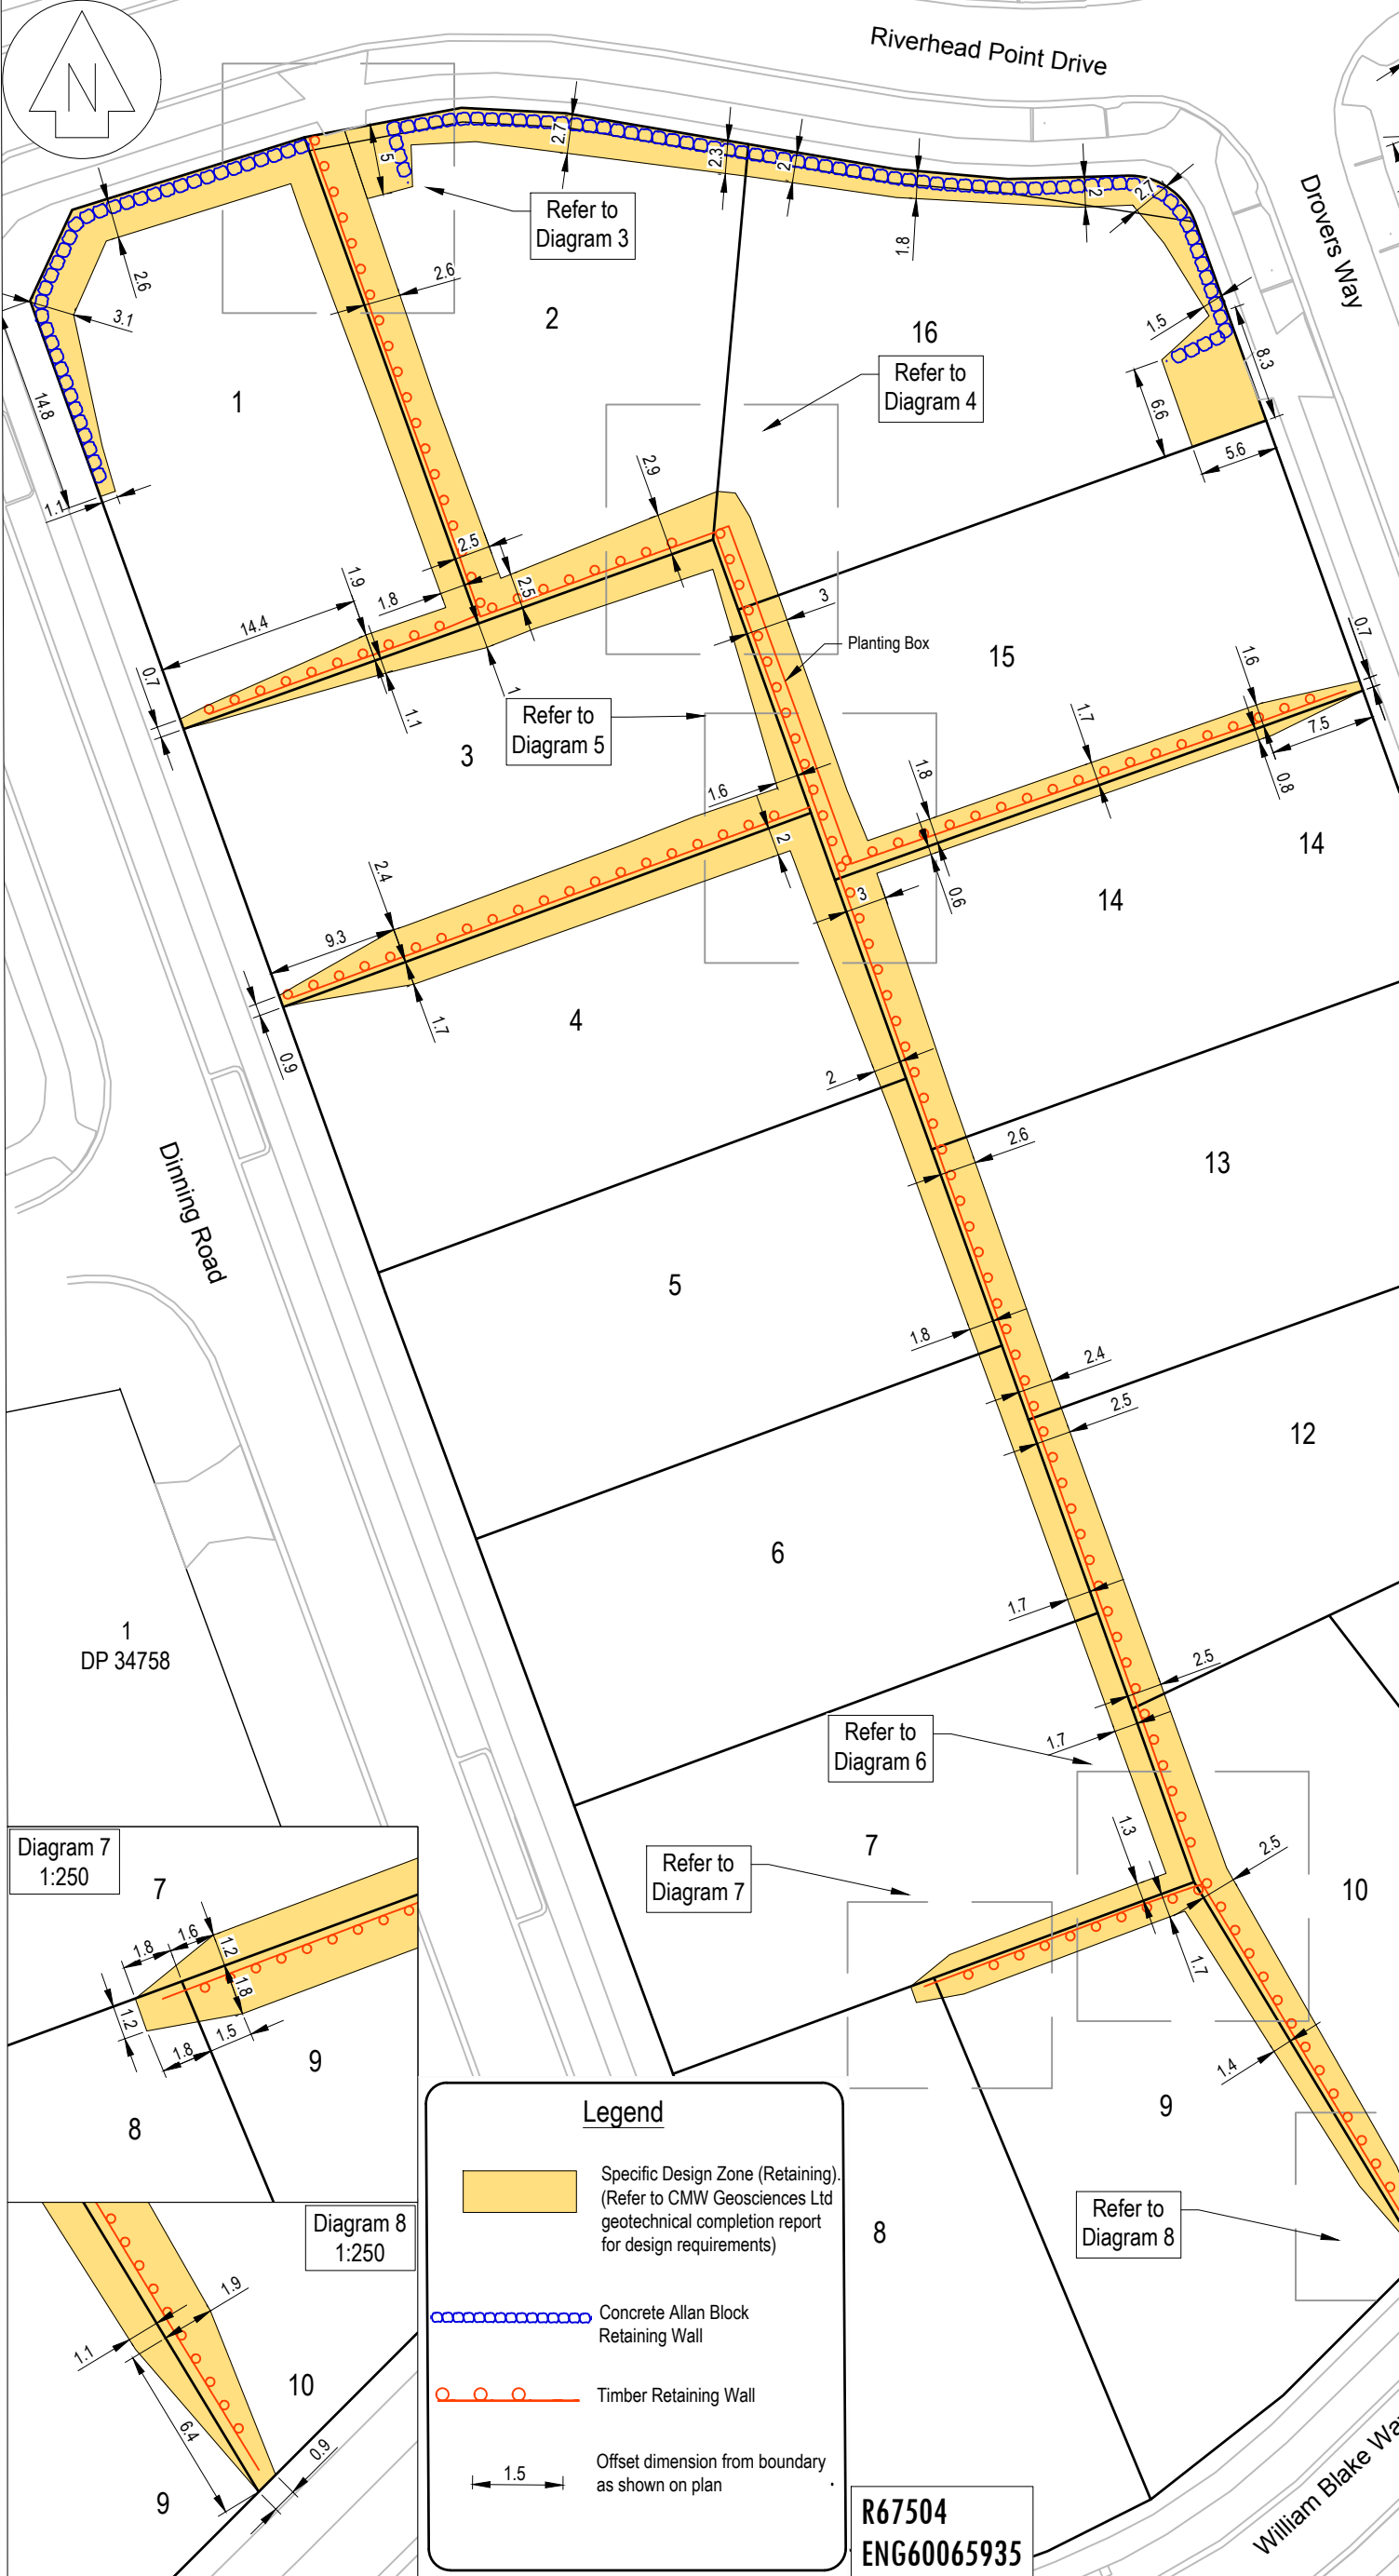

Legend

- Specific Design Zone (Retaining). (Refer to CMW Geosciences Ltd geotechnical completion report for design requirements)
- Concrete Allan Block Retaining Wall
- Timber Retaining Wall
- Offset dimension from boundary as shown on plan

1.5


R67504
ENG60065935

CLIENT

Cabra Developments Ltd
Deacon Point
Stages 1 & 2
Dinning Road, Riverhead

DRAWING TITLE

Retaining Wall
Specific Design Plan
Sheet 2 of 3

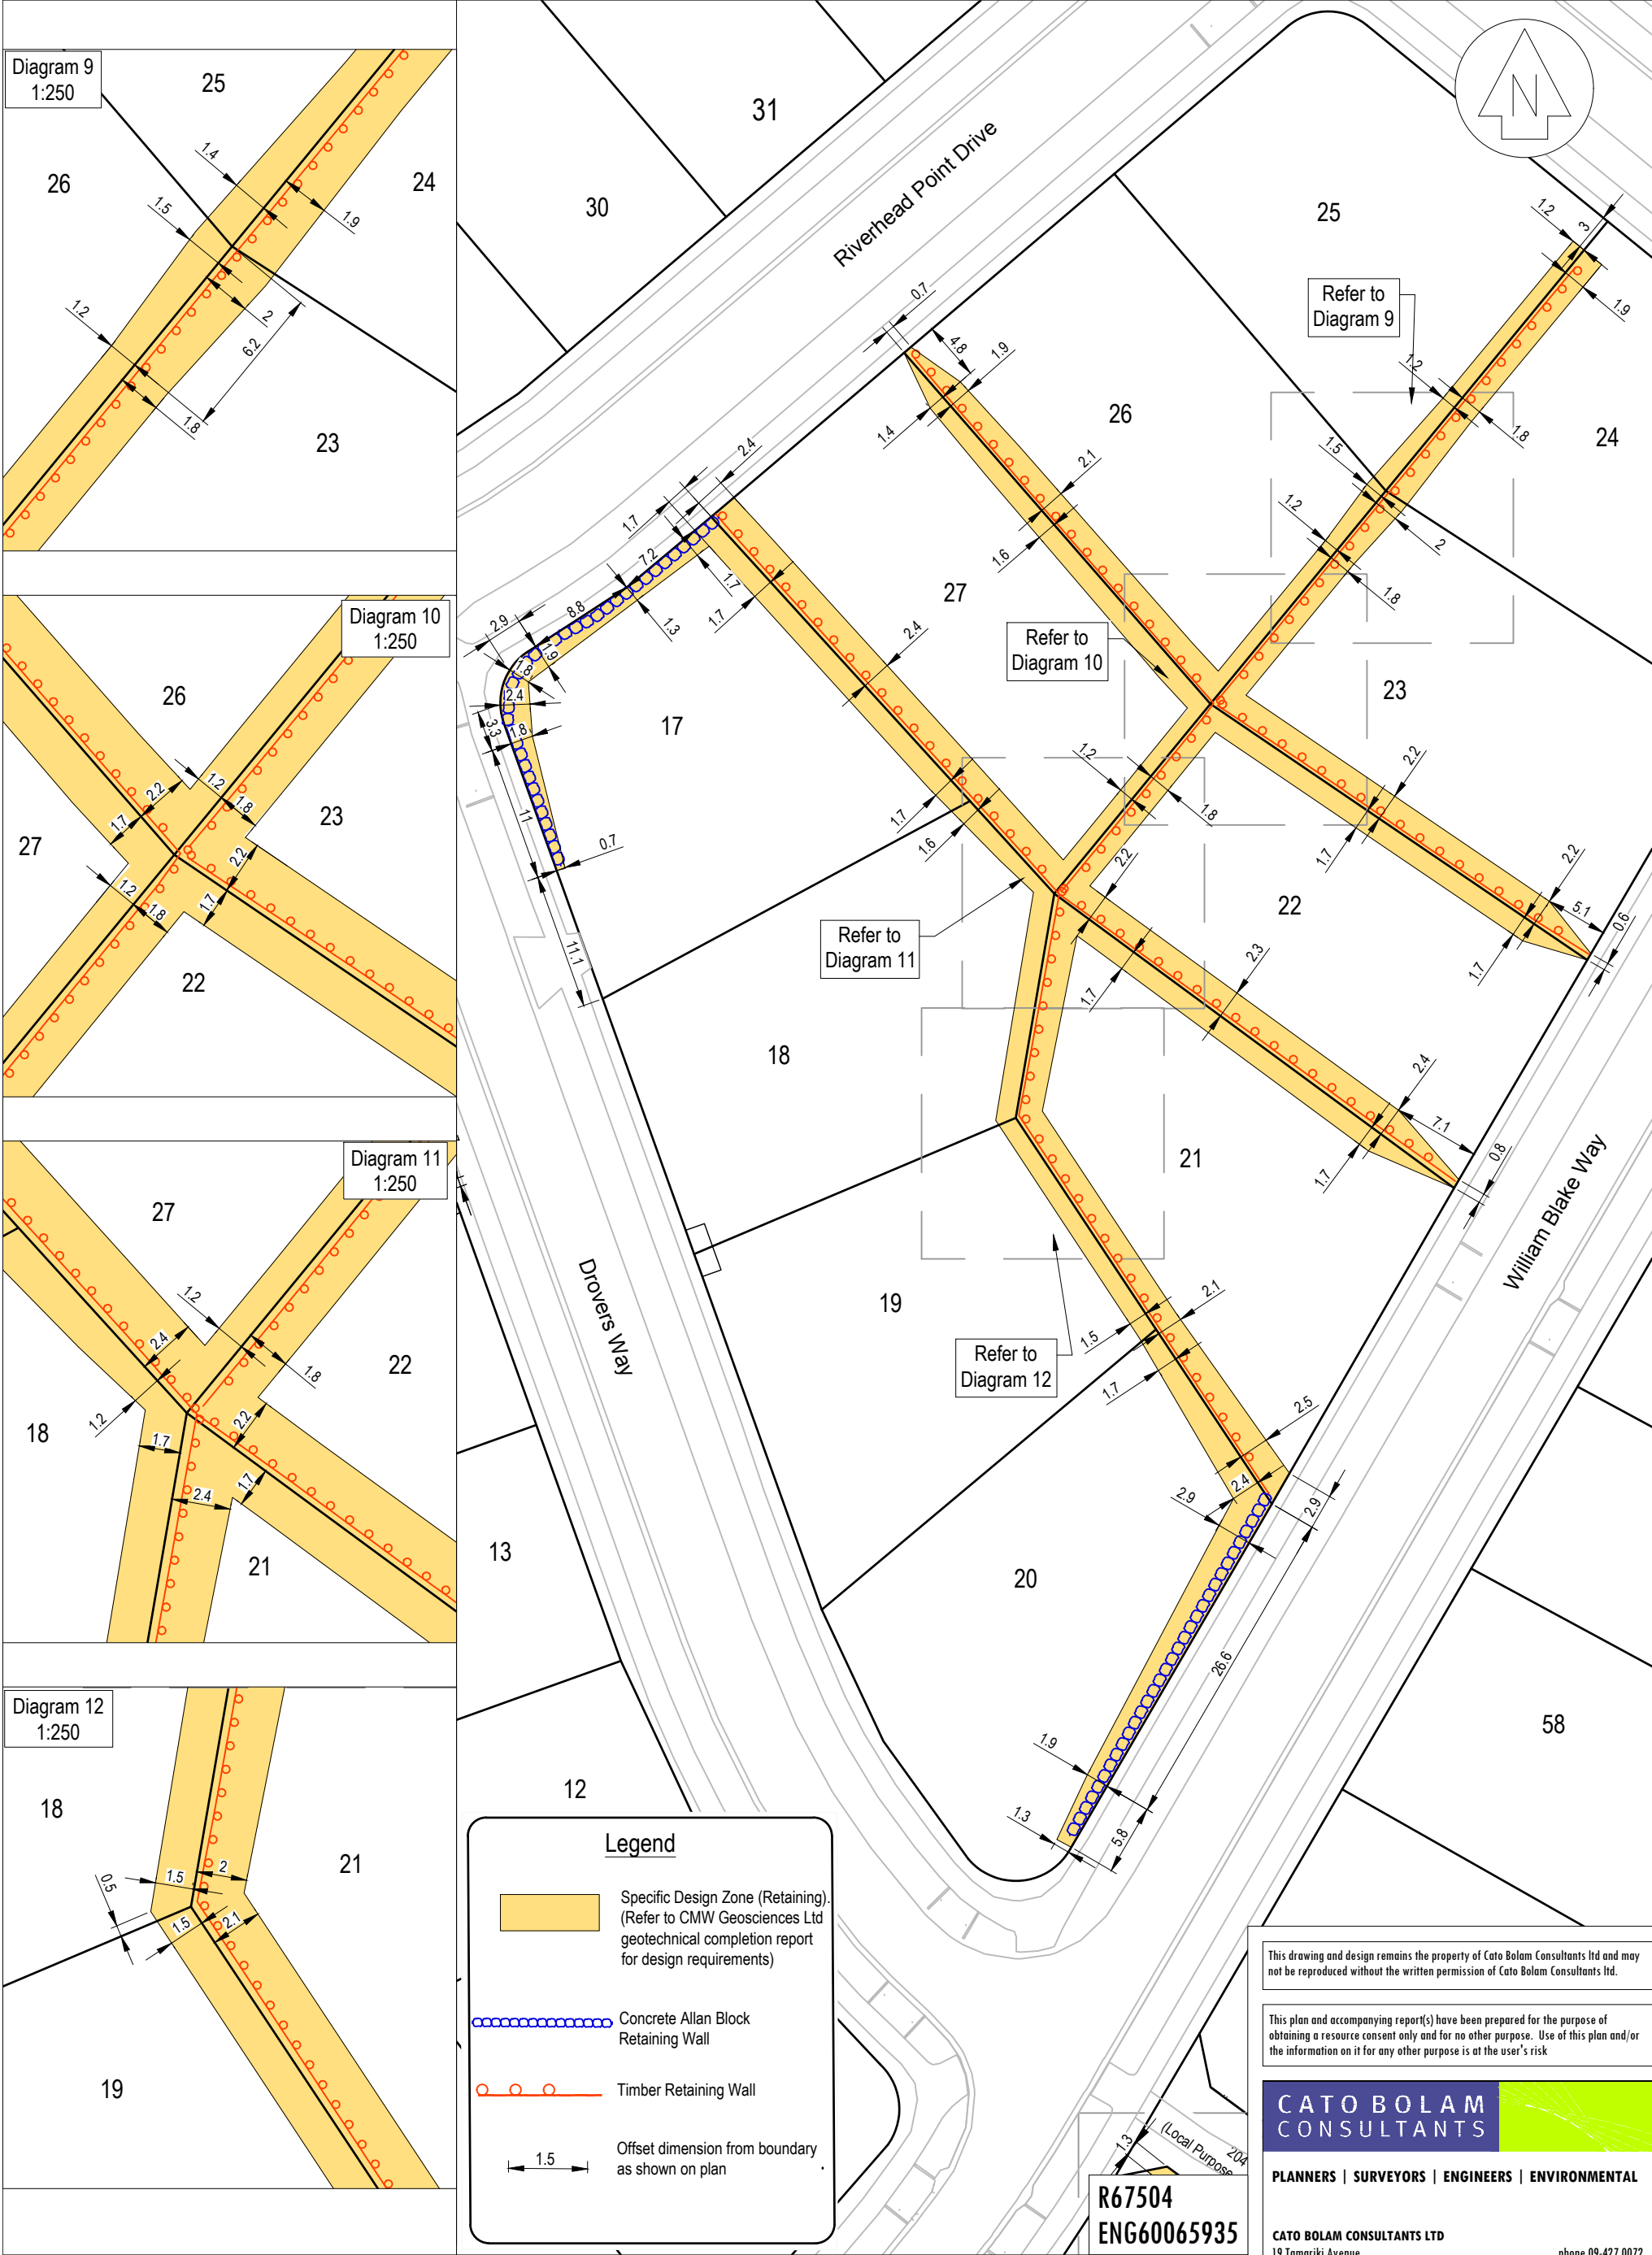

REVISION (DESCRIPTIONS)	NAME	DATE
SURVEYED	LD & BJ	09/17
DESIGNED	AA	09/17
DRAWN	BM	09/17
CHECKED	TL	09/17
APPROVED		

CLIENT

Cabra Developments Ltd
Deacon Point
Stages 1 & 2
Dinning Road, Riverhead

DRAWING TITLE

Retaining Wall
Specific Design Plan
Sheet 3 of 3

This drawing and design remains the property of Cato Bolam Consultants Ltd and may not be reproduced without the written permission of Cato Bolam Consultants Ltd.







This plan and accompanying report(s) have been prepared for the purpose of obtaining a resource consent only and for no other purpose. Use of this plan and/or the information on it for any other purpose is at the user's risk.

CATO BOLAM CONSULTANTS

PLANNERS | SURVEYORS | ENGINEERS | ENVIRONMENTAL

CATO BOLAM CONSULTANTS LTD
19 Tamariki Avenue
PO Box 157
Orewa 0946
phone 09-427 0072
fax 09-426 7331
email catoBolam@catoBolam.co.nz

ORIGINAL SCALE	ORIGINAL SIZE	REVISION NO
1:500	A3	
DATE	CAD REFERENCE	SHEET NO
10/09/17	34147 E631-E633	E633
DIRECTORY		JOB NO
Z:\34147\Acad		34147

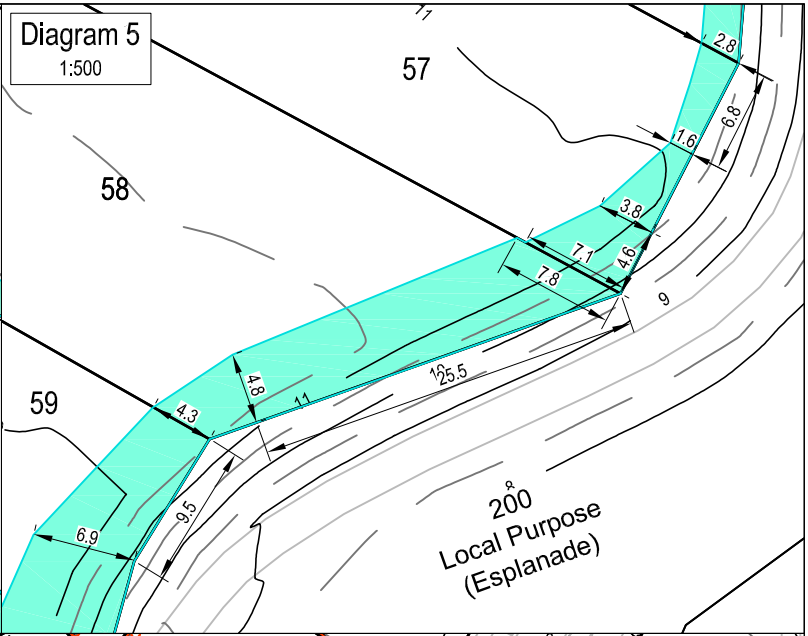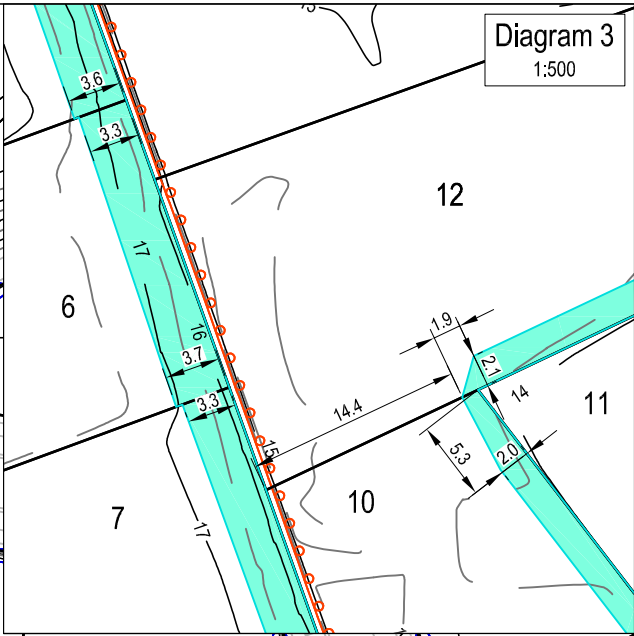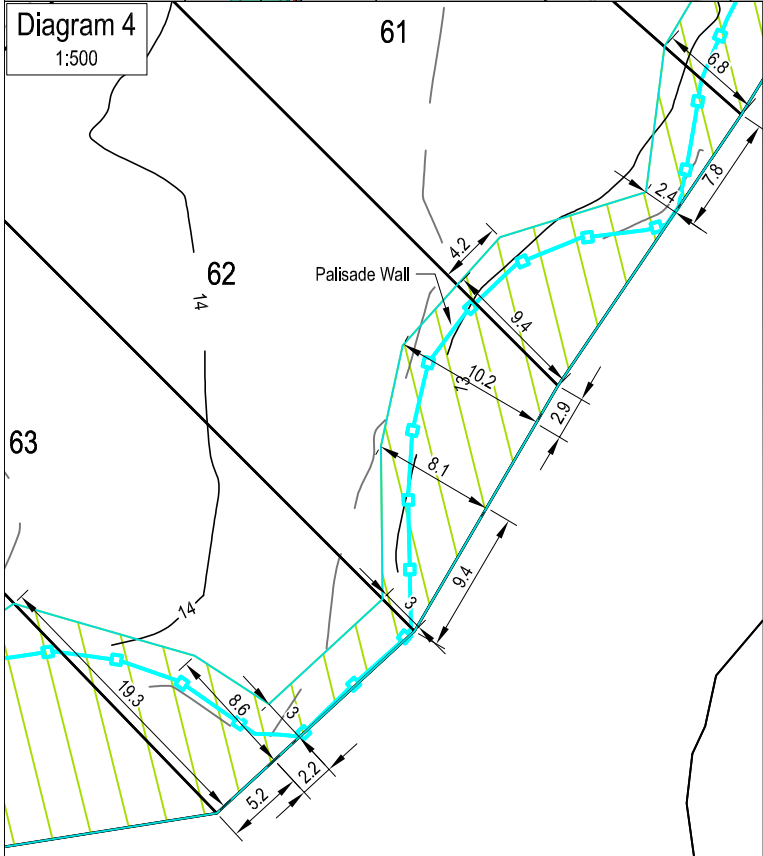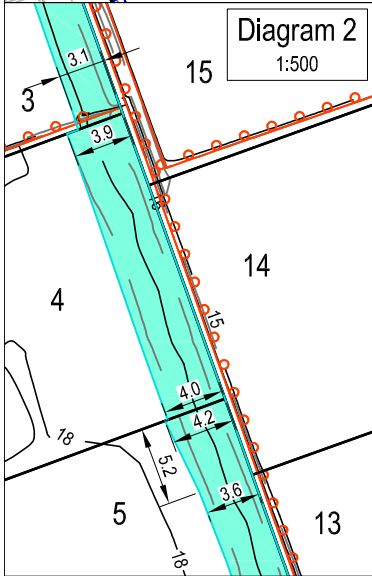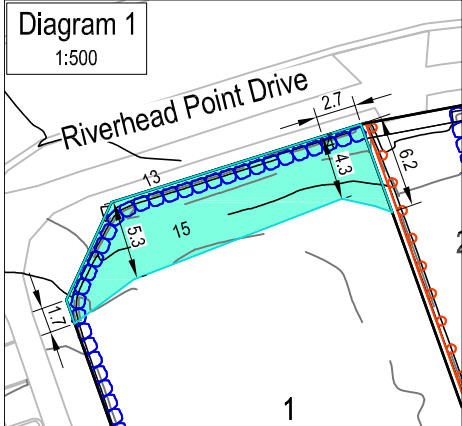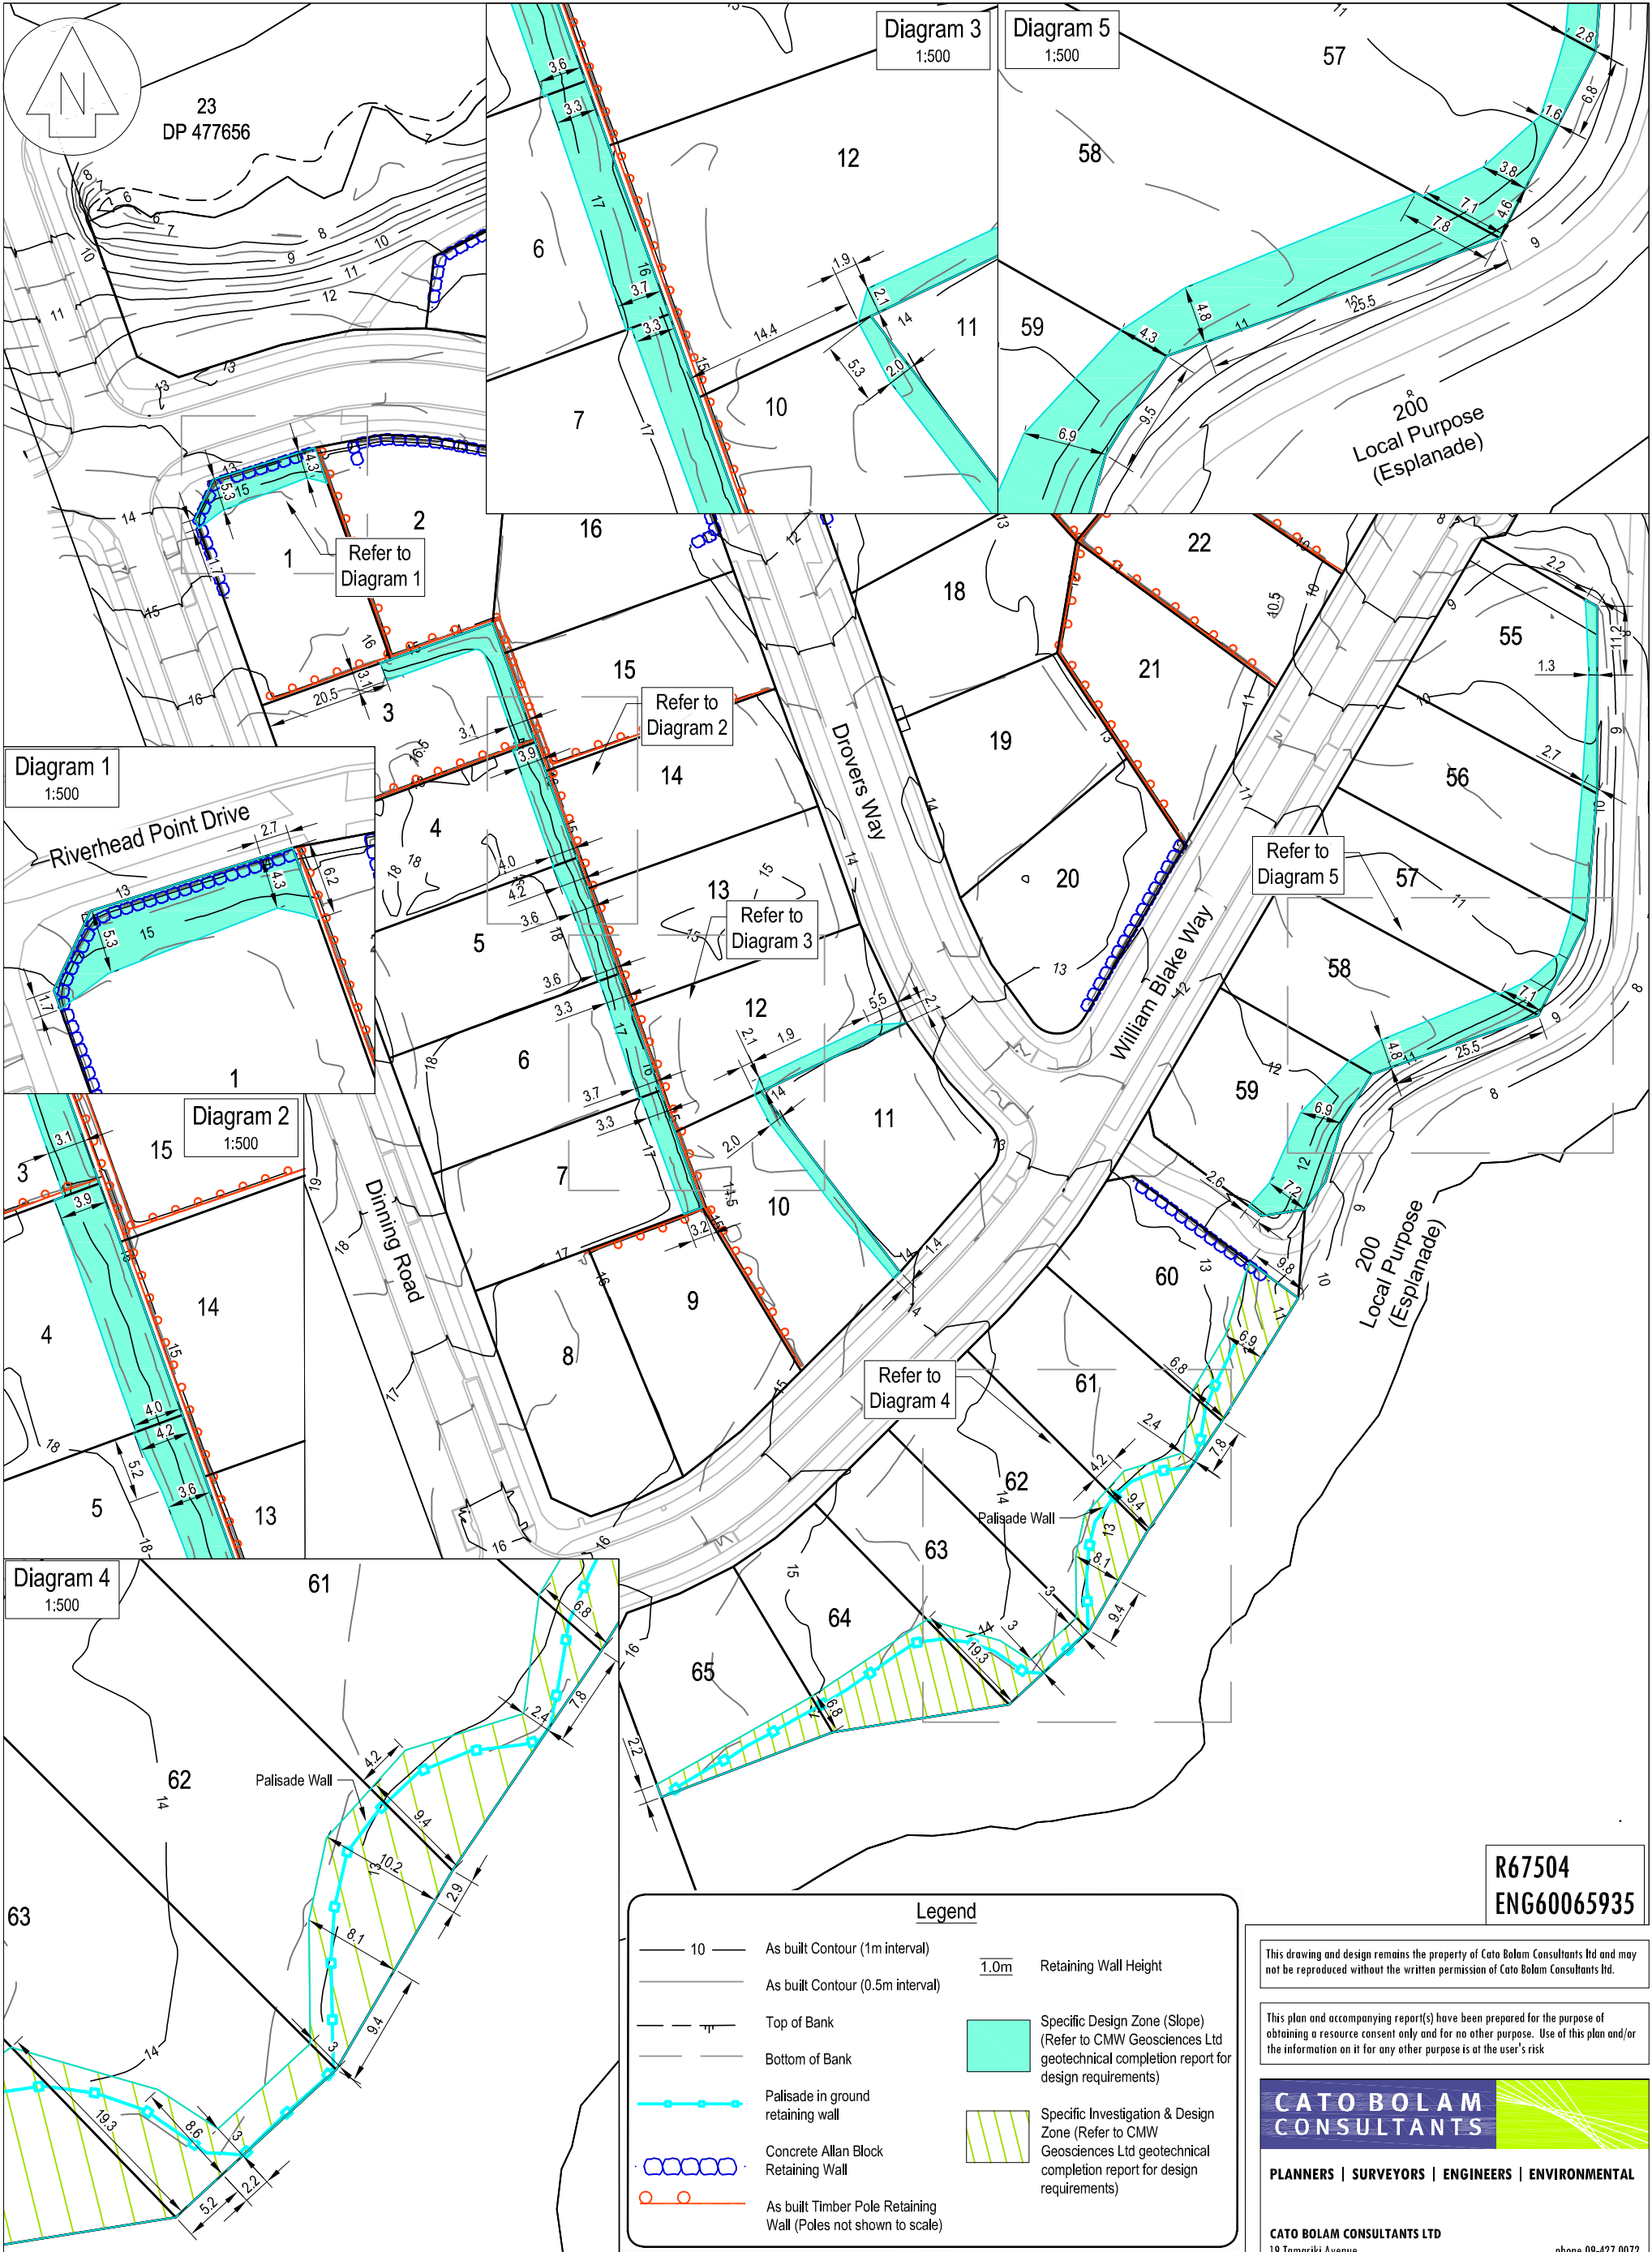

Legend

10

As built Contour (1m interval)

As built Contour (0.5m interval)

Top of Bank

Bottom of Bank

Palisade in ground retaining wall

Concrete Allan Block Retaining Wall

As built Timber Pole Retaining Wall (Poles not shown to scale)

1.0m

Retaining Wall Height

Specific Design Zone (Slope)
(Refer to CMW Geosciences Ltd geotechnical completion report for design requirements)

Specific Investigation & Design Zone (Refer to CMW Geosciences Ltd geotechnical completion report for design requirements)

R67504
ENG60065935

This drawing and design remains the property of Cato Bolam Consultants Ltd and may not be reproduced without the written permission of Cato Bolam Consultants Ltd.

This plan and accompanying report(s) have been prepared for the purpose of obtaining a resource consent only and for no other purpose. Use of this plan and/or the information on it for any other purpose is at the user's risk

CATO BOLAM CONSULTANTS

PLANNERS | SURVEYORS | ENGINEERS | ENVIRONMENTAL

CATO BOLAM CONSULTANTS LTD

19 Tamariki Avenue
PO Box 157
Orewa 0946

phone 09-427 0072
fax 09-426 7331
email cato bolam@cato bolam.co.nz

REVISION (DESCRIPTIONS)	NAME	DATE
SURVEYED	NAME	DATE
DESIGNED	LD & BJ	09/17
DRAWN	AA	09/17
CHECKED	BM	09/17
APPROVED	TL	09/17

CLIENT

Cabra Developments Ltd
Deacon Point
Stages 1 & 2
Dinning Road, Riverhead

DRAWING TITLE

Specific Design Restriction Zone Plan

ORIGINAL SCALE	ORIGINAL SIZE	REVISION NO
1:1000	A3	
DATE	CAD REFERENCE	SHEET NO
10/09/17	34147 E634	E634
DIRECTORY		JOB NO
Z:\34147\Acad		34147

Appendix C

Laboratory Test Data

Report No: 16 0033 00
Page: 1 of 1

**DETERMINATION OF THE
LIQUID LIMIT, PLASTIC LIMIT, PLASTICITY INDEX & LINEAR SHRINKAGE
TEST METHOD NZS 4402 : 1986 TEST 2.2, 2.3, 2.4 & 2.6**

Job:	29 Dinning Road		
Date of order:	19.2.16	Sample origin:	-
Sample method:	HA	Sample Description:	-
Sample By:	MB	Date:	18.2.16

Test Details :

Test performed on :	Whole Sample
History :	Natural

Sample No.	Location	Depth (m)	Liquid Limit (LL)	Plastic Limit (PL)	Plasticity Index (PI)	Linear Shrinkage (LS)	Natural Water Content (%)
E145A	HA2	0.8m - 1.2m	69	24	45	19	26.0
E146A	HA10	0.4m	31	21	10	6	18.6

Comments :

Tested By:	EC	Date :	24.02.16
Calculated By :	EC	Date :	25.02.16
Checked By :	EC	Date :	29.02.16

Report No: 17 0183 00
Page: 1 of 1**DETERMINATION OF THE LIQUID LIMIT & LINEAR SHRINKAGE
TEST METHOD NZS 4402 : 1986 TEST 2.2 & 2.6**

Job:	Dinning Road, Riverhead	Sample origin:	As below
Date of order:	-	Sample Description:	-
Sample method:	Hand auger	Date:	29.06.17
Sample By:	CMW Geosciences NZ Ltd		

Test Details :

Test performed on :	Whole Sample
History :	Natural

Sample No.	Location	Depth (m)	Liquid Limit	Linear Shrinkage	Natural Water Content (%)
418F	Lot 65	0.4 to 0.6	57	14	30.7
419F	Lot 16	0.4 to 0.6	56	16	30.7

Comments :

Tested By:	EC	Date :	14.07.17
Calculated By :	ZH	Date :	19.07.17
Checked By :	ZH	Date :	20.07.17

Report No: 17 0199 00
Page: 1 of 1**DETERMINATION OF THE LIQUID LIMIT & LINEAR SHRINKAGE
TEST METHOD NZS 4402 : 1986 TEST 2.2 & 2.6**

Job: **29 Dinning Road, Riverhead**
Date of order: 03.08.17
Sample method: Hand auger
Sample By: CMW Geosciences NZ Ltd

Sample origin: As below
Sample Description: -
Date: 26.07.17

Test Details :

Test performed on : Whole Sample
History : Natural

Sample No.	Location	Depth (m)	Liquid Limit	Linear Shrinkage	Natural Water Content (%)
433F	42	0.2 to 0.6	59	16	28.7
434F	51	0.2 to 0.6	50	13	28.3
435F	33	0.4 to 0.8	52	12	30.2
436F	57	0.2 to 0.5	60	15	28.1

Comments :

Tested By: SN & MW
Calculated By : ZH
Checked By : KH

Date : 04 to 07.08.17
Date : 11.08.17
Date : 11.08.17

Appendix D

Field Test Data

LF11 Rev 4 Soil Field Density NDM Direct Transmission with VSS Report

Auckland Laboratory
CMW Geosciences (NZ) Limited
Building C, 9 Piermark Drive, Rosedale, NZ 0632
PO Box 300206, Albany, Auckland, NZ 0752
Phone: +64 (09) 4144 632

Project: 29 Dinning Road, Riverhead
Project No: AKL2016_0326
Location: Riverhead
Report No: AKL2016_0326LAA Rev.0
Report Date: 5/12/2016
Client: Cabra Developments Limited
Client Address: PO Box 197, Orewa 0946
Client Reference:

Test Methods: NZS 4402.2.1:1986
NZS 4407.4.2.2:2015
NZGS: August 2001

Notes:
Solid Density: Assumed
Testing Locations Selected By: CMW Field Staff



Tests indicated as
not accredited are outside
the scope of the
laboratory's accreditation

Measurements marked * are not accredited
and are outside the scope of the laboratory's
accreditation

Date Sampled	Sample No.	Test Location	Soil Description	In-situ Vane Shear Strengths					Field and Laboratory Testing Data									Comments
				Test 1 (kPa)	Test 2 (kPa)	Test 3 (kPa)	Test 4 (kPa)	Ave.	Gauge Wet Density (t/m ³)	Gauge Dry Density (t/m ³)	Gauge Water Content (%)	Gauge Air Voids (%)	Gauge Probe Depth	Oven Water Content (%)	Solid Density (t/m ³) *	Oven Dry Density (t/m ³)	Calculated Air Voids (%)	
21/10/2016	N1	Lot 1	CLAY	119	113	127	132	123	1.7840	1.3086	36.3	3.89	300	41.8	2.7	1.26	0.83	Failed
	N2	Road 1	CLAY	94	103	100	113	103	1.7893	1.2463	43.6	-0.58	300	40.9	2.7	1.28	1.0	Failed
28/10/2016	N3	Road 1	CLAY	>189	>189	162	189	>182	1.8754	1.4339	30.8	2.65	300	28.8	2.7	1.46	4.1	Re-test of N2
	N4	Lot 1	CLAY	>189	>189	>189	>189	>189	1.8459	1.4006	31.8	3.49	300	29.7	2.7	1.42	5.0	Re-test of N1
1/11/2016	N5	Lot 1	CLAY	UTP	UTP	UTP	UTP	UTP	1.8568	1.4171	31.0	3.45	300	25.1	2.7	1.48	7.8	
	N6	Road 1 Entrance	CLAY	UTP	UTP	UTP	UTP	UTP	1.8781	1.4157	32.7	1.23	300	31.0	2.7	1.44	2.4	
3/11/2016	N7	Lot 3	CLAY	186	167	154	173	170	1.8372	1.3599	35.1	1.80	300	30.2	2.7	1.42	5.1	
	N8	Lot 1	CLAY	181	186	UTP	UTP	184	1.8323	1.3963	31.2	4.59	300	31.6	2.7	1.40	4.5	
10/11/2016	N9	Lot 60	CLAY	148	159	178	189	169	1.9667	1.5537	26.6	1.06	250	24.2	2.7	1.58	3.0	
	N10	Lot 59	CLAY	146	159	159	165	157	1.8702	1.4299	30.8	2.91	300	27.3	2.7	1.46	5.5	
	N11	Counterfort 1 North	CLAY	151	186	189	151	169	1.8963	1.4274	32.9	0.13	300	30.5	2.7	1.46	1.9	
	N12	Lot 28	CLAY	159	151	178	189	169	1.8746	1.4222	31.8	1.98	300	29.9	2.7	1.44	3.4	
11/11/2016	N13	West Gully	CLAY	154	159	140	148	150	1.8919	1.4524	30.3	2.16	300	29.9	2.7	1.46	2.5	
	N14	West Gully	CLAY	178	189	>189	>189	>186	1.8613	1.4147	31.6	2.85	300	30.3	2.7	1.42	3.8	
22/11/2016	N15	Lot 60	CLAY	189	151	165	189	174	1.9591	1.5290	28.1	0.26	300	23.9	2.7	1.58	3.7	
	N16	Lot 11	CLAY	189	148	189	165	173	1.9240	1.5193	26.6	3.17	300	26.3	2.7	1.52	3.5	
	N17	Lot 9	CLAY	165	140	189	189	171	1.9545	1.5419	26.8	1.54	300	23.8	2.7	1.58	4.0	
	N18	West of Lot 7	CLAY	189	189	146	157	170	1.8578	1.4319	29.7	4.29	300	29.4	2.7	1.44	4.6	
	N19	South of Lot 23	CLAY	165	189	>189	>189	>183	1.9085	1.5348	24.3	5.71	300	26.4	2.7	1.50	4.2	
	N20	North of Lot 55	CLAY	UTP	UTP	UTP	UTP	UTP	1.8741	1.4089	33.0	1.20	300	24.7	2.7	1.50	7.2	
24/11/2016	N21	Lot 22	Sandy CLAY	181	165	147	178	168	1.9493	1.5666	24.4	3.62	300	23.3	2.7	1.58	4.6	
	N22	South of Lot 23	Sandy CLAY	140	151	140	146	144	1.9840	1.5828	25.3	1.17	300	24.9	2.7	1.58	1.6	
29/11/2016	N23	Lot 11	CLAY	>189	>189	UTP	UTP	>189	1.9533	1.6101	21.3	5.97	250	22.1	2.7	1.60	5.4	
	N24	Lot 9	CLAY	UTP	UTP	UTP	UTP	UTP	2.0175	1.5963	26.4	-1.34	300	24.5	2.7	1.62	0.29	
	N25	Lot 1 N	CLAY	159	167	167	178	168	1.9583	1.5634	25.3	2.52	300	26.2	2.7	1.56	1.9	
	N26	Lot 1 S	CLAY	159	162	170	154	161	1.9076	1.5170	25.7	4.67	300	24.1	2.7	1.54	6.0	
2/12/2016	N27	Lot 10	CLAY	146	140	165	165	154	1.8827	1.5055	25.0	6.44	300	22.9	2.7	1.54	8.2	

This report should only be reproduced in full.

Created By: TG
Checked By: TG
Authorised Signatory: 

Date: 5/12/2016
Date: 6/12/2016
Date: 6/12/2016



CATO BOLAM CONSULTANTS

SURVEYORS PLANNERS ENGINEERS

CATO BOLAM CONSULTANTS LTD

19 Tanjongi Avenue

PO Box 157

Orissa 75106

ph: 067-427 0072

fax: 067-424 7331

email: cato@catobolam.com

ORIGINAL SCALE

1 : 1500

ORIGINAL SIZE

A3

DATE

12/04/2015

REVISION NO

R1

CAD REFERENCE

34147 E101 Cui Fui

SHEET NO

E104

DIRECTORY

34147 E101

JOB NO

34147

LF11 Rev 4 Soil Field Density NDM Direct Transmission with VSS Report

Auckland Laboratory
CMW Geosciences (NZ) Limited
Building C, 9 Piermark Drive, Rosedale, NZ 0632
PO Box 300206, Albany, Auckland, NZ 0752
Phone: +64 (09) 4144 632

Project: 29 Dinning Road, Riverhead
Project No: AKL2016_0326
Location: Riverhead
Report No: AKL2016_0326LAB Rev.0
Report Date: 11/01/2017
Client: Cabra Developments Limited
Client Address: PO Box 197, Orewa 0946
Client Reference:

Test Methods: NZS 4402.2.1:1986
NZS 4407.4.2.2:2015
NZGS:August 2001

Notes: Solid Density: Assumed
Testing Locations Selected By: CMW Field Staff



Tests indicated as not accredited are outside the scope of the laboratory's accreditation

Measurements marked * are not accredited and are outside the scope of the laboratories accreditation

Date Sampled	Sample No.	Test Location	Soil Description	In-situ Vane Shear Strengths					Field and Laboratory Testing Data								Comments
				Test 1 (kPa)	Test 2 (kPa)	Test 3 (kPa)	Test 4 (kPa)	Ave.	Gauge Wet Density (t/m ³)	Gauge Dry Density (t/m ³)	Gauge Water Content (%)	Gauge Air Voids (%)	Gauge Probe Depth	Oven Water Content (%)	Solid Density (t/m ³)*	Oven Dry Density (t/m ³)	
2/12/2016	N28	Lot 60	CLAY	178	189	UTP	UTP	184	1.9852	1.6217	22.4	3.50	300	25.0	2.7	1.58	1.5
	N29	Lot 59	CLAY	165	159	189	UTP	171	1.9678	1.5679	25.5	1.85	300	30.2	2.7	1.52	-1.6
5/12/2016	N30	Lot 6	CLAY	189	189	>189	>189	>189	1.9432	1.5263	27.3	1.68	250	29.9	2.7	1.50	-0.2
	N31	Lot 6	CLAY	151	186	189	189	179	1.9223	1.4771	30.8	0.68	200	29.9	2.7	1.48	1.0
	N32	Lot 59	CLAY	189	148	146	186	167	1.9470	1.5538	25.3	3.04	300	23.2	2.7	1.58	4.8
	N33	Lot 58	CLAY	162	151	189	189	173	1.8824	1.4506	29.8	3.00	300	29.6	2.7	1.46	3.2
7/12/2016	N34	Lot 8	Sandy CLAY	162	162	167	151	161	1.9153	1.5425	24.2	5.51	300	24.8	2.7	1.54	5.1
	N35	Lot 7	Sandy CLAY	UTP	UTP	UTP	UTP	UTP	1.9377	1.5994	21.1	6.86	300	21.8	2.7	1.60	6.4
	N36	Lot 59	Sandy CLAY	151	159	162	167	160	1.9168	1.5227	25.9	4.10	300	26.8	2.7	1.52	3.5
	N37	Road between Lot 23 and Lot 55	Sandy CLAY	173	159	143	146	155	1.9195	1.4946	28.4	2.06	300	27.7	2.7	1.50	2.7
15/12/2016	N38	Refer to site plan	CLAY	UTP	UTP	UTP	UTP	UTP	1.9100	1.5186	25.8	4.53	300	36.7	2.7	1.40	-3.0
	N39	Lot 59	CLAY	UTP	UTP	UTP	UTP	UTP	1.9302	1.5066	28.1	1.74	300	28.2	2.7	1.50	1.8
	N40	Refer to site plan	CLAY	173	162	>189	178	>176	1.9091	1.5374	24.2	5.81	300	25.8	2.7	1.52	4.6
	N41	Lot 59	CLAY	189	178	148	154	167	1.9089	1.5013	27.1	3.55	300	27.1	2.7	1.50	3.7
20/12/2016	N42	Lot 58	CLAY	189	189	>189	>189	>189	1.8870	1.4821	27.3	4.53	300	28.1	2.7	1.48	4.0
	N43	Road between Lot 23 and Lot 55	CLAY	UTP	UTP	UTP	UTP	UTP	1.9756	1.5890	24.3	2.40	300	19.9	2.7	1.64	6.2
	N44	Road SE of lot 24	CLAY	UTP	UTP	UTP	UTP	UTP	1.9289	1.5162	27.2	2.49	300	24.8	2.7	1.54	4.5
	N45	Lot 47	CLAY	UTP	UTP	UTP	UTP	UTP	1.9287	1.5526	24.2	4.81	300	25.9	2.7	1.54	3.6
	N46	Lot 1	CLAY	146	146	151	162	151	1.8628	1.3991	33.1	1.71	300	35.2	2.7	1.38	0.5
	N47	Lot 10	CLAY	189	189	>189	>189	>189	1.8219	1.3367	36.3	1.87	300	38.3	2.7	1.32	0.8
22/12/2016	N48	Lot 11	CLAY	UTP	UTP	UTP	UTP	UTP	1.8501	1.4081	31.4	3.55	300	33.7	2.7	1.38	2.1
	N49	Lot 23	CLAY	>189	>189	UTP	UTP	>189	1.9375	1.5395	25.9	3.09	300	24.0	2.7	1.56	4.6
	N50	Lot 55	CLAY	UTP	UTP	>189	>189	>189	1.9371	1.5397	25.8	3.15	300	18.3	2.7	1.64	9.4
	N51	Refer to site plan	CLAY	>194	>194	>194	>194	>194	1.9320	1.5459	25.0	4.06	250	27.3	2.7	1.52	2.3
30/12/2016	N52	Lot 55	CLAY	>194	>194	>194	>194	>194	1.9141	1.4981	27.8	2.83	200	27.3	2.7	1.50	3.3
	N53	Lot 1	CLAY	>194	>194	>194	>194	>194	1.9172	1.5182	26.2	3.81	200	30.2	2.7	1.48	1.0
9/01/2017	N54	Lot 24	CLAY	148	151	162	165	157	1.9105	1.5366	24.3	5.62	250	31.5	2.7	1.46	0.4

This report should only be reproduced in full.

Created By: TG
Checked By: TG
Authorised Signatory: 

Date: 5/12/2016
Date: 11/01/2017
Date: 11/01/2017



**CATO BOLAM
CONSULTANTS**

SURVEYORS PLANNERS ENGINEERS

CATO BOLAM CONSULTANTS LTD
19 Temposk Avenue
PO Box 157
Grenada 07000

phones 09-477 9272
fax 09-426 7331
email catobolam@catobolam.com

ORIGINAL SCALE
1 : 1500

DATE
12/04/2015

DIRECTORY
2,38147-ACAD

ORIGINAL SIZE
A3

CAD REFERENCE
34147 E101 Car Park

REVISION NO
R1

SHEET NO
E104

JOB NO
34147

LF11 Rev 4 Soil Field Density NDM Direct Transmission with VSS Report

Auckland Laboratory
CMW Geosciences (NZ) Limited
Building C, 9 Piermark Drive, Rosedale, NZ 0632
PO Box 300206, Albany, Auckland, NZ 0752
Phone: +64 (09) 4144 632

Project: 29 Dinning Road, Riverhead
Project No: AKL2016_0326
Location: Riverhead
Report No: AKL2016_0326LAC Rev.0
Report Date: 22/08/2017
Client: Cabra Developments Limited
Client Address: PO Box 197, Orewa 0946
Client Reference:

Test Methods: NZS 4402.2.1:1986
Notes: Solid Density: Assumed
NZS 4407.4.2.2:2015
Testing Locations Selected By: CMW Field Staff
NZGS: August 2001



Tests indicated as not accredited are outside the scope of the laboratory's accreditation

Measurements marked * are not accredited and are outside the scope of the laboratories accreditation

Date Sampled	Sample No.	Test Location	Soil Description	In-situ Vane Shear Strengths					Field and Laboratory Testing Data								Comments	
				Test 1 (kPa)	Test 2 (kPa)	Test 3 (kPa)	Test 4 (kPa)	Ave.	Gauge Wet Density (t/m³)	Gauge Dry Density (t/m³)	Gauge Water Content (%)	Gauge Air Voids (%)	Gauge Probe Depth	Oven Water Content (%)	Solid Density (t/m³) *	Oven Dry Density (t/m³)		Calculated Air Voids (%) *
9/01/2017	N55	Lot 55	Stabilised CLAY	186	189	>189	>189	>188	1.9690	1.5147	30.0	-1.64	300	21.6	2.7	1.62	5.1	
	N56	Lot 57	CLAY	>189	>189	UTP	UTP	>189	2.0064	1.6191	23.9	1.21	300	22.1	2.7	1.64	2.8	
16/01/2017	N57	Lot 22	Sandy CLAY	UTP	UTP	UTP	UTP	UTP	1.9170	1.5581	23.0	6.32	300	22.8	2.7	1.56	6.6	
	N58	Lot 23	Sandy CLAY	UTP	UTP	UTP	UTP	UTP	1.9438	1.5680	24.0	4.26	300	21.5	2.7	1.60	6.4	
	N59	Refer to site plan	Sandy CLAY	UTP	UTP	UTP	UTP	UTP	1.8617	1.4583	27.7	5.56	300	24.2	2.7	1.50	8.2	
	N60	Lot 15	CLAY	UTP	UTP	UTP	UTP	UTP	2.0161	1.6339	23.4	1.18	300	23.1	2.7	1.64	1.5	
	25/01/2017	N61	Lot 55	CLAY	UTP	UTP	UTP	UTP	1.8953	1.4799	28.1	3.56	300	25.5	2.7	1.52	5.6	
	N62	Lot 25	CLAY	UTP	UTP	UTP	UTP	UTP	1.9342	1.5275	26.6	2.67	300	26.6	2.7	1.52	2.8	
	N63	Lot 26	CLAY	151	148	165	146	153	1.9638	1.5707	25.0	2.43	300	24.4	2.7	1.58	3.0	
	N64	Lot 53	CLAY	>189	>189	UTP	UTP	>189	2.0054	1.5871	26.4	-0.70	300	26.2	2.7	1.58	-0.5	
	N65	Lot 16	CLAY	>189	>189	UTP	UTP	>189	1.8715	1.4205	31.8	2.19	300	30.2	2.7	1.44	3.4	
	23/02/2017	N66	Lot 35	CLAY	>202	161	>202	180	>186	1.9624	1.5396	27.5	3.23	300	25.4	2.7	1.56	2.3
	N67	Lot 34	CLAY	>202	UTP	>202	>202	>202	1.9672	1.5840	24.2	5.63	300	24.8	2.7	1.58	2.6	
24/02/2017	N68	Lot 35	CLAY	>219	203	>219	197	>210	1.9279	1.5529	24.1	4.90	300	25.5	2.7	1.54	4.0	
	N69	Lot 36	CLAY	>219	188	156	172	>184	1.8431	1.4810	24.5	8.85	300	25.0	2.7	1.48	8.5	
27/02/2017	N70	Lot 35	CLAY	>219	>219	>219	>219	>219	1.9420	1.5675	23.9	4.41	300	27.0	2.7	1.52	2.1	
	N71	Lot 36	CLAY	>219	>219	>219	>219	>219	1.9601	1.5739	24.5	3.00	300	23.3	2.7	1.58	4.0	
26/04/2017	N72	Lot 51	CLAY	>185	158	161	156	>165	1.9305	1.5308	26.1	3.25	300	26.2	2.7	1.52	3.3	
	N73	Lot 49	CLAY	>185	143	>185	158	>168	1.8960	1.4924	27.0	4.27	300	28.1	2.7	1.48	3.6	

This report should only be reproduced in full.

Created By: TG Date: 10/01/2017
Checked By: TG Date: 22/08/2017
Authorised Signatory:  Date: 23/08/2017



Walkway amended, culvert added	GW	06/05/16
REVISION (DISCRIPTIONS)	NAME	DATE
SURVEYED	NAME	DATE
DESIGNED	GW	12/04/2016
DRAWN	GW	12/04/2016
CHECKED		
APPROVED		

CABRA DEVELOPMENTS LTD
29 DINNING ROAD
RIVERHEAD

PROPOSED
CUT AND FILL
CONTOURS

CATO BOLAM CONSULTANTS LTD		phone 09-427 0070	
19 Temamhi Avenue		fax 09-426 7331	
PO Box 157		email catobolam@catobolam.co.nz	
Dunedin 9106			

ORIGINAL SCALE 1 : 1500	ORIGINAL SIZE A3	REVISION NO R
DATE 12/04/2015	CAD REFERENCE 34142 E101 Cur Fell	SHEET NO E10
DIRECTORY 23/314 P ACAD		JOB NO 3414

Dynamic Cone Penetration (DCP) Test Report

NZS 4402: Test 6.5.2: 1988

Report No: AKL2016_0326LAD Rev. 0
Project Name: 29 Dinning Road
Project Location: Riverhead
Project Number: AKL2016_0326
Test Date: 13/01/2017
Tested By: JMI / MP
Client: Cabra Developments Limited
Client Address:
Client Reference:

Auckland Laboratory
CMW Geosciences (NZ) Limited
Building C, 9 Piermark Drive, Rosedale, NZ 0632
PO Box 300206, Albany, Auckland, NZ 0752
Phone: +64 (09) 4144 632

Testing Locations Selected By: CMW Field Staff



Tests indicated as not accredited are outside the scope of the laboratory's accreditation

Equivalent CBR Values are not accredited and are outside the scope of the laboratory's accreditation

Test No.	1		2		3		4		5	
Test Location	Road 2		Road 2		Road 2		Road 2		Road 2	
Chainage & Offset	CH20 Left		CH30 Right		CH40 Left		CH50 Right		CH60 Left	
Material & Layer:	CLAY / Subgrade		CLAY / Subgrade		CLAY / Subgrade		CLAY / Subgrade		CLAY / Subgrade	
Depth (mm)	Blow Count	Equiv CBR*	Blow Count	Equiv CBR*	Blow Count	Equiv CBR*	Blow Count	Equiv CBR*	Blow Count	Equiv CBR*
0 - 100	12	20+	8	18	5	13	4	8	11	20+
100 - 200	6	13	6	13	5	10	4	8	5	10
200 - 300	6	13	5	10	5	10	4	8	5	10
300 - 400	5	10	5	10	5	10	3	6	3	6
400 - 500	4	8	4	8	4	8	2	4	4	8
500 - 600	5	10	3	6	5	10	2	4	3	6
600 - 700	2	4	6	13	4	8	2	4	4	8
700 - 800	4	8	7	15	5	10	4	8	3	6
800 - 900	3	6	4	8	5	10	4	8	2	4
900 - 1000										
Test No.	6		7		8		9		10	
Test Location	Road 2		Road 2		Road 2		Road 2		Road 2	
Chainage & Offset	CH70 Right		CH80 Left		CH90 Right		CH100 Left		CH110 Right	
Material & Layer:	CLAY / Subgrade		CLAY / Subgrade		CLAY / Subgrade		CLAY / Subgrade		CLAY / Subgrade	
Depth	Blow Count	Equiv CBR*	Blow Count	Equiv CBR*	Blow Count	Equiv CBR*	Blow Count	Equiv CBR*	Blow Count	Equiv CBR*
0 - 100	4	8	8	18	15	20+	10	20+	14	20+
100 - 200	5	10	3	6	9	20	7	15	7	15
200 - 300	4	8	2	4	5	10	5	10	7	15
300 - 400	3	6	2	4	6	13	6	13	6	13
400 - 500	2	4	2	4	10	20+	7	15	5	10
500 - 600	2	4	2	4	9	20	5	10	4	8
600 - 700	2	4	2	4	5	10	5	10	6	13
700 - 800	2	4	2	4	3	6	11	20+	6	13
800 - 900	2	4	2	4	2	4	8	18	7	15
900 - 1000										

Prepared by: JMI
Checked by: TG
Authorised Signatory: Jack Myllett-Johnson
Date: 17/01/2017
Date: 5/04/2017
Date: 5/4/2017

This report should only be reproduced in full
*Equivalent CBR values calculated using AUSTROADS (2010) Guide to Pavement Technology Part 2, Figure 5.3, for Fine Grained Cohesive Soils, and are relevant to fine grained cohesive soils only.

LF14 Rev.7 Dynamic Cone Penetration (DCP) Test Report

NZS 4402: Test 6.5.2: 1988

Report No: AKL2016_0326LAD Rev. 0
Project Name: 29 Dinning Road
Project Location: Riverhead
Project Number: AKL2016_0326
Test Date: 13/01/2017
Tested By: JMJ / MP
Client: Cabra Developments Limited
Client Address:
Client Reference:

Auckland Laboratory
CMW Geosciences (NZ) Limited
Building C, 9 Piermark Drive, Rosedale, NZ 0632
PO Box 300206, Albany, Auckland, NZ 0752
Phone: +64 (09) 4144 632

Testing Locations Selected By: CMW Field Staff



Tests indicated as
not accredited are outside
the scope of the
laboratory's accreditation

Equivalent CBR Values are not accredited
and are outside the scope of the
laboratory's accreditation

Test No.	11		12		13		14		15	
Test Location	Road 2		Road 2		Road 2		Road 2		Road 2	
Chainage & Offset	CH120 Left		CH130 Right		CH140 Left		CH150 Right		CH160 Left	
Material & Layer:	Clay / Subgrade		CLAY / Subgrade		CLAY / Subgrade		CLAY / Subgrade		CLAY / Subgrade	
Depth (mm)	Blow Count	Equiv CBR*	Blow Count	Equiv CBR*	Blow Count	Equiv CBR*	Blow Count	Equiv CBR*	Blow Count	Equiv CBR*
0 - 100	17	20+	14	20+	5	10	15	20+	10	20+
100 - 200	14	20+	8	18	6	13	5	10	3	6
200 - 300	10	20+	6	13	3	6	3	6	2	4
300 - 400	6	13	4	8	3	6	2	4	3	6
400 - 500	6	13	4	8	2	4	3	6	2	4
500 - 600	4	8	2	4	3	6	3	6	3	6
600 - 700	4	8	2	4	2	4	2	4	2	4
700 - 800	4	8	2	4	2	4	3	6	2	4
800 - 900	4	8	2	4	2	4	2	4	2	4
900 - 1000										
Test No.	16		17		18		19		20	
Test Location	Road 2		Road 2		Road 2		Road 2		Road 2	
Chainage & Offset	CH170 Right		CH180 Left		CH190 Right		CH200 Left		CH210 Right	
Material & Layer:	CLAY / Subgrade		CLAY / Subgrade		CLAY / Subgrade		CLAY / Subgrade		CLAY / Subgrade	
Depth	Blow Count	Equiv CBR*	Blow Count	Equiv CBR*	Blow Count	Equiv CBR*	Blow Count	Equiv CBR*	Blow Count	Equiv CBR*
0 - 100	3	6	3	6	8	18	9	20	15	20+
100 - 200	1	2	1	2	3	6	5	10	6	13
200 - 300	1	2	1	2	2	4	4	8	4	8
300 - 400	2	4	2	4	1	2	4	8	2	4
400 - 500	1	2	2	4	2	4	3	6	3	6
500 - 600	2	4	2	4	2	4	4	8	2	4
600 - 700	1	2	2	4	1	2	1	2	2	4
700 - 800	1	2	2	4	2	4	2	4	2	4
800 - 900	2	4	2	4	2	4	2	4	2	4
900 - 1000										

Prepared by: JMJ Date: 17/01/2017
Checked by: TG Date: 5/04/2017
Authorised Signatory: *John Myer-Johnson* Date: 5/4/2017

This report should only be reproduced in full

*Equivalent CBR values calculated using AUSTROADS (2010) Guide to Pavement Technology Part 2, Figure 5.3, For Fine Grained Cohesive Soils, and are relevant to fine grained cohesive soils only.

LF14 Rev.7 Dynamic Cone Penetration (DCP) Test Report

NZS 4402: Test 6.5.2: 1988

Report No: AKL2016_0326LAD Rev. 0
Project Name: 29 Dinning Road
Project Location: Riverhead
Project Number: AKL2016_0326
Test Date: 13/01/2017
Tested By: JMJ / MP
Client: Cabra Developments Limited
Client Address:
Client Reference:

Auckland Laboratory
CMW Geosciences (NZ) Limited
Building C, 9 Piermark Drive, Rosedale, NZ 0632
PO Box 300206, Albany, Auckland, NZ 0752
Phone: +64 (09) 4144 632

Testing Locations Selected By: CMW Field Staff



Tests indicated as not accredited are outside the scope of the laboratory's accreditation

Equivalent CBR Values are not accredited and are outside the scope of the laboratory's accreditation

Test No.	21		22		23		24		25	
Test Location	Road 2		Road 2		Road 2		Road 2		Road 2	
Chainage & Offset	CH220 Left		CH230 Right		CH240 Left		CH250 Right		CH260 Left	
Material & Layer:	Clay / Subgrade		CLAY / Subgrade		CLAY / Subgrade		CLAY / Subgrade		CLAY / Subgrade	
Depth (mm)	Blow Count	Equiv CBR*	Blow Count	Equiv CBR*	Blow Count	Equiv CBR*	Blow Count	Equiv CBR*	Blow Count	Equiv CBR*
0 - 100	8	18	6	13	6	13	3	6	2	4
100 - 200	5	10	4	8	4	8	5	10	4	8
200 - 300	5	10	4	8	2	4	1	2	7	15
300 - 400	4	8	3	6	1	2	1	2	2	4
400 - 500	4	8	3	6	1	2	1	2	1	2
500 - 600	3	6	3	6	2	4	1	2	2	4
600 - 700	4	8	4	8	1	2	1	2	2	4
700 - 800	4	8	3	6	1	2	1	2	2	4
800 - 900	4	8	2	4	2	4	2	4	2	4
900 - 1000										

Test No.	26		27		28		29		30	
Test Location	Road 2		Road 2		Road 2		Road 2		Road 2	
Chainage & Offset	CH270 Right		CH280 Left		CH290 Right		CH300 Left		CH310 Right	
Material & Layer:	CLAY / Subgrade		CLAY / Subgrade		CLAY / Subgrade		CLAY / Subgrade		CLAY / Subgrade	
Depth	Blow Count	Equiv CBR*	Blow Count	Equiv CBR*	Blow Count	Equiv CBR*	Blow Count	Equiv CBR*	Blow Count	Equiv CBR*
0 - 100	10	20+	13	20+	6	13	4	8		
100 - 200	5	10	7	15	4	8	2	4		
200 - 300	4	8	5	10	4	8	3	6		
300 - 400	3	6	4	8	4	8	7	15		
400 - 500	2	4	3	6	4	8	6	13		
500 - 600	1	2	2	4	3	6	2	4		
600 - 700	2	4	2	4	3	6	2	4		
700 - 800	2	4	2	4	2	4	2	4		
800 - 900	2	4	2	4	2	4	2	4		
900 - 1000										

Prepared by: JMJ Date: 17/01/2017
Checked by: TG Date: 5/04/2017
Authorised Signatory: Jack Myerett-Johnson Date: 5/4/2017

This report should only be reproduced in full

*Equivalent CBR values calculated using AUSTRROADS (2010) Guide to Pavement Technology Part 2, Figure 5.3, For Fine Grained Cohesive Soils, and are relevant to fine grained cohesive soils only.

LF14 Rev.7 Dynamic Cone Penetration (DCP) Test Report

NZS 4402: Test 6.5.2: 1988

Report No:	AKL2016_0326LAD Rev. 0	Auckland Laboratory CMW Geosciences (NZ) Limited Building C, 9 Piermark Drive, Rosedale, NZ 0632 PO Box 300206, Albany, Auckland, NZ 0752 Phone: +64 (09) 4144 632
Project Name:	29 Dinning Road	
Project Location:	Riverhead	
Project Number:	AKL2016_0326	
Test Date:	13/01/2017	
Tested By:	JMJ / MP	Testing Locations Selected By: CMW Field Staff
Client:	Cabra Developments Limited	 Tests indicated as not accredited are outside the scope of the laboratory's accreditation Equivalent CBR Values are not accredited and are outside the scope of the laboratory's accreditation
Client Address:		
Client Reference:		

Test No.	31			32								
Test Location	Road 2			Road 2								
Chainage & Offset	CH320 Left			CH330 Right								
Material & Layer:	Clay / Subgrade			CLAY / Subgrade								
Depth (mm)	Blow Count	Equiv CBR*	Blow Count	Equiv CBR*	Blow Count	Equiv CBR*	Blow Count	Equiv CBR*	Blow Count	Equiv CBR*	Blow Count	Equiv CBR*
0 - 100	6	13	4	8								
100 - 200	3	6	1	2								
200 - 300	3	6	1	2								
300 - 400	3	6	9	20								
400 - 500	2	4	9	20								
500 - 600	2	4	6	13								
600 - 700	2	4	4	8								
700 - 800	1	2	2	4								
800 - 900	2	4	2	4								
900 - 1000												

Test No.												
Test Location												
Chainage & Offset												
Material & Layer:												
Depth	Blow Count	Equiv CBR*	Blow Count	Equiv CBR*	Blow Count	Equiv CBR*	Blow Count	Equiv CBR*	Blow Count	Equiv CBR*	Blow Count	Equiv CBR*
0 - 100												
100 - 200												
200 - 300												
300 - 400												
400 - 500												
500 - 600												
600 - 700												
700 - 800												
800 - 900												
900 - 1000												

Prepared by:	JMJ	Date:	17/01/2017	This report should only be reproduced in full *Equivalent CBR values calculated using AUSTROADS (2010) Guide to Pavement Technology Part 2, Figure 5.3, For Fine Grained Cohesive Soils, and are relevant to fine grained cohesive soils only.
Checked by:	TG	Date:	5/04/2017	
Authorised Signatory:	<i>Jack Myllett-Johnson</i>	Date:	5/4/2017	



REVISION (DESCRIPTIONS)	NAME	DATE
SURVEYED		
DESIGNED	GW	08/04/16
DRAWN	GW	08/04/16
CHECKED		
APPROVED		

CLIENT
CABRA DEVELOPMENTS LTD
29 DINNING ROAD
RIVERHEAD

DRAWING TITLE
ROAD LAYOUT

PO Box 157 Crewa 0946		fax 09-426 7331 email crotech@rotobolam.co.nz	
ORIGINAL SCALE 1:1500	ORIGINAL SIZE A3	REVISION NO	
DATE 08/04/2016	CAD REFERENCE 34147 E200 Roading	SHEET NO E200	
DIRECTORY Z:\34147\ACAD		JOB NO 34147	

LF14 Rev.7 Dynamic Cone Penetration (DCP) Test Report

NZS 4402: Test 6.5.2: 1988

Report No:	AKL2016_0326LAE Rev.0	Auckland Laboratory CMW Geosciences (NZ) Limited Building C, 9 Piermark Drive, Rosedale, NZ 0632 PO Box 300206, Albany, Auckland, NZ 0752 Phone: +64 (09) 4144 632
Project Name:	29 Dinning Road	
Project Location:	Riverhead	Testing Locations Selected By: CMW Field Staff
Project Number:	AKL2016_0326	
Test Date:	16/01/2017	 Tests indicated as not accredited are outside the scope of the laboratory's accreditation Equivalent CBR Values are not accredited and are outside the scope of the laboratory's accreditation
Tested By:	JMJ	
Client:	Cabris Developments Limited	
Client Address:		
Client Reference:		

Test No.	1		2		3		4		5	
Test Location	Road 1		Road 1		Road 1		Road 1		Road 1	
Chainage & Offset	CH10 Left		CH20 Right		CH30 Left		CH40 Right		CH50 Left	
Material & Layer:	CLAY / Subgrade		CLAY / Subgrade		CLAY / Subgrade		CLAY / Subgrade		CLAY / Subgrade	
Depth (mm)	Blow Count	Equiv CBR*	Blow Count	Equiv CBR*	Blow Count	Equiv CBR*	Blow Count	Equiv CBR*	Blow Count	Equiv CBR*
0 - 100	9	20	7	15	11	20+	8	18	6	13
100 - 200	10	20+	5	10	7	15	7	15	6	13
200 - 300	7	15	3	6	4	8	4	8	3	6
300 - 400	6	13	4	8	6	13	3	6	3	6
400 - 500	6	13	4	8	3	6	2	4	4	8
500 - 600	5	10	3	6	5	10	3	6	3	6
600 - 700	5	10	4	8	2	4	3	6	4	8
700 - 800	6	13	2	4	2	4	2	4	3	6
800 - 900	6	13	2	4	2	4	3	6	4	8
900 - 1000										

Test No.	6		7		8		9		10	
Test Location	Road 1		Road 1		Road 1		Road 1		Road 1	
Chainage & Offset	CH60 Right		CH70 Left		CH80 Right		CH90 Left		CH100 Right	
Material & Layer:	CLAY / Subgrade		CLAY / Subgrade		CLAY / Subgrade		CLAY / Subgrade		CLAY / Subgrade	
Depth	Blow Count	Equiv CBR*	Blow Count	Equiv CBR*	Blow Count	Equiv CBR*	Blow Count	Equiv CBR*	Blow Count	Equiv CBR*
0 - 100	5	10	11	20+	1	2	4	8	3	6
100 - 200	4	8	7	15	2	4	4	8	6	13
200 - 300	2	4	6	13	3	6	4	8	4	8
300 - 400	3	6	5	10	3	6	4	8	2	4
400 - 500	2	4	2	4	3	6	4	8	2	4
500 - 600	3	6	4	8	3	6	4	8	3	6
600 - 700	5	10	2	4	4	8	3	6	2	4
700 - 800	4	8	2	4	3	6	2	4	3	6
800 - 900	4	8	2	4	3	6	3	6	4	8
900 - 1000										

Prepared by: JMJ Date: 17/01/2017
 Checked by: TG Date: 5/04/2017
 Authorised Signatory: *Jack Myllett-Johnson* Date: 5/4/2017

This report should only be reproduced in full
 *Equivalent CBR values calculated using AUSTRROADS (2010) Guide to Pavement Technology Part 2, Figure 5.3, For Fine Grained Cohesive Soils, and are relevant to fine grained cohesive soils only.

LF14 Rev.7 Dynamic Cone Penetration (DCP) Test Report

NZS 4402: Test 6.5.2: 1988

Report No:	AKL2016_0326LAE Rev. 0	Auckland Laboratory CMW Geosciences (NZ) Limited Building C, 9 Piermark Drive, Rosedale, NZ 0632 PO Box 300206, Albany, Auckland, NZ 0752 Phone: +64 (09) 4144 632
Project Name:	29 Dinning Road	
Project Location:	Riverhead	
Project Number:	AKL2016_0326	
Test Date:	16/01/2017	
Tested By:	JMJ	Testing Locations Selected By: CMW Field Staff
Client:	Cabra Developments Limited	 Tests indicated as not accredited are outside the scope of the laboratory's accreditation Equivalent CBR Values are not accredited and are outside the scope of the laboratory's accreditation
Client Address:		
Client Reference:		

Test No.	11		12		13		14		15	
Test Location	Road 1		Road 1		Road 1		Road 1		Road 1	
Chainage & Offset	CH110 Left		CH120 Right		CH130 Left		CH140 Right		CH150 Left	
Material & Layer:	CLAY / Subgrade		CLAY / Subgrade		CLAY / Subgrade		CLAY / Subgrade		CLAY / Subgrade	
Depth (mm)	Blow Count	Equiv CBR*	Blow Count	Equiv CBR*	Blow Count	Equiv CBR*	Blow Count	Equiv CBR*	Blow Count	Equiv CBR*
0 - 100	10	20+	0	0	7	15	4	8	1	2
100 - 200	9	20	0	0	5	10	4	8	1	2
200 - 300	5	10	1	2	6	13	5	10	1	2
300 - 400	3	6	0	0	6	13	4	8	0	0
400 - 500	2	4	3	6	5	10	3	6	1	2
500 - 600	2	4	4	8	4	8	1	2	0	0
600 - 700	2	4	3	6	3	6	1	2	1	2
700 - 800	3	6	2	4	4	8	0	0	1	2
800 - 900	2	4	2	4	4	8	1	2	2	4
900 - 1000										

Test No.	16		17		18		19		20	
Test Location	Road 1		Road 1		Road 1		Road 1		Road 1	
Chainage & Offset	CH160 Right		CH170 Left		CH180 Right		CH190 Left		CH200 Right	
Material & Layer:	CLAY / Subgrade		CLAY / Subgrade		CLAY / Subgrade		CLAY / Subgrade		CLAY / Subgrade	
Depth	Blow Count	Equiv CBR*	Blow Count	Equiv CBR*	Blow Count	Equiv CBR*	Blow Count	Equiv CBR*	Blow Count	Equiv CBR*
0 - 100	7	15	7	15	5	10	12	20+	10	20+
100 - 200	3	6	4	8	8	18	10+	20+	6	13
200 - 300	2	4	2	4	4	8			17+	20+
300 - 400	2	4	3	6	4	8				
400 - 500	2	4	3	6	1	2				
500 - 600	3	6	4	8	1	2				
600 - 700	2	4	3	6	1	2				
700 - 800	2	4	3	6	1	2				
800 - 900	2	4	3	6	2	4				
900 - 1000										

Prepared by: <u>JMJ</u> Checked by: <u>TG</u> Authorised Signatory: <u>Jaide Mynett-Johnson</u>	Date: <u>17/01/2017</u> Date: <u>5/04/2017</u> Date: <u>5/4/2017</u>	This report should only be reproduced in full * Equivalent CBR values calculated using AUSTROADS (2010) Guide to Pavement Technology Part 2, Figure 5.3, For Fine Grained Cohesive Soils, and are relevant to fine grained cohesive soils only. Page 2 of 3
---	--	---

LF14 Rev.7 Dynamic Cone Penetration (DCP) Test Report

NZS 4402: Test 6.5.2: 1988

Report No:	AKL2016_0326LAF Rev. 0	Auckland Laboratory CMW Geosciences (NZ) Limited Building C, 9 Piermark Drive, Rosedale, NZ 0632 PO Box 300206, Albany, Auckland, NZ 0752 Phone: +64 (09) 4144 632	
Project Name:	29 Dinning Road		
Project Location:	Riverhead		
Project Number:	AKL2016_0326		
Test Date:	16/01/2017		
Tested By:	JMJ	Testing Locations Selected By: CMW Field Staff	
Client:	Cabra Developments Limited	 Tests indicated as not accredited are outside the scope of the laboratory's accreditation Equivalent CBR Values are not accredited and are outside the scope of the laboratory's accreditation	
Client Address:			
Client Reference:			

Test No.	1		2		3		4		5	
Test Location	Dinning Road		Dinning Road		Dinning Road		Dinning Road		Dinning Road	
Chainage & Offset	CH260 Left		CH270 Right		CH280 Left		CH290 Right		CH300 Left	
Material & Layer:	CLAY / Subgrade		CLAY / Subgrade		CLAY / Subgrade		CLAY / Subgrade		CLAY / Subgrade	
Depth (mm)	Blow Count	Equiv CBR*	Blow Count	Equiv CBR*	Blow Count	Equiv CBR*	Blow Count	Equiv CBR*	Blow Count	Equiv CBR*
0 - 100	4	8	9	20	8	18	9	20	10	20+
100 - 200	3	6	5	10	6	13	8	18	10+	20+
200 - 300	3	6	4	8	2	4	8	18		
300 - 400	3	6	4	8	2	4	9	20		
400 - 500	3	6	4	8	4	8	6	13		
500 - 600	4	8	2	4	7	15	6	13		
600 - 700	4	8	3	6	5	10	4	8		
700 - 800	4	8	3	6	5	10	2	4		
800 - 900	4	8	4	8	6	13	2	4		
900 - 1000										

Test No.	6		7		8		9		10	
Test Location	Dinning Road		Dinning Road		Dinning Road		Dinning Road		Dinning Road	
Chainage & Offset	CH310 Right		CH320 Left		CH330 Right		CH340 Left		CH350 Right	
Material & Layer:	CLAY / Subgrade		CLAY / Subgrade		CLAY / Subgrade		CLAY / Subgrade		CLAY / Subgrade	
Depth	Blow Count	Equiv CBR*	Blow Count	Equiv CBR*	Blow Count	Equiv CBR*	Blow Count	Equiv CBR*	Blow Count	Equiv CBR*
0 - 100	7	15	7	15	10	20+	10+	20+	12	20+
100 - 200	4	8	5	10	6	13			8	18
200 - 300	3	6	4	8	5	10			4	8
300 - 400	3	6	3	6	4	8			3	6
400 - 500	4	8	4	8	5	10			4	8
500 - 600	4	8	4	8	4	8			3	6
600 - 700	4	8	2	4	3	6			2	4
700 - 800	4	8	3	6	2	4			2	4
800 - 900	4	8	2	4	1	2			2	4
900 - 1000										

Prepared by: JMJ Checked by: TG Authorised Signatory: <i>Jack Myer-T-Johnson</i>	Date: 17/01/2017 Date: 5/04/2017 Date: 5/4/2017	This report should only be reproduced in full *Equivalent CBR values calculated using AUSTRROADS (2010) Guide to Pavement Technology Part 2, Figure 5.3, For Fine Grained Cohesive Soils, and are relevant to fine grained cohesive soils only. Page 1 of 3
--	---	---

LF14 Rev.7 Dynamic Cone Penetration (DCP) Test Report

NZS 4402: Test 6.5.2: 1988

Report No:	AKI2016_0326LAF Rev. 0	Auckland Laboratory CMW Geosciences (NZ) Limited Building C, 9 Piermark Drive, Rosedale, NZ 0632 PO Box 300206, Albany, Auckland, NZ 0752 Phone: +64 (09) 4144 632	
Project Name:	29 Dinning Road		
Project Location:	Riverhead		
Project Number:	AKI2016_0326		
Test Date:	16/01/2017	Testing Locations Selected By: CMW Field Staff	
Tested By:	JMJ		
Client:	Cabra Developments Limited	 Tests indicated as not accredited are outside the scope of the laboratory's accreditation Equivalent CBR Values are not accredited and are outside the scope of the laboratory's accreditation	
Client Address:			
Client Reference:			

Test No.	11		12		13		14		15	
Test Location	Dinning Road		Dinning Road		Dinning Road		Dinning Road		Dinning Road	
Chainage & Offset	CH360 Left		CH370 Right		CH380 Left		CH390 Right		CH400 Left	
Material & Layer:	CLAY / Subgrade		CLAY / Subgrade		CLAY / Subgrade		CLAY / Subgrade		CLAY / Subgrade	
Depth (mm)	Blow Count	Equiv CBR*	Blow Count	Equiv CBR*	Blow Count	Equiv CBR*	Blow Count	Equiv CBR*	Blow Count	Equiv CBR*
0 - 100	10	20+	9	20	7	15	6	13	14	20+
100 - 200	11	20+	6	13	7	15	7	15	6	4
200 - 300	11	20+	3	6	9	20	4	8	2	4
300 - 400	8	18	2	4	7	15	2	4	2	4
400 - 500	7	15	2	4	5	10	3	6	2	4
500 - 600	4	8	5	10	3	6	2	4	2	4
600 - 700	5	10	5	10	3	6	2	4	2	4
700 - 800	6	13	5	10	2	4	2	4	2	4
800 - 900	6	13	4	8	2	4	2	4	2	4
900 - 1000										

Test No.	16		17							
Test Location	Dinning Road		Dinning Road							
Chainage & Offset	CH410 Right		CH420 Left							
Material & Layer:	CLAY / Subgrade		CLAY / Subgrade							
Depth	Blow Count	Equiv CBR*	Blow Count	Equiv CBR*	Blow Count	Equiv CBR*	Blow Count	Equiv CBR*	Blow Count	Equiv CBR*
0 - 100	7	15	4	8						
100 - 200	9	20	7	15						
200 - 300	4	8	6	13						
300 - 400	4	8	3	6						
400 - 500	3	6	2	4						
500 - 600	3	6	3	6						
600 - 700	2	4	2	4						
700 - 800	2	4	2	4						
800 - 900	2	4	2	4						
900 - 1000										

Prepared by: <u>JMJ</u> Date: <u>17/01/2017</u> Checked by: <u>TG</u> Date: <u>5/04/2017</u> Authorised Signatory: <u>Jack Myer-Johnson</u> Date: <u>5/4/2017</u>				This report should only be reproduced in full *Equivalent CBR values calculated using AUSTRROADS (2010) Guide to Pavement Technology Part 2, Figure 5.3, For Fine Grained Cohesive Soils, and are relevant to fine grained cohesive soils only. Page 2 of 3
---	--	--	--	---



REVISION (DESCRIPTIONS)	NAME	DATE
SURVEYED		
DESIGNED	GW	08/04/16
DRAWN	GW	08/04/16
CHECKED		
APPROVED		

CLIENT

CABRA DEVELOPMENTS LTD
 29 DINNING ROAD
 RIVERHEAD

DRAWING TITLE

ROAD LAYOUT

PO Box 157
 Orewa 0946

fax 09-426 7331
 email catabolam@catabolam.co.nz

ORIGINAL SCALE 1:1500	ORIGINAL SIZE A3	REVISION NO
DATE 08/04/2016	CAD REFERENCE 34147 E200 Roading	SHEET NO E200
DIRECTORY Z:\34147\ACAD		JOB NO 34147

LF14 Rev.7 Dynamic Cone Penetration (DCP) Test Report

NZS 4402: Test 6.5.2: 1988

Report No: AKL2016_0326LAG Rev.0
Project Name: 29 Dinning Road
Project Location: Riverhead
Project Number: AKL2016_0326
Test Date: 3/02/2017
Tested By: AP / JMI
Client: Cabra Developments Limited
Client Address:
Client Reference:

Auckland Laboratory
CMW Geosciences (NZ) Limited
Building C, 9 Piermark Drive, Rosedale, NZ 0632
PO Box 300206, Albany, Auckland, NZ 0752
Phone: +64 (09) 4144 632

Testing Locations Selected By: CMW Field Staff



Tests indicated as not accredited are outside the scope of the laboratory's accreditation

Equivalent CBR Values are not accredited and are outside the scope of the laboratory's accreditation

Test No.	1		2		3		4		5	
Test Location	Road 3		Road 3		Road 3		Road 3		Road 3	
Chainage & Offset	CH10 Left		CH20 Right		CH30 Left		CH40 Right		CH50 Left	
Material & Layer:	CLAY		CLAY		CLAY		CLAY		CLAY	
Depth (mm)	Blow Count	Equiv CBR*	Blow Count	Equiv CBR*	Blow Count	Equiv CBR*	Blow Count	Equiv CBR*	Blow Count	Equiv CBR*
0 - 100	14	20+	6	13	7	15	10	20+	17	20+
100 - 200	7	15	5	10	5	10	5	10	6	13
200 - 300	6	13	3	6	4	8	3	6	5	10
300 - 400	3	6	3	6	3	6	3	6	3	6
400 - 500	2	4	3	6	2	4	3	6	3	6
500 - 600	2	4	3	6	3	6	2	4	2	4
600 - 700	2	4	2	4	1	2	2	4	3	6
700 - 800	2	4	3	6	2	4	2	4	3	6
800 - 900	4	8	2	4	2	4	2	4	2	4
900 - 1000	2	4	3	6	3	6	2	4	2	4
Test No.	6		7		8		9		10	
Test Location	Road 3		Road 3		Road 3		Road 3		Road 3	
Chainage & Offset	CH60 Right		CH70 Left		CH80 Right		CH90 Left		CH100 Right	
Material & Layer:	CLAY		CLAY		CLAY		CLAY		CLAY	
Depth	Blow Count	Equiv CBR*	Blow Count	Equiv CBR*	Blow Count	Equiv CBR*	Blow Count	Equiv CBR*	Blow Count	Equiv CBR*
0 - 100	12	20+	6	13	4	8	3	6	3	6
100 - 200	7	15	3	6	2	4	4	8	5	10
200 - 300	3	6	2	4	1	2	5	10	3	6
300 - 400	3	6	2	4	2	4	7	15	3	6
400 - 500	5	10	2	4	2	4	6	13	2	4
500 - 600	UTP	UTP	1	2	2	4	9	20	3	6
600 - 700			2	4	2	4	10	20+	5	10
700 - 800			2	4	2	4	11	20+	13+	20+
800 - 900			3	6	3	6	10	20+	UTP	UTP
900 - 1000			2	4	4	8	10	20+		

Prepared by: TG
Checked by: CS
Authorised Signatory: 

Date: 7/02/2017
Date: 7/02/2017
Date: 7/2/2017

This report should only be reproduced in full
*Equivalent CBR values calculated using AUSTRROADS (2010) Guide to Pavement Technology Part 2, Figure 5.3, For Fine Grained Cohesive Soils, and are relevant to fine grained cohesive soils only.

LF14 Rev.7 Dynamic Cone Penetration (DCP) Test Report

NZS 4402: Test 6.5.2: 1988

Report No: AKL2016_0326LAG Rev.0

Project Name: 29 Dinning Road

Project Location: Riverhead

Project Number: AKL2016_0326

Test Date: 3/02/2017

Tested By: AP / JMJ

Client: Cabra Developments Limited

Client Address:

Client Reference:

Auckland Laboratory
 CMW Geosciences (NZ) Limited
 Building C, 9 Piermark Drive, Rosedale, NZ 0632
 PO Box 300206, Albany, Auckland, NZ 0752
 Phone: +64 (09) 4144 632

Testing Locations Selected By: CMW Field Staff



Tests indicated as not accredited are outside the scope of the laboratory's accreditation

Equivalent CBR Values are not accredited and are outside the scope of the laboratory's accreditation

Test No.	11		12		13		14		15	
Test Location	Road 3		Road 3		Road 1		Road 1		Road 1	
Chainage & Offset	CH110 Left		CH120 Right		CH210 Left		CH220 Right		CH230 Left	
Material & Layer:	CLAY		CLAY		CLAY		CLAY		CLAY	
Depth (mm)	Blow Count	Equiv CBR*	Blow Count	Equiv CBR*	Blow Count	Equiv CBR*	Blow Count	Equiv CBR*	Blow Count	Equiv CBR*
0 - 100	4	8	5	10	5	10	9	20	7	15
100 - 200	2	4	3	6	5	10	7	15	6	13
200 - 300	3	6	5	10	2	4	6	13	3	6
300 - 400	3	6	4	8	1	2	3	6	2	4
400 - 500	4	8	3	6	1	2	2	4	2	4
500 - 600	6	13	4	8	2	4	2	4	1	2
600 - 700	7	15	4	8	2	4	2	4	2	4
700 - 800	6	13	4	8	2	4	2	4	1	2
800 - 900	10	20+	5	10	2	4	1	2	2	4
900 - 1000	10	20+	5	10	2	4	2	4	2	4

Test No.	16		17		18		19		20	
Test Location	Road 1		Road 1		Road 1		Road 1		Road 1	
Chainage & Offset	CH240 Right		CH250 Left		CH260 Right		CH270 Left		CH280 Right	
Material & Layer:	CLAY		CLAY		CLAY		CLAY		CLAY	
Depth	Blow Count	Equiv CBR*	Blow Count	Equiv CBR*	Blow Count	Equiv CBR*	Blow Count	Equiv CBR*	Blow Count	Equiv CBR*
0 - 100	10	20+	7	15	10	20+	11	20+	6	13
100 - 200	11	20+	7	15	11	20+	7	15	7	15
200 - 300	7	15	4	8	8	18	8	18	5	10
300 - 400	8	18	5	10	4	8	5	10	4	8
400 - 500	3	6	2	4	4	8	3	6	5	10
500 - 600	3	6	2	4	4	8	2	4	3	6
600 - 700	2	4	2	4	4	8	3	6	2	4
700 - 800	2	4	2	4	2	4	2	4	2	4
800 - 900	2	4	2	4	2	4	2	4	2	4
900 - 1000	2	4	2	4	2	4	2	4	2	4

Prepared by: TG

Date: 7/02/2017

Checked by: CS

Date: 7/02/2017

Authorised Signatory: 

Date: 7/2/2017

This report should only be reproduced in full

*Equivalent CBR values calculated using AUSTROADS (2010) Guide to Pavement Technology Part 2, Figure 5.3, For Fine Grained Cohesive Soils, and are relevant to fine grained cohesive soils only.

LF14 Rev.7 Dynamic Cone Penetration (DCP) Test Report

NZS 4402: Test 6.5.2: 1988

Report No: AKL2016_0326LAG Rev.0
Project Name: 29 Dinning Road
Project Location: Riverhead
Project Number: AKL2016_0326
Test Date: 3/02/2017
Tested By: AP / JMJ
Client: Cabra Developments Limited
Client Address:
Client Reference:

Auckland Laboratory
CMW Geosciences (NZ) Limited
Building C, 9 Piermark Drive, Rosedale, NZ 0632
PO Box 300206, Albany, Auckland, NZ 0752
Phone: +64 (09) 4144 632

Testing Locations Selected By: CMW Field Staff



Tests indicated as
not accredited are outside
the scope of the
laboratory's accreditation

Equivalent CBR Values are not accredited
and are outside the scope of the
laboratory's accreditation

Test No.	21		22		23		24		25	
Test Location	Road 1		Road 1		Road 1		Road 1		Road 1	
Chainage & Offset	CH290 Left		CH300 Right		CH310 Left		CH320 Right		CH330 Left	
Material & Layer:	CLAY		CLAY		CLAY		CLAY		CLAY	
Depth (mm)	Blow Count	Equiv CBR*	Blow Count	Equiv CBR*	Blow Count	Equiv CBR*	Blow Count	Equiv CBR*	Blow Count	Equiv CBR*
0 - 100	7	15	6	13	6	13	2	4	3	6
100 - 200	7	15	7	15	5	10	6	13	2	4
200 - 300	6	13	5	10	6	13	5	10	1	2
300 - 400	3	6	8	18	4	8	5	10	1	2
400 - 500	3	6	7	15	4	8	2	4	2	4
500 - 600	2	4	3	6	3	6	3	6	2	4
600 - 700	1	2	3	6	2	4	3	6	2	4
700 - 800	1	2	3	6	3	6	3	6	1	2
800 - 900	2	4	2	4	3	6	2	4	2	4
900 - 1000	2	4	2	4	2	4	2	4	2	4
Test No.	26		27							
Test Location	Road 1		Road 1							
Chainage & Offset	CH340 Right		CH360 Right							
Material & Layer:	CLAY		CLAY							
Depth	Blow Count	Equiv CBR*	Blow Count	Equiv CBR*	Blow Count	Equiv CBR*	Blow Count	Equiv CBR*	Blow Count	Equiv CBR*
0 - 100	5	10	4	8						
100 - 200	2	4	4	8						
200 - 300	3	6	4	8						
300 - 400	2	4	2	4						
400 - 500	2	4	3	6						
500 - 600	2	4	2	4						
600 - 700	2	4	2	4						
700 - 800	2	4	2	4						
800 - 900	1	2	2	4						
900 - 1000	2	4	2	4						

This report should only be reproduced in full

Prepared by: TG

Date: 7/02/2017

Checked by: CS

Date: 7/02/2017

Authorised Signatory: 


Date: 7/2/2017

*Equivalent CBR values calculated using AUSTROADS (2010) Guide to
Pavement Technology Part 2, Figure 5.3, For Fine Grained Cohesive Soils, and
are relevant to fine grained cohesive soils only.

NOTES

GENERAL

- The Contractor shall be responsible for locating all existing services prior to commencement of works. The Contractor shall make good at their own expense any damage to existing services.
- Levels are in terms of Auckland Vertical Datum 1946.
- All works are to be installed as per:
 - Rodney District Council's standards for 'Engineering Design & Construction'
 - Auckland Council Code of Practice for Land Development and Subdivision - Chapter 4 Stormwater
 - Watercare Services Ltd's 'Water and Wastewater Code of Practice for Land Development and Subdivision' and Accepted Materials List.
 - Auckland Transport's Code of Practice 'ATCOP'.
- Standard Drawings available from their respective websites or the Engineer.
- If discrepancies are found between the standards, confirmation shall be sought from the Engineer and supervising council field officers.

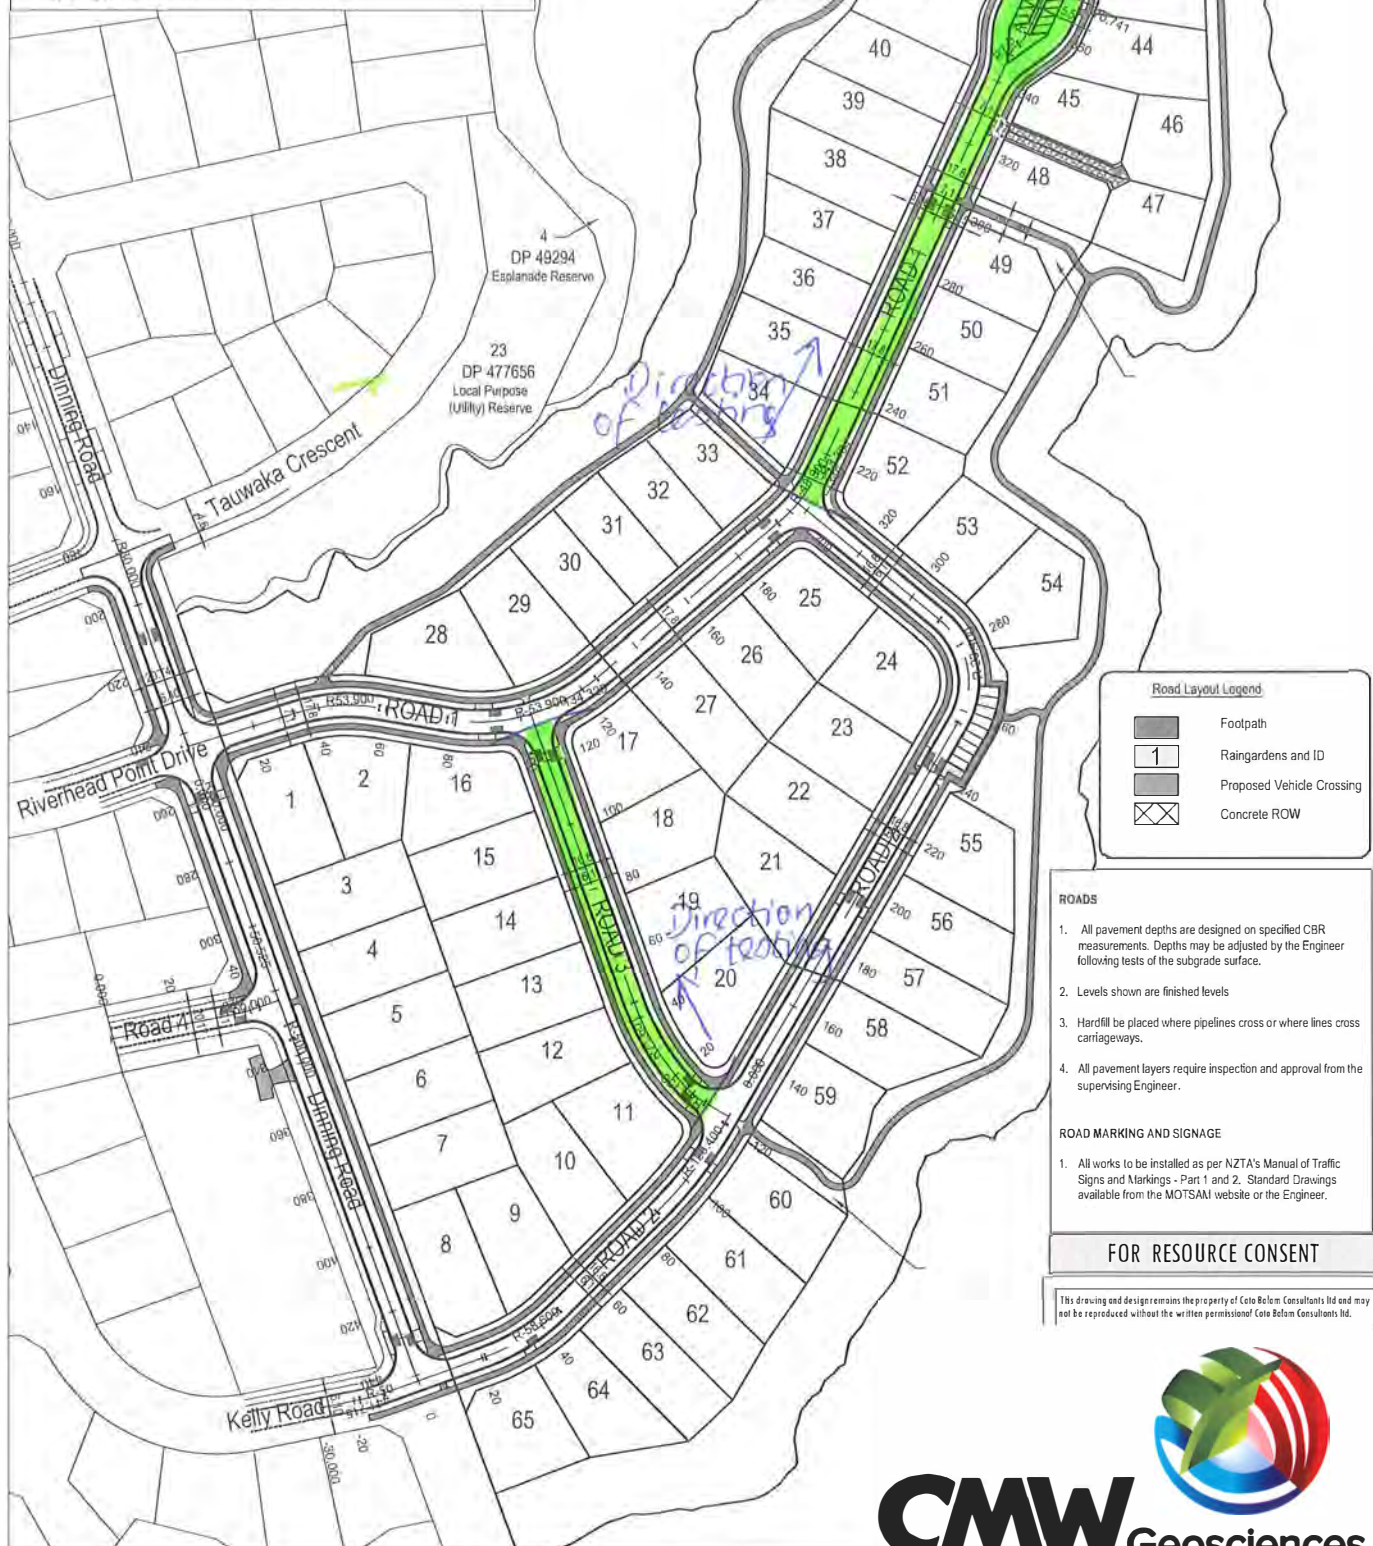

Road Layout Legend

- Footpath
- Raingardens and ID
- Proposed Vehicle Crossing
- Concrete ROW

ROADS

- All pavement depths are designed on specified CBR measurements. Depths may be adjusted by the Engineer following tests of the subgrade surface.
- Levels shown are finished levels
- Hardfill to be placed where pipelines cross or where lines cross carriageways.
- All pavement layers require inspection and approval from the supervising Engineer.

ROAD MARKING AND SIGNAGE

- All works to be installed as per NZTA's Manual of Traffic Signs and Markings - Part 1 and 2. Standard Drawings available from the MOTSAI website or the Engineer.

FOR RESOURCE CONSENT

This drawing and design remains the property of Cato Belem Consultants Ltd and may not be reproduced without the written permission of Cato Belem Consultants Ltd.

CMW Geosciences

REVISION (DESCRIPTIONS)	NAME	DATE
SURVEYED		
DESIGNED	GW	08/04/16
DRAWN	GW	08/04/16
CHECKED		
APPROVED		

CLIENT
CABRA DEVELOPMENTS LTD
29 DINNING ROAD
RIVERHEAD

DRAWING TITLE
ROAD LAYOUT

ORIGINAL SCALE	ORIGINAL SIZE	REVISION NO
1:1500	A3	
DATE	CAD REFERENCE	SHEET NO
08/04/2016	34147 E200 Roading	E200
DIRECTORY		JOB NO
24341147ACAD		34147

LF14 Rev.7 Dynamic Cone Penetration (DCP) Test Report

NZS 4402: Test 6.5.2: 1988

Report No:	ARL2016_0326LAH Rev.0	Auckland Laboratory CMW Geosciences (NZ) Limited Building C, 9 Piermark Drive, Rosedale, NZ 0632 PO Box 300206, Albany, Auckland, NZ 0752 Phone: +64 (09) 4144 632
Project Name:	29 Dimming Road	
Project Location:	Riverhead	
Project Number:	ARL2016_0326	
Test Date:	15/03/2017	
Tested By:	KP	Testing Locations Selected By: CMW Field Staff
Client:	Cabra Developments Limited	 Tests indicated as not accredited are outside the scope of the laboratory's accreditation Equivalent CBR Values are not accredited and are outside the scope of the laboratory's accreditation
Client Address:		
Client Reference:		

Test No.	1		2		3		4		5	
Test Location	Road 2		Road 2		Road 2		Road 2		Road 2	
Chainage & Offset	CH240 Right		CH245 Left		CH250 Right		CH255 Left		CH260 Right	
Material & Layer:	CLAY / Subgrade		CLAY / Subgrade		CLAY / Subgrade		CLAY / Subgrade		CLAY / Subgrade	
Depth (mm)	Blow Count	Equiv CBR*	Blow Count	Equiv CBR*	Blow Count	Equiv CBR*	Blow Count	Equiv CBR*	Blow Count	Equiv CBR*
0 - 100	10	20+	4	8	5	13	4	8	2	4
100 - 200	5	10	3	6	5	10	2	4	2	4
200 - 300	11	20+	2	4	4	8	2	4	3	6
300 - 400	14	20+	3	6	2	4	2	4	3	6
400 - 500	8	18	2	4	2	4	2	4	2	4
500 - 600	8	18	4	8	4	8	2	4	3	6
600 - 700	8	18	6	13	2	4	3	6	3	6
700 - 800	8	18	4	8	3	6	3	6	3	6
800 - 900	8	18	4	8	3	6	3	6	4	8
900 - 1000										

Test No.	6		7		8		9		10	
Test Location	Road 2		Road 2		Road 2		Road 2		Road 2	
Chainage & Offset	CH265 Left		CH270 Right		CH275 Left		CH280 Right		CH320 Left	
Material & Layer:	CLAY / Subgrade		CLAY / Subgrade		CLAY / Subgrade		CLAY / Subgrade		CLAY / Subgrade	
Depth	Blow Count	Equiv CBR*	Blow Count	Equiv CBR*	Blow Count	Equiv CBR*	Blow Count	Equiv CBR*	Blow Count	Equiv CBR*
0 - 100	2	4	5	10	4	8	7	15	6	13
100 - 200	3	6	3	6	2	4	3	6	4	8
200 - 300	5	10	2	4	3	6	4	8	3	6
300 - 400	3	6	4	8	3	6	4	8	2	4
400 - 500	2	4	3	6	3	6	3	6	4	8
500 - 600	3	6	3	6	3	6	2	4	2	4
600 - 700	4	8	4	8	2	4	2	4	3	6
700 - 800	2	4	2	4	2	4	2	4	2	4
800 - 900	2	4	2	4	2	4	2	4	4	8
900 - 1000										

Prepared by:	TG	Date:	16/03/2017
Checked by:	CS	Date:	16/03/2017
Authorised Signatory:		Date:	16/3/2017

This report should only be reproduced in full

*Equivalent CBR values calculated using AUSTRROADS (2010) Guide to Pavement Technology Part 2, Figure 5.3, For Fine Grained Cohesive Soils, and are relevant to fine grained cohesive soils only.

LF14 Rev.7 Dynamic Cone Penetration (DCP) Test Report

NZS 4402: Test 6.5.2: 1988

Report No:	AKL2016_0326LAH Rev.0	Auckland Laboratory CMW Geosciences (NZ) Limited Building C, 9 Piermark Drive, Rosedale, NZ 0632 PO Box 300205, Albany, Auckland, NZ 0752 Phone: +64 (09) 4144 632	
Project Name:	29 Dinning Road		
Project Location:	Riverhead		
Project Number:	AKL2016_0326		
Test Date:	15/03/2017		
Tested By:	KP	Testing Locations Selected By: CMW Field Staff	
Client:	Cabra Developments Limited	 Tests indicated as not accredited are outside the scope of the laboratory's accreditation Equivalent CBR Values are not accredited and are outside the scope of the laboratory's accreditation	
Client Address:			
Client Reference:			


Test No.	11		12		13		14		15	
Test Location	Road 2		Road 2		Road 1		Road 1		Road 1	
Chainage & Offset	CH330 Right		CH340 Left		CH180 Right		CH185 Left		CH190 Right	
Material & Layer:	CLAY / Subgrade		CLAY / Subgrade		CLAY / Subgrade		CLAY / Subgrade		CLAY / Subgrade	
Depth (mm)	Blow Count	Equiv CBR*	Blow Count	Equiv CBR*	Blow Count	Equiv CBR*	Blow Count	Equiv CBR*	Blow Count	Equiv CBR*
0 - 100	6	13	6	13	6	13	5	10	4	8
100 - 200	4	8	4	8	5	10	7	15	4	8
200 - 300	2	4	2	4	3	6	4	8	4	8
300 - 400	2	4	3	6	4	8	7	15	4	8
400 - 500	2	4	3	6	3	6	4	8	2	4
500 - 600	2	4	2	4	4	8	3	6	2	4
600 - 700	2	4	2	4	4	8	3	6	2	4
700 - 800	4	8	2	4	4	8	3	6	2	4
800 - 900	4	8	2	4	4	8	2	4	2	4
900 - 1000										

Test No.	16		17		18		19		20	
Test Location	Road 1		Road 1		Road 1		Road 1		Road 1	
Chainage & Offset	CH195 Left		CH200 Right		CH205 Left		CH210 Right		CH220 Left	
Material & Layer:	CLAY / Subgrade		CLAY / Subgrade		CLAY / Subgrade		CLAY / Subgrade		CLAY / Subgrade	
Depth	Blow Count	Equiv CBR*	Blow Count	Equiv CBR*	Blow Count	Equiv CBR*	Blow Count	Equiv CBR*	Blow Count	Equiv CBR*
0 - 100	6	13	5	10	4	8	6	13	4	8
100 - 200	8	18	3	6	3	6	6	13	4	8
200 - 300	4	8	2	4	2	4	5	10	3	6
300 - 400	5	10	3	6	4	8	3	6	2	4
400 - 500	5	10	2	4	2	4	2	4	3	6
500 - 600	5	10	2	4	2	4	3	6	2	4
600 - 700	5	10	3	6	2	4	2	4	3	6
700 - 800	5	10	3	6	2	4	2	4	2	4
800 - 900	4	8	4	8	2	4	2	4	2	4
900 - 1000										

Prepared by: TG
 Checked by: CS
 Authorised Signatory: 

Date: 16/03/2017
 Date: 16/03/2017
 Date: 16/3/2017

This report should only be reproduced in full
 *Equivalent CBR values calculated using AUSTROADS (2010) Guide to Pavement Technology Part 2, Figure 5.3, For Fine Grained Cohesive Soils, and are relevant to fine grained cohesive soils only.

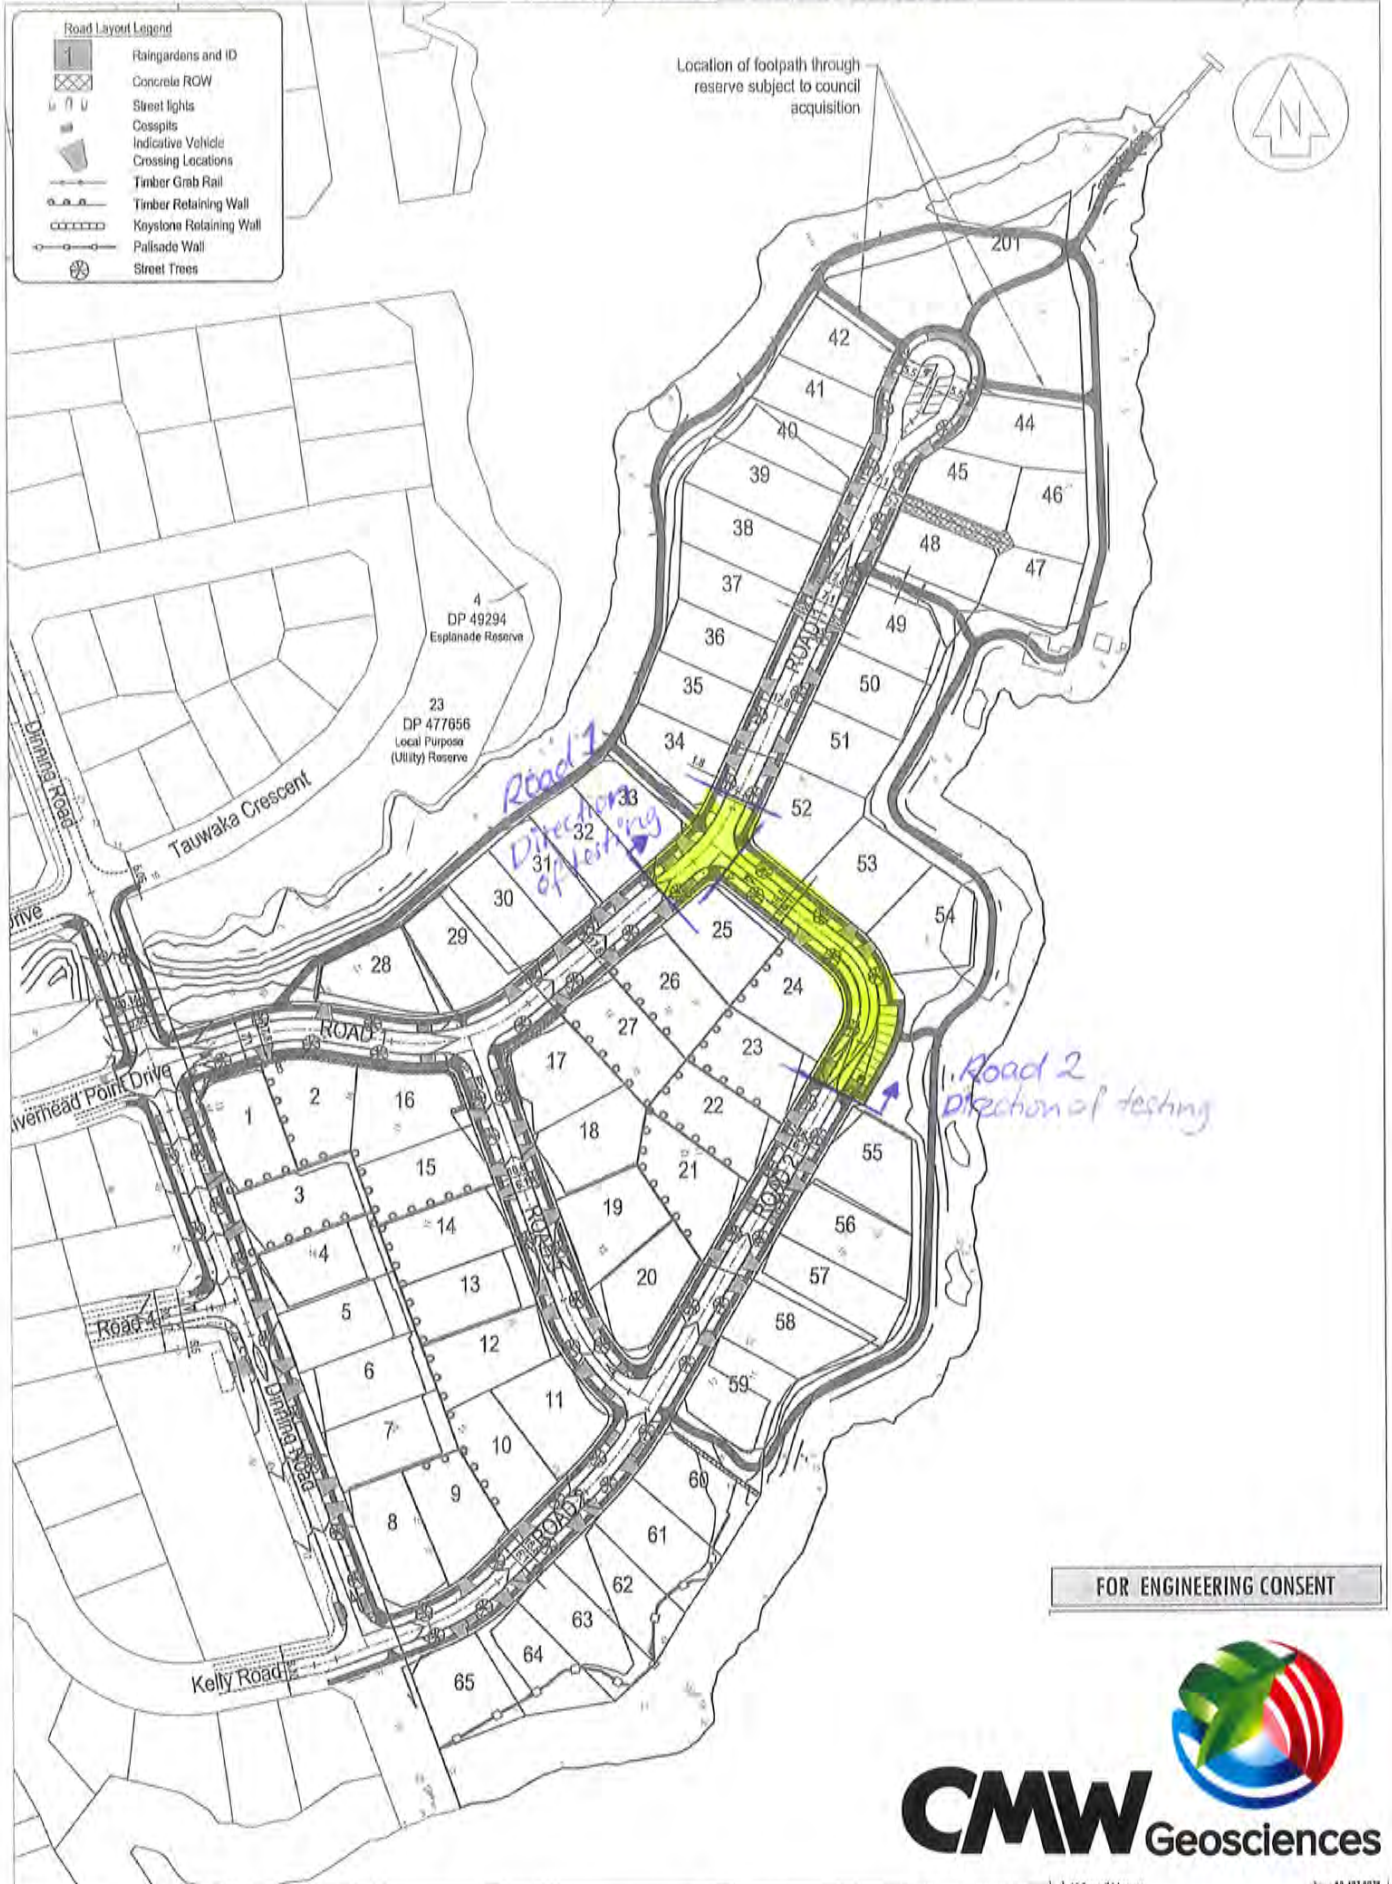

CMW Geosciences



RAI for Engineering Approval	GW	27/09/16
R5 Accessible car parks added, bdy amended	GW	17/09/16
R4 Keystone wall amended, Palisade added	GW	18/07/16
REVISION (DESCRIPTIONS)	NAME	DATE
SURVEYED	NAME	DATE
DESIGNED	GW	08/04/16
DRAWN	GW	08/04/16
CHECKED		
APPROVED		

CLIENT

CABRA DEVELOPMENTS LTD
29 DINNING ROAD
RIVERHEAD

DRAWING TITLE

ROAD LAYOUT

19 Tenenick Avenue
PO Box 157
Greene 0166

phone 01 437 8879
fax 01 434 7331
email c@cabraltd.co.nz

ORIGINAL SCALE	ORIGINAL SIZE	REVISION NO
1:1500	A3	R6
DATE	CAD REFERENCE	SHEET NO
08/04/2016	34147 E200 Reading	E200
DIRECTORY		JOB NO
6134147/LACAD		34147

Page 3 of 3

Appendix E

Producer Statements

17 October 2017

Ref: AKL2016_0326AG Rev.0

Cabra Properties Limited
PO Box 197
Orewa
Auckland 0946

Attention: Duncan Unsworth

Dear Duncan,

RE: CERTIFICATION FOR THE CONSTRUCTION OF TIMBER POLE RETAINING WALLS AND KEYSTONE WALLS AT 29 DINNING ROAD, RIVERHEAD - RMA R67504, ENG 60065935

CMW Geosciences (CMW) has visited the site at 29 Dinning Road, Riverhead, legally described as Lot 1 DP 124412, on numerous occasions during January 2017 through to June 2017 to observe the site works for the construction of timber pole and keystone retaining walls.

Our work has included review of the following documents and drawings:

- Engineering approval from Auckland Council referenced RMA R67504 and ENG 60065935, issued 25 November 2016;
- Geotechnical Retaining Wall Design Report for 26 Dinning Road, Riverhead prepared by CMW Geosciences, referenced AKL2016_0326 AD Rev.1, dated 25 October 2016.

The site works observed and/or tested by CMW staff incorporated:

- Timber pole retaining walls
 - Assessment of soil strengths in the exposed pile foundation excavations;
 - Pile size, depth, spacing and diameter;
 - Timber pole size, treatment and placement;
 - Lagging dimensions and placement;
 - Drainage material and installation.
- Keystone retaining walls
 - Assessment of soil strengths in the exposed foundation excavations;
 - Foundation dimensions;
 - Geogrid reinforcement placement (type, length, vertical spacing);
 - Hardfill compaction;
 - Drainage material and installation.

Construction aspects of the timber pole and keystone retaining walls were checked for the aforementioned points over numerous visits.

Compaction of the reinforced hardfill was checked by proof rolling on site to observe deflection under compaction and was tested using a NDM and an impact hammer.

Ground conditions were tested using a handheld shear vane in the bases and sides of the pile excavations. The retained soil was also tested as part of the observations. All ground conditions met or exceeded design specifications.

When water was observed in the pile excavations the contractor was advised to either tremie the concrete to the base of the excavation or remove the water immediately prior to pouring concrete. CMW were not present at the time of concrete pouring.

On the basis of our observations and testing, we consider that the works have been undertaken in accordance with the Resource Consent and related approved documentation described above and are in accordance with the requirements and/or recommendations of the geotechnical report.

For and on behalf of CMW Geosciences



Richard Knowles

Principal Geotechnical Engineer, CPEng

Attachments: Producer Statement - Construction Review

PRODUCER STATEMENT – PS4 – CONSTRUCTION REVIEW

(Guidance notes on the use of this form are printed on page 2)

ISSUED BY:R.J. KNOWLES of CMW GEOSCIENCES (NZ) LIMITED.....
(Construction Review Firm)

TO:CABRA PROPERTIES LIMITED
(Owner/Developer)

TO BE SUPPLIED TO:AUCKLAND COUNCIL.....
(Building Consent Authority)

IN RESPECT OF: ... CONSTRUCTION OF TIMBER POLE AND KEYSTONE RETAINING WALLS...
(Description of Building Work)

AT:29 DINNING ROAD, RIVERHEAD
(Address)

LOT..... 1 DP 124412 SO

.....CMW GEOSCIENCES..... has been engaged by CABRA PROPERTIES LIMITED
(Construction Review Firm)

To provide ☐ CM1 ☐ CM2 ☐ CM3 ☐ CM4 ☐ CM5 (Engineering Categories) or ☐ observation as per agreement with owner/developer

or ☒ other ...REFER TO ATTACHED DOCUMENT AKL2016_0326AG REV.0 DATED 17/10/2017.....services
(Extent of Engagement)

in respect of clause(s)B1..... of the Building Code for the building work described in

documents relating to Building Consent No. RMA R67504 and ENG 60065935..... and those relating to

Building Consent Amendment(s) Nos. N/A issued during the

course of the works. We have sighted these Building Consents and the conditions of attached to them.

Authorised instructions / variations(s) No. N/A..... (copies attached)

or by the attached Schedule ☐ have been issued during the course of the works.

On by the basis of ☒ this ☐ these review(s) and information supplied by the contractor during the course of the works and on behalf of the firm undertaking this Construction Review, I believe on reasonable grounds that ☒ All ☐ Part only of the building works have been completed in accordance with the relevant requirements of the Building Consent and Building Consent Amendments identified above, with respect to Clause(s)B1..... of the Building Code.

I also believe on reasonable grounds that the persons who have undertaken this construction review have the necessary competency to do so.

I,R. J. KNOWLES.....am: ☒ CPEng No. 160049 AUCKLAND COUNCIL AUTHOR #2342
(Name of Construction Review Professional)

☐ Reg Arch No.

I am a Member of : ☒ IPENZ ☐ NZIA and hold the following qualifications: BE(CIVIL), CPEng.....

The Construction Review Firm issuing this statement holds a current policy of Professional Indemnity Insurance no less than \$200,000*.

The Construction Review Firm is a member of ACENZ : ☐

SIGNED BY R. J. KNOWLES ON BEHALF OFCMW GEOSCIENCES (NZ) LIMITED.....

Date:..... 18/10/17 Signature:..... 

Note: This statement shall only be relied upon by the Building Consent Authority named above. Liability under this statement accrues to the Design Firm only. The total maximum amount of damages payable arising from this statement and all other statements provided to the Building Consent Authority in relation to this building work, whether in contract, tort or otherwise (including negligence), is limited to the sum of \$200,000*.

This form is to accompany Forms 6 or 8 of the Building (Form) Regulations 2004 for the issue of a Code Compliance Certificate.

THIS FORM AND ITS CONDITIONS ARE COPYRIGHT TO ACENZ, IPENZ AND NZIA

GUIDANCE ON USE OF PRODUCER STATEMENTS

Producer statements were first introduced with the Building Act 1991. The producer statements were developed by a combined task committee consisting of members of the New Zealand Institute of Architects, Institution of Professional Engineers New Zealand, Association of Consulting Engineers New Zealand in consultation with the Building Officials Institute of New Zealand. The original suit of producer statements has been revised at the date of this form as a result of enactment of the Building Act (2004) by these organisations to ensure standard use within the industry.

The producer statement system is intended to provide Building Consent Authorities (BCAs) with reasonable grounds for the issue of a Building Consent or a Code Compliance Certificate, without having to duplicate design or construction checking undertaken by others.

PS1 Design Intended for use by a suitably qualified independent design professional in circumstances where the BCA accepts a producer statement for establishing reasonable grounds to issue a Building Consent;

PS2 Design Review Intended for use by a suitably qualified independent design professional where the BCA accepts an independent design professional's review as the basis for establishing reasonable grounds to issue a Building Consent;

PS3 Construction Forms commonly used as a certificate of completion of building work are Schedule 6 of NZS 3910:2013 or Schedules E1/E2 of NZIA's SCC 2011²

PS4 Construction Review Intended for use by a suitably qualified independent design professional who undertakes construction monitoring of the building works where the BCA requests a producer statement prior to issuing a Code Compliance Certificate.

This must be accompanied by a statement of completion of building work (Schedule 6).

The following guidelines are provided by ACENZ, IPENZ and NZIA to interpret the Producer Statement.

Competence of Design Professional

This statement is made by a Design Firm that has undertaken a contract of services for the services named, and is signed by a person authorised by that firm to verify the processes within the firm and competence of its designers.

A competent design professional will have a professional qualification and proven current competence through registration on a national competence based register, either as a Chartered Professional Engineer (CPEng) or a Registered Architect.

Membership of a professional body, such as the Institution of Professional Engineers New Zealand (IPENZ) or the New Zealand Institute of Architects (NZIA), provides additional assurance of the designer's standing within the profession. If the design firm is a member of the Association of Consulting Engineers New Zealand (ACENZ), this provides additional assurance about the standing of the firm.

Persons or firms meeting these criteria satisfy the term "suitably qualified independent design professional".

*Professional Indemnity Insurance

As part of membership requirements, ACENZ requires all member firms to hold Professional Indemnity Insurance to a minimum level.

The PI Insurance minimum stated on the front of this form reflects standard, small projects. If the parties deem this inappropriate for large projects the minimum may be up to \$500,000.

Professional Services during Construction Phase

There are several levels of service which a Design Firm may provide during the construction phase of a project (CM1-CM5 for Engineers³). The Building Consent Authority is encouraged to require that the service to be provided by the Design Firm is appropriate for the project concerned.

Requirement to provide Producer Statement PS4

Building Consent Authorities should ensure that the applicant is aware of any requirement for producer statements for the construction phase of building work at the time the building consent is issued as no design professional should be expected to provide a producer statement unless such a requirement forms part of the Design firm's engagement.

Attached Particulars

Attached particulars referred to in this producer statement refer to supplementary information appended to the producer statement.

Refer Also:

- ¹ Conditions of Contract for Building & Civil Engineering Construction NZS 3910: 2013
- ² NZIA Standard Conditions of Contract SCC 2011
- ³ Guideline on the Briefing & Engagement for Consulting Engineering Services (ACENZ/IPENZ 2004)
- ⁴ PN Guidelines on Producer Statements

www.acenz.org.nz
www.ipenz.org.nz
www.nzia.co.nz



17 October 2017

Ref: AKL2016_0326AH Rev.0

Cabra Properties Limited
PO Box 197
Orewa
Auckland 0946

Attention: Duncan Unsworth

Dear Duncan,

RE: CERTIFICATION FOR THE CONSTRUCTION OF A PALISADE (IN-GROUND) WALL AT 29 DINNING ROAD, RIVERHEAD - RMA R67504, ENG 60065935

CMW Geosciences (CMW) have visited the site at 29 Dinning Road, Riverhead, legally described as Lot 1 DP124414, on multiple occasions during April 2017 to observe the site works for the construction of a palisade (in-ground) wall.

Our work has included review of the following documents and drawings:

- Engineering approval from Auckland Council referenced RMA R67504 and ENG 60065935, issued 25 November 2016;
- Geotechnical Palisade Retaining Wall Design Report for 26 Dinning Road, Riverhead prepared by CMW Geosciences, referenced AKL2016_0326 AC Rev.0, dated 1 July 2016.

The site works observed and/or tested by CMW staff incorporated:

- Assessment of soil strengths in the exposed pile hole excavations;
- Pile size, depth, spacing and diameter;
- Timber treatment and placement;

Our testing showed that ground conditions were in excess of the design assumptions of 100kPa, and embedment depth, spacing and diameter of pile holes were in accordance with the design. The offset of the palisade wall from the crest of the slope was greater than 2.0m.

On the basis of our observations and testing, we consider that the site works have been undertaken in accordance with the Resource Consent and related approved documentation described above and are in accordance with the requirements and/or recommendations of the geotechnical report.

For and on behalf of CMW Geosciences



Richard Knowles

Principal Geotechnical Engineer, CPEng

Attachments: Producer Statement - Construction Review

PRODUCER STATEMENT – PS4 – CONSTRUCTION REVIEW

(Guidance notes on the use of this form are printed on page 2)

ISSUED BY:R.J. KNOWLES of CMW GEOSCIENCES (NZ) LIMITED.....
(Construction Review Firm)TO:CABRA PROPERTIES LIMITED
(Owner/Developer)TO BE SUPPLIED TO:AUCKLAND COUNCIL.....
(Building Consent Authority)IN RESPECT OF: CONSTRUCTION OF A PALISADE (IN-GROUND) WALL.....
(Description of Building Work)AT:29 DINNING ROAD, RIVERHEAD
(Address)

LOT..... 1 DP124412..... SO

.....CMW GEOSCIENCES..... has been engaged by CABRA PROPERTIES LIMITED
(Construction Review Firm)To provide ☐ CM1 ☐ CM2 ☐ CM3 ☐ CM4 ☐ CM5 (Engineering Categories) or ☐ observation as per agreement with owner/developeror ☒ other ...REFER TO ATTACHED DOCUMENT AKL2016_0326AH REV.0 DATED 17/10/2017..... services
(Extent of Engagement)

in respect of clause(s) B1 of the Building Code for the building work described in

documents relating to Building Consent No. RMA R67504 and ENG 60065935..... and those relating to

Building Consent Amendment(s) Nos. N/A issued during the

course of the works. We have sighted these Building Consents and the conditions of attached to them.

Authorised instructions / variations(s) No. N/A (copies attached)

or by the attached Schedule ☐ have been issued during the course of the works.

On by the basis of ☒ this ☐ these review(s) and information supplied by the contractor during the course of the works and on behalf of the firm undertaking this Construction Review, I believe on reasonable grounds that ☒ All ☐ Part only of the building works have been completed in accordance with the relevant requirements of the Building Consent and Building Consent Amendments identified above, with respect to Clause(s) B1 of the Building Code.

I also believe on reasonable grounds that the persons who have undertaken this construction review have the necessary competency to do so.

I,R. J. KNOWLES..... am: ☒ CPEng No. 160049 AUCKLAND COUNCIL AUTHOR #2342
(Name of Construction Review Professional)


☐ Reg Arch No.

I am a Member of: ☒ IPENZ ☐ NZIA and hold the following qualifications: BE(CIVIL), CPEng.....

The Construction Review Firm issuing this statement holds a current policy of Professional Indemnity Insurance no less than \$200,000*.

The Construction Review Firm is a member of ACENZ: ☐

SIGNED BY R. J. KNOWLES ON BEHALF OF CMW GEOSCIENCES (NZ) LIMITED.....

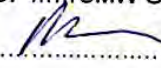Date: 18/10/17 Signature: 

Note: This statement shall only be relied upon by the Building Consent Authority named above. Liability under this statement accrues to the Design Firm only. The total maximum amount of damages payable arising from this statement and all other statements provided to the Building Consent Authority in relation to this building work, whether in contract, tort or otherwise (including negligence), is limited to the sum of \$200,000*.

This form is to accompany Forms 6 or 8 of the Building (Form) Regulations 2004 for the issue of a Code Compliance Certificate.

THIS FORM AND ITS CONDITIONS ARE COPYRIGHT TO ACENZ, IPENZ AND NZIA

GUIDANCE ON USE OF PRODUCER STATEMENTS

Producer statements were first introduced with the Building Act 1991. The producer statements were developed by a combined task committee consisting of members of the New Zealand Institute of Architects, Institution of Professional Engineers New Zealand, Association of Consulting Engineers New Zealand in consultation with the Building Officials Institute of New Zealand. The original suit of producer statements has been revised at the date of this form as a result of enactment of the Building Act (2004) by these organisations to ensure standard use within the industry.

The producer statement system is intended to provide Building Consent Authorities (BCAs) with reasonable grounds for the issue of a Building Consent or a Code Compliance Certificate, without having to duplicate design or construction checking undertaken by others.

PS1 Design Intended for use by a suitably qualified independent design professional in circumstances where the BCA accepts a producer statement for establishing reasonable grounds to issue a Building Consent;

PS2 Design Review Intended for use by a suitably qualified independent design professional where the BCA accepts an independent design professional's review as the basis for establishing reasonable grounds to issue a Building Consent;

PS3 Construction Forms commonly used as a certificate of completion of building work are Schedule 6 of NZS 3910:2013 or Schedules E1/E2 of NZIA's SCC 2011²

PS4 Construction Review Intended for use by a suitably qualified independent design professional who undertakes construction monitoring of the building works where the BCA requests a producer statement prior to issuing a Code Compliance Certificate.

This must be accompanied by a statement of completion of building work (Schedule 6).

The following guidelines are provided by ACENZ, IPENZ and NZIA to interpret the Producer Statement.

Competence of Design Professional

This statement is made by a Design Firm that has undertaken a contract of services for the services named, and is signed by a person authorised by that firm to verify the processes within the firm and competence of its designers.

A competent design professional will have a professional qualification and proven current competence through registration on a national competence based register, either as a Chartered Professional Engineer (CPEng) or a Registered Architect.

Membership of a professional body, such as the Institution of Professional Engineers New Zealand (IPENZ) or the New Zealand Institute of Architects (NZIA), provides additional assurance of the designer's standing within the profession. If the design firm is a member of the Association of Consulting Engineers New Zealand (ACENZ), this provides additional assurance about the standing of the firm.

Persons or firms meeting these criteria satisfy the term "suitably qualified independent design professional".

*Professional Indemnity Insurance

As part of membership requirements, ACENZ requires all member firms to hold Professional Indemnity Insurance to a minimum level.

The PI Insurance minimum stated on the front of this form reflects standard, small projects. If the parties deem this inappropriate for large projects the minimum may be up to \$500,000.

Professional Services during Construction Phase

There are several levels of service which a Design Firm may provide during the construction phase of a project (CM1-CM5 for Engineers³). The Building Consent Authority is encouraged to require that the service to be provided by the Design Firm is appropriate for the project concerned.

Requirement to provide Producer Statement PS4

Building Consent Authorities should ensure that the applicant is aware of any requirement for producer statements for the construction phase of building work at the time the building consent is issued as no design professional should be expected to provide a producer statement unless such a requirement forms part of the Design firm's engagement.

Attached Particulars

Attached particulars referred to in this producer statement refer to supplementary information appended to the producer statement.

Refer Also:

- ¹ Conditions of Contract for Building & Civil Engineering Construction NZS 3910: 2013
- ² NZIA Standard Conditions of Contract SCC 2011
- ³ Guideline on the Briefing & Engagement for Consulting Engineering Services (ACENZ/IPENZ 2004)
- ⁴ PN Guidelines on Producer Statements

www.acenz.org.nz
www.ipenz.org.nz
www.nzia.co.nz

